

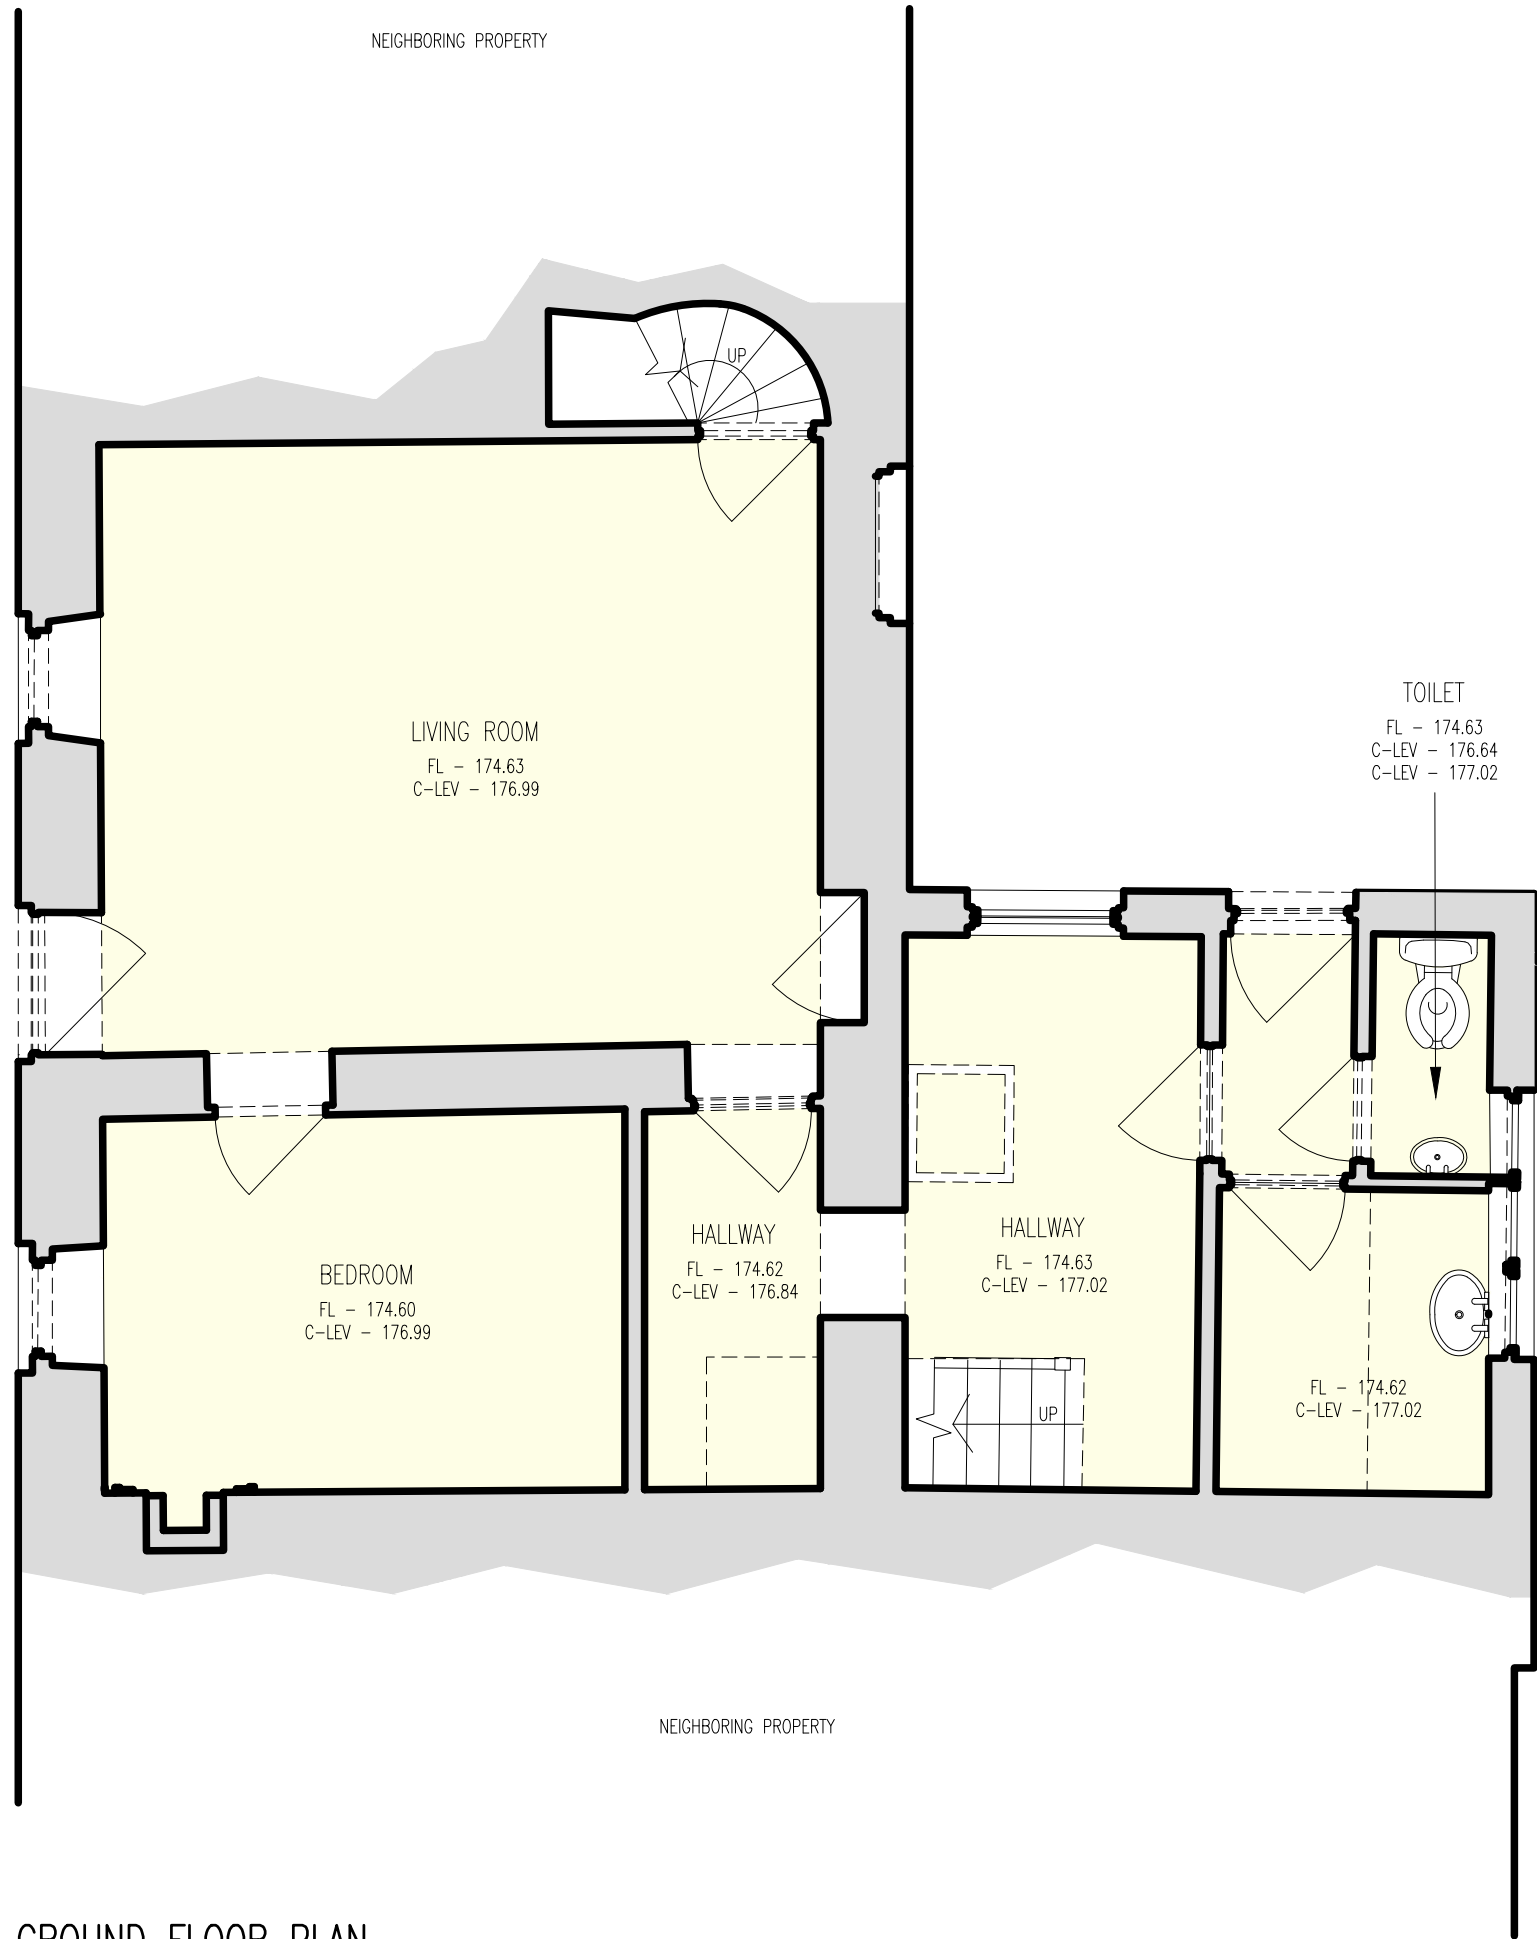


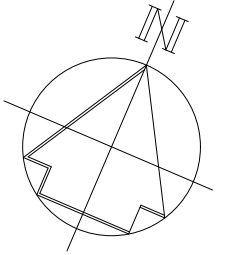

GROUND FLOOR PLAN
SCALE 1:50 @ A2

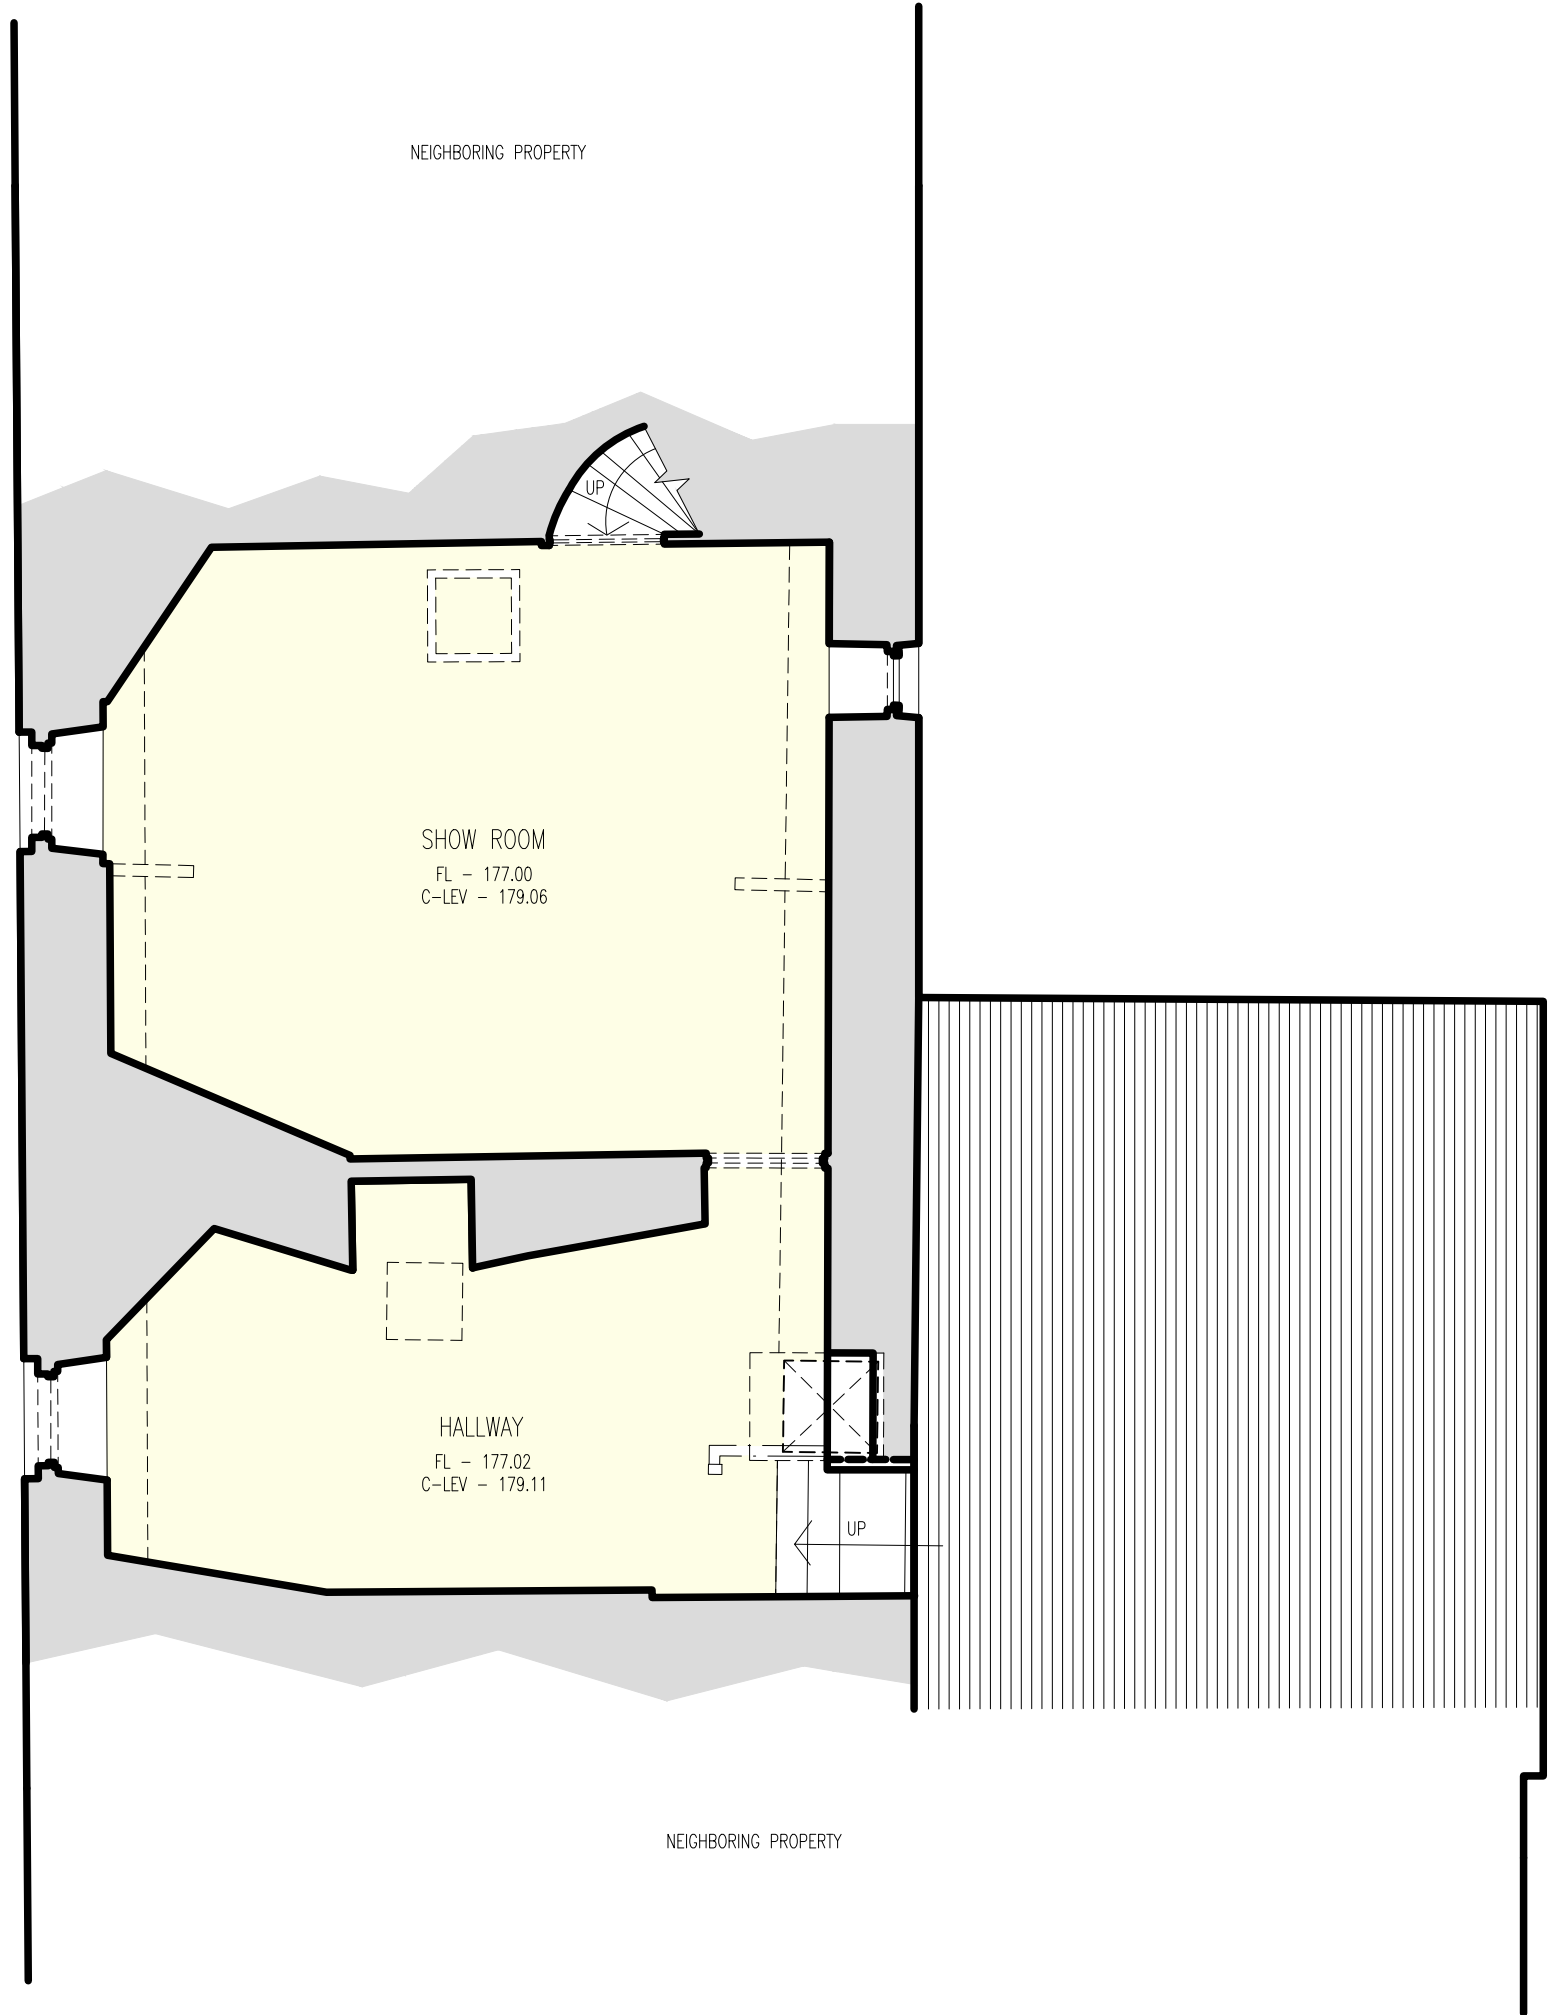

FISRT FLOOR PLAN
SCALE 1:50 @ A2

Job No: 25.64	Drawing No: A02	Rev: /	No. REVISION			No. REVISION		
			by date			by date		

NOTES	
1	Do not scale from this drawing
2	All dimensions to be checked on site
3	'As built' drawings are prepared, in part, based upon information furnished by others. While this information is believed to be reliable, James & Nicholas LLP assume no responsibility for the accuracy of 'As built' drawings or for any errors or omissions that may have been incorporated into them as a result of incorrect information provided to us by others. Those relying on an 'As built' drawing are advised to obtain independent verification of its accuracy.
STAGE	
COMMENT	

CLIENT

Cynghor Bwrdeistref Sirol
MERTHYR TYDFIL
County Borough Council

james&nicholas
Grove House, Grove Place, Port Talbot SA13 1XA • Tel 01639 885431 • Fax 01639 891687
admin@jamesandnicholas.com • www.jamesandnicholas.com
James & Nicholas Limited Liability Partnership. Registered in the UK No. OC303071

Job title
REFURB OF JOSEPH PARRY'S COTTAGE MUSEUM, MERTHYR TYD CBC

Drawing title
EXISTING PLANS

Job No:
25.64

Drawing No:
A02

Rev:
/

scales: 1:50 @ A2

COPYRIGHT ©

by		date
drawn	LD	09.09.25
checked		
approved		