
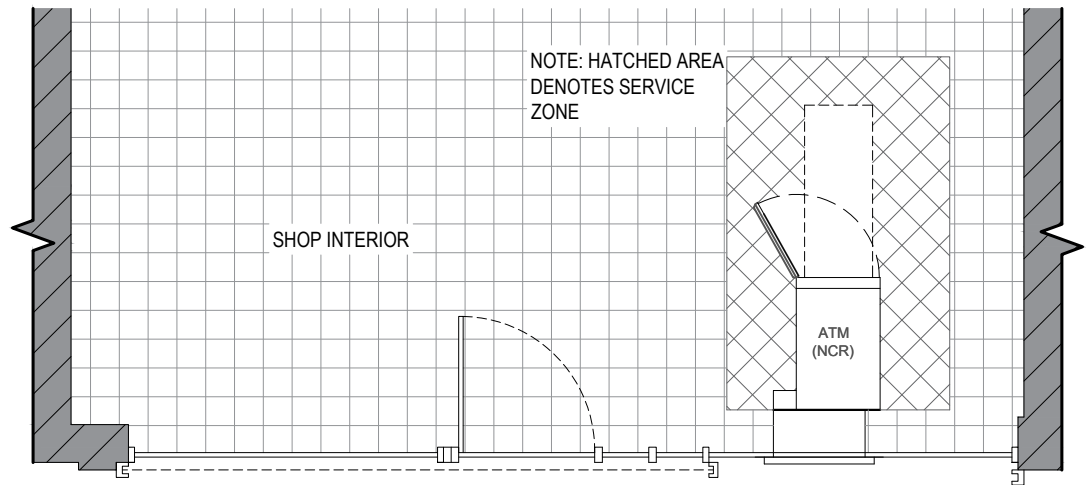
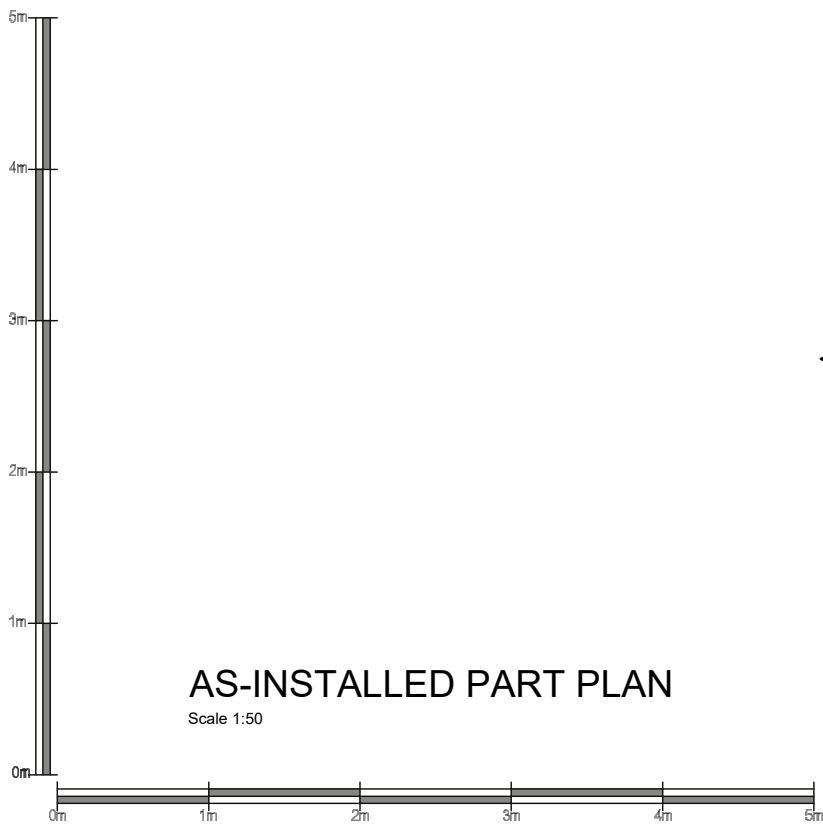
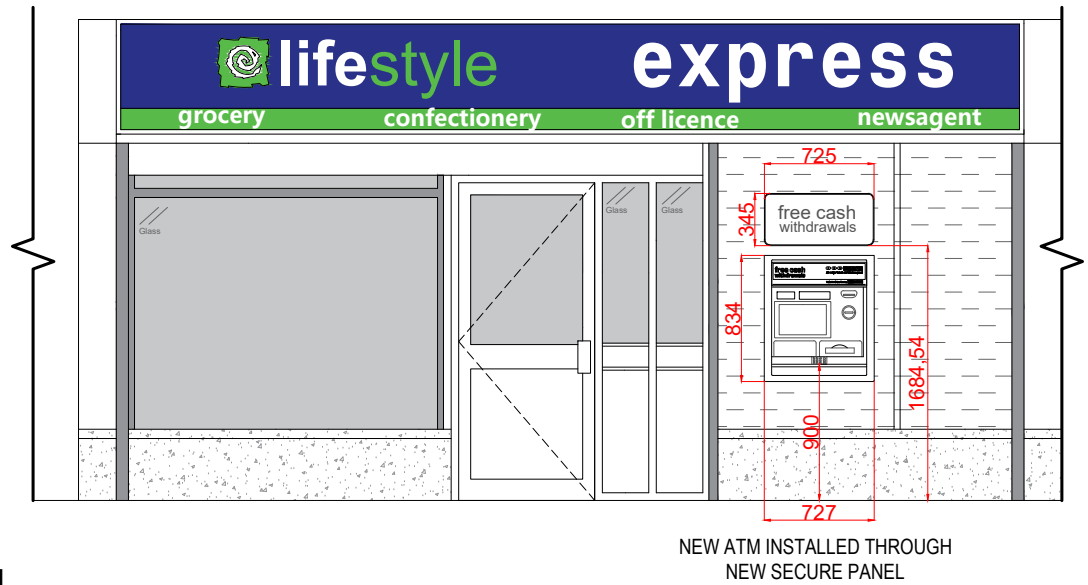


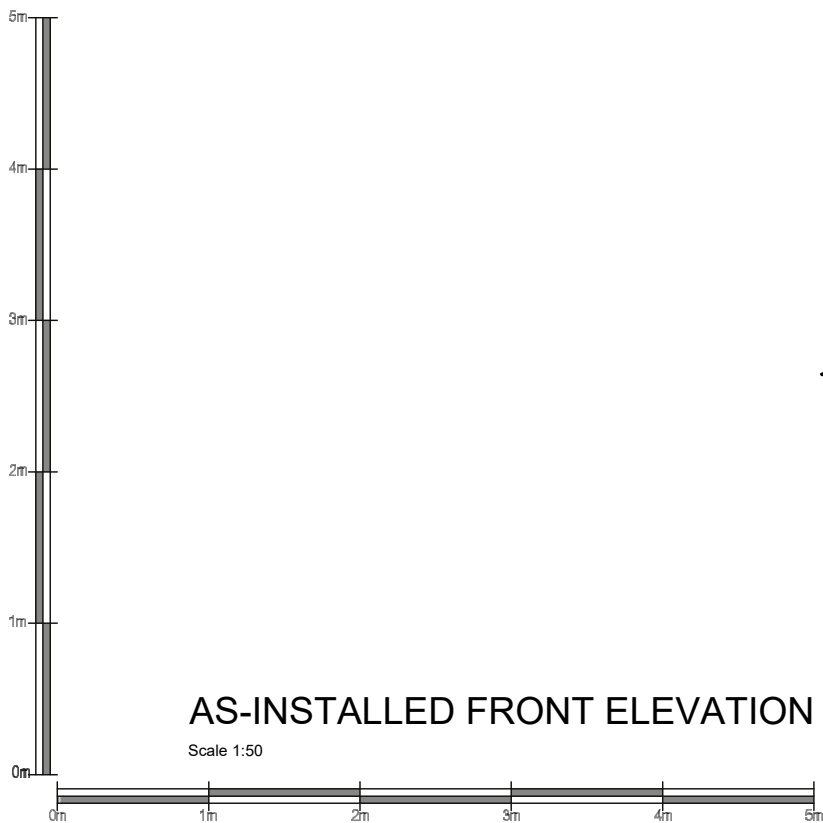

Date: Comments: By:

GENERAL NOTES:
1) All dimensions in millimeters unless otherwise stated.

Site:
Canton News,
23-25 BRIDGE STREET,
TROEDYRHIW,
MERTHYR TYDFIL,
CF48 4DT

Drawing Title:
As-Installed Plan and Elevation

Ref: T020640_AI	Date: 08/04/2022	Rev:
Scale: 1:50	Paper: A3	Date Rev: