




PRE CONVERSION FRONT ELEVATION

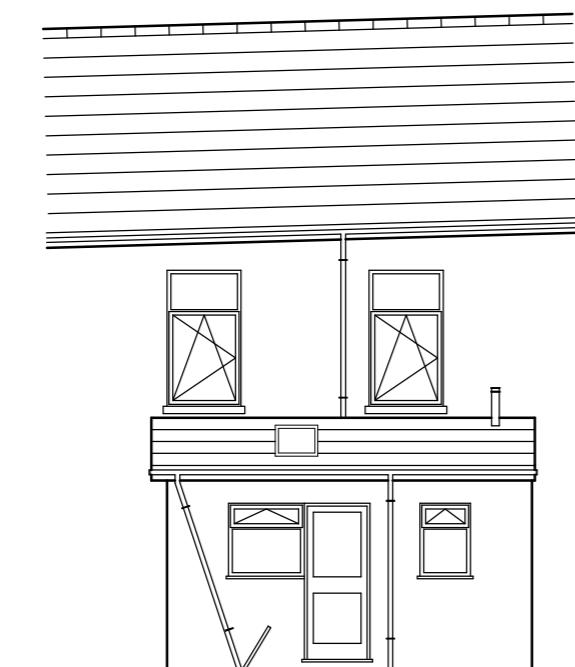


PRE CONVERSION REAR ELEVATION

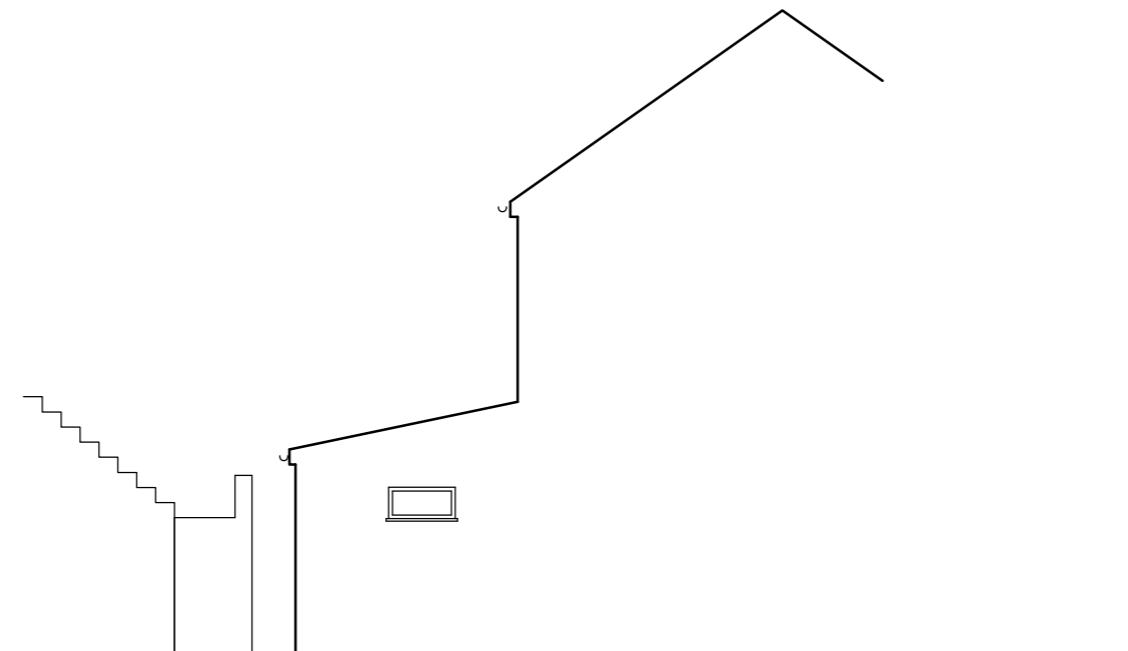


PRE CONVERSION SIDE ELEVATION

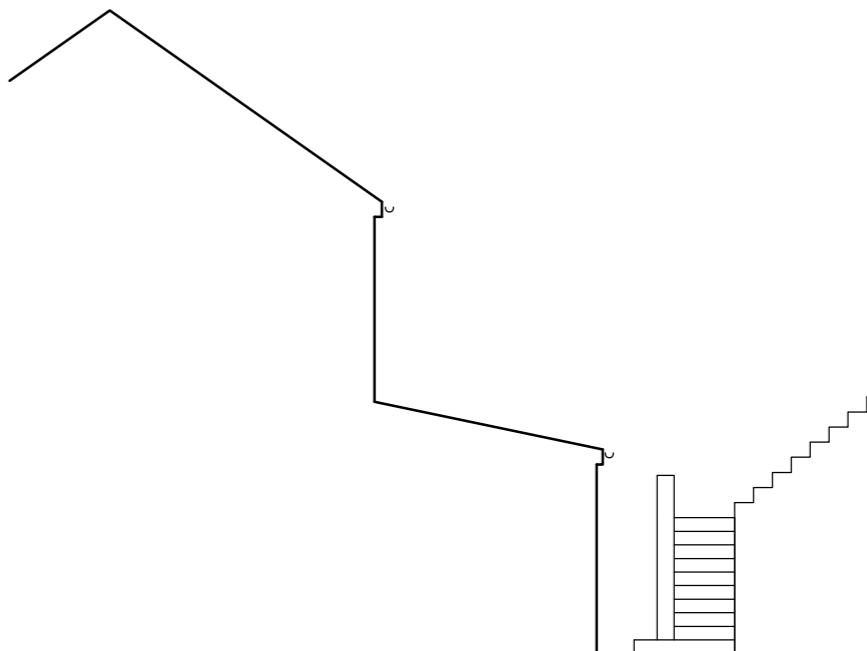


PRE CONVERSION SIDE ELEVATION

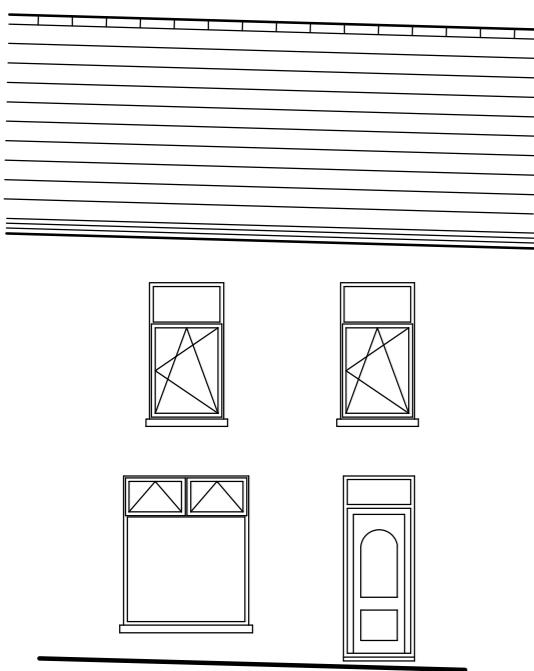


AS BUILT FRONT ELEVATION

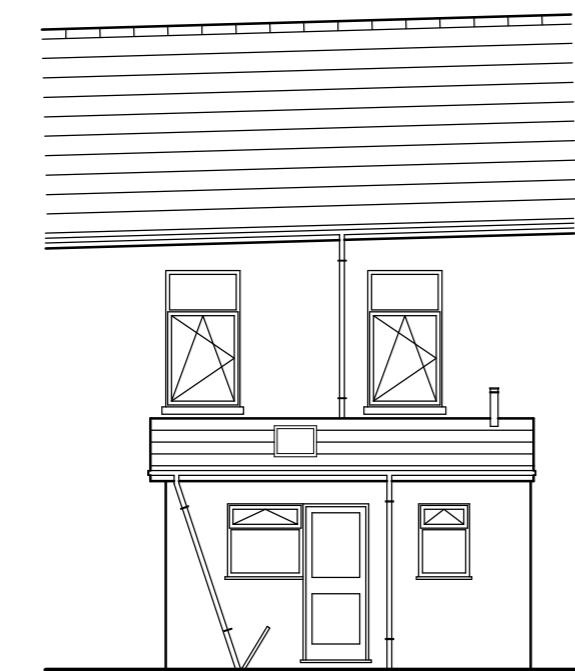


AS BUILT REAR ELEVATION

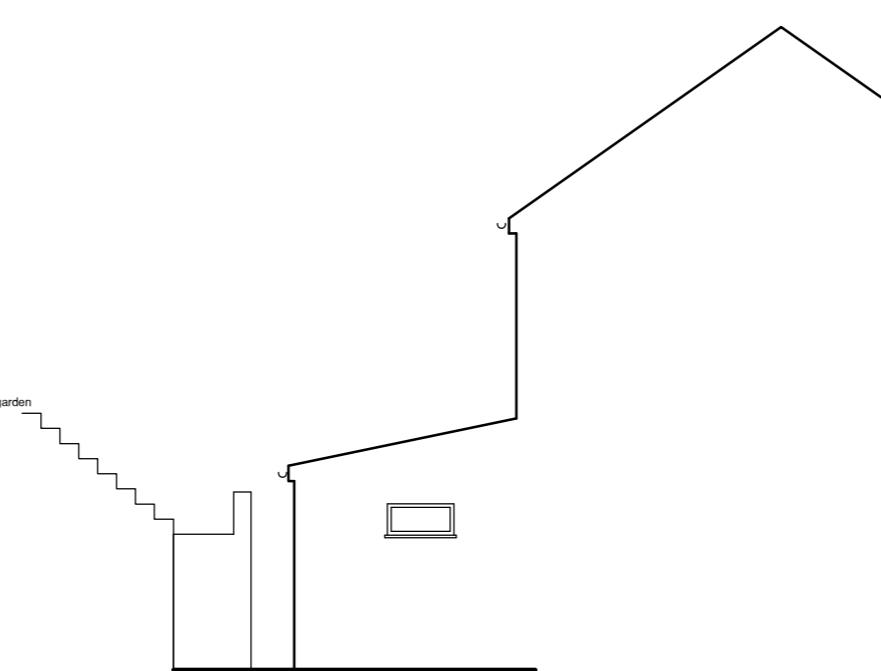


AS BUILT SIDE ELEVATION

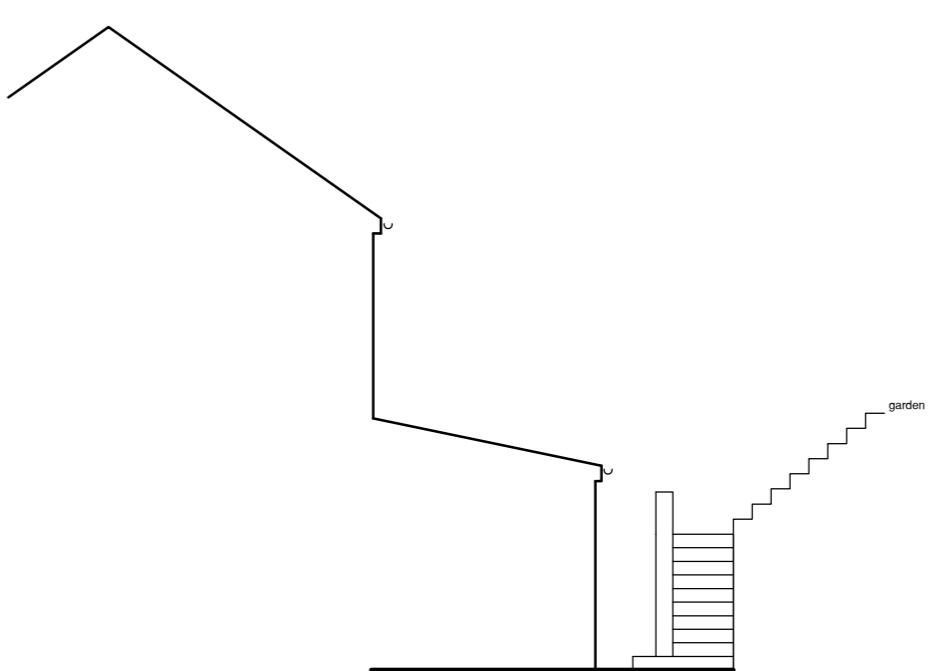


AS BUILT SIDE ELEVATION

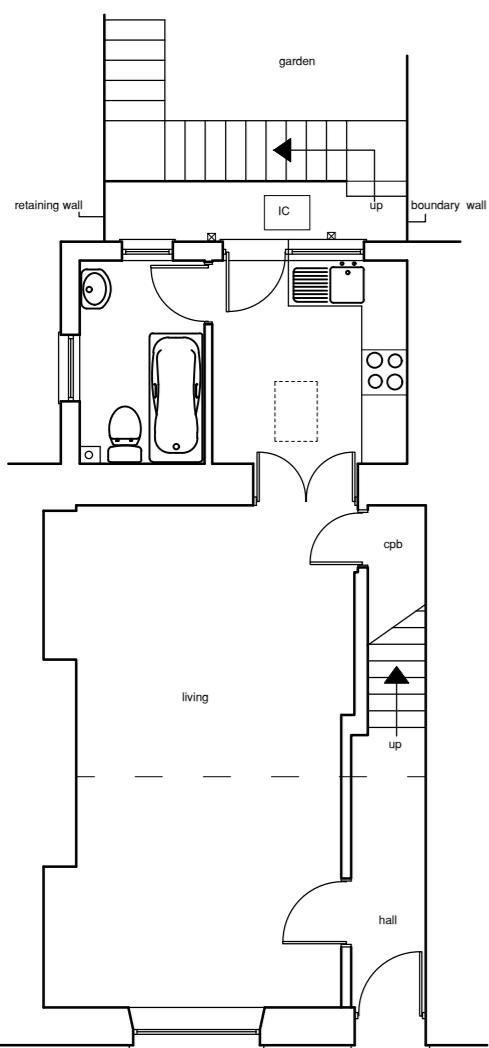


PRE CONVERSION GROUND FLOOR

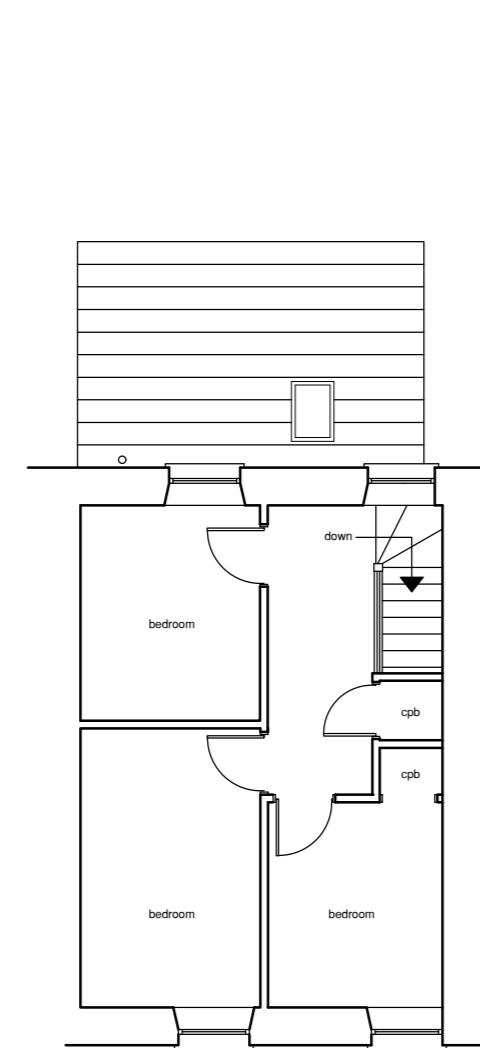

PRE CONVERSION FIRST FLOOR

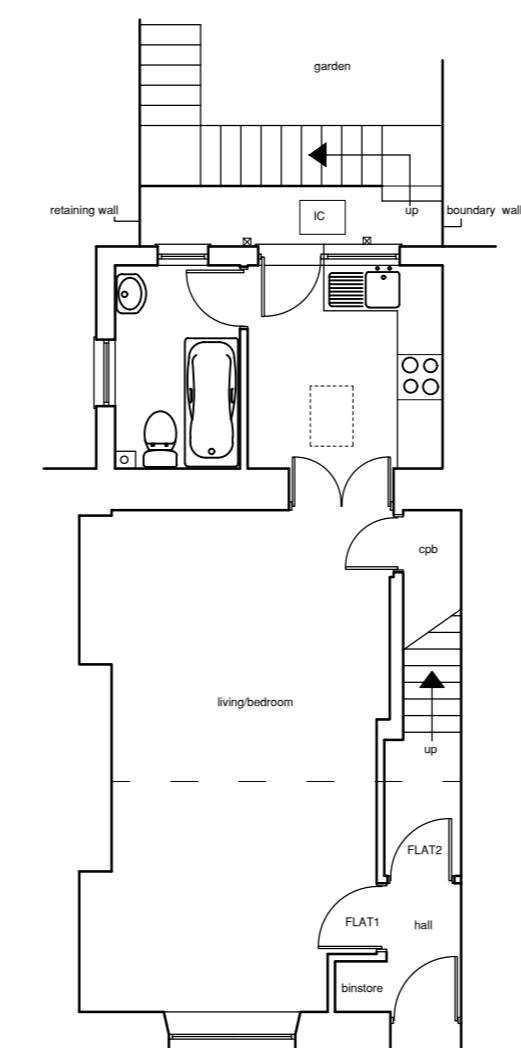

AS BUILT GROUND FLOOR

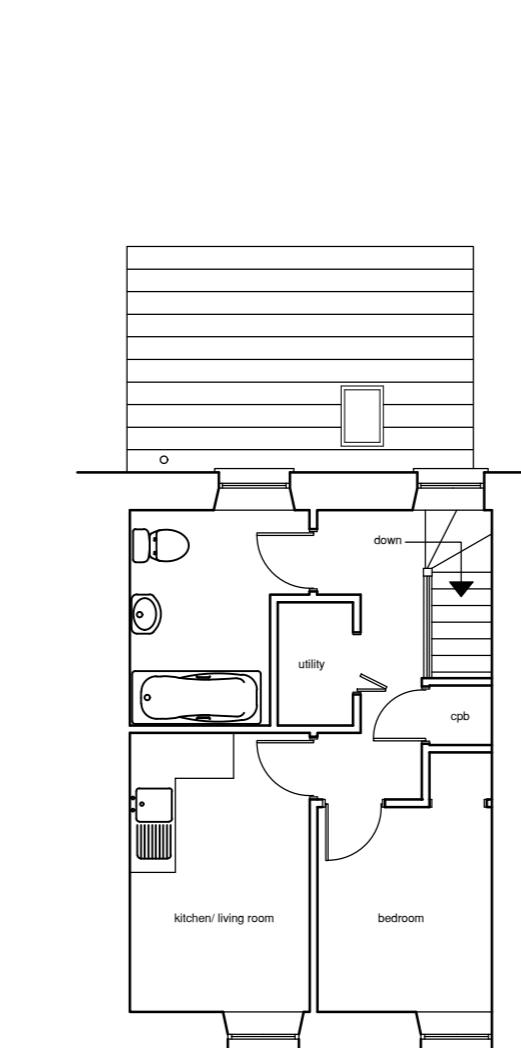

AS BUILT FIRST FLOOR

THIS DRAWING IS COPYRIGHT ©  
**Ken Bateman**  
Chartered Surveyor  
BSc (Hons) MRICS C.Built E MCARE  
  
project  
Conversion of dwelling to  
two self contained flats  
at  
22 Fox Street  
Treharris  
Merthyr Tydfil  
  
title  
Existing and proposed  
plans and elevations  
  
Date: March 2025  
Scale: A2@ 1:100  
Drawn:  
  
Drawing No. GA 001 Rev. 1