




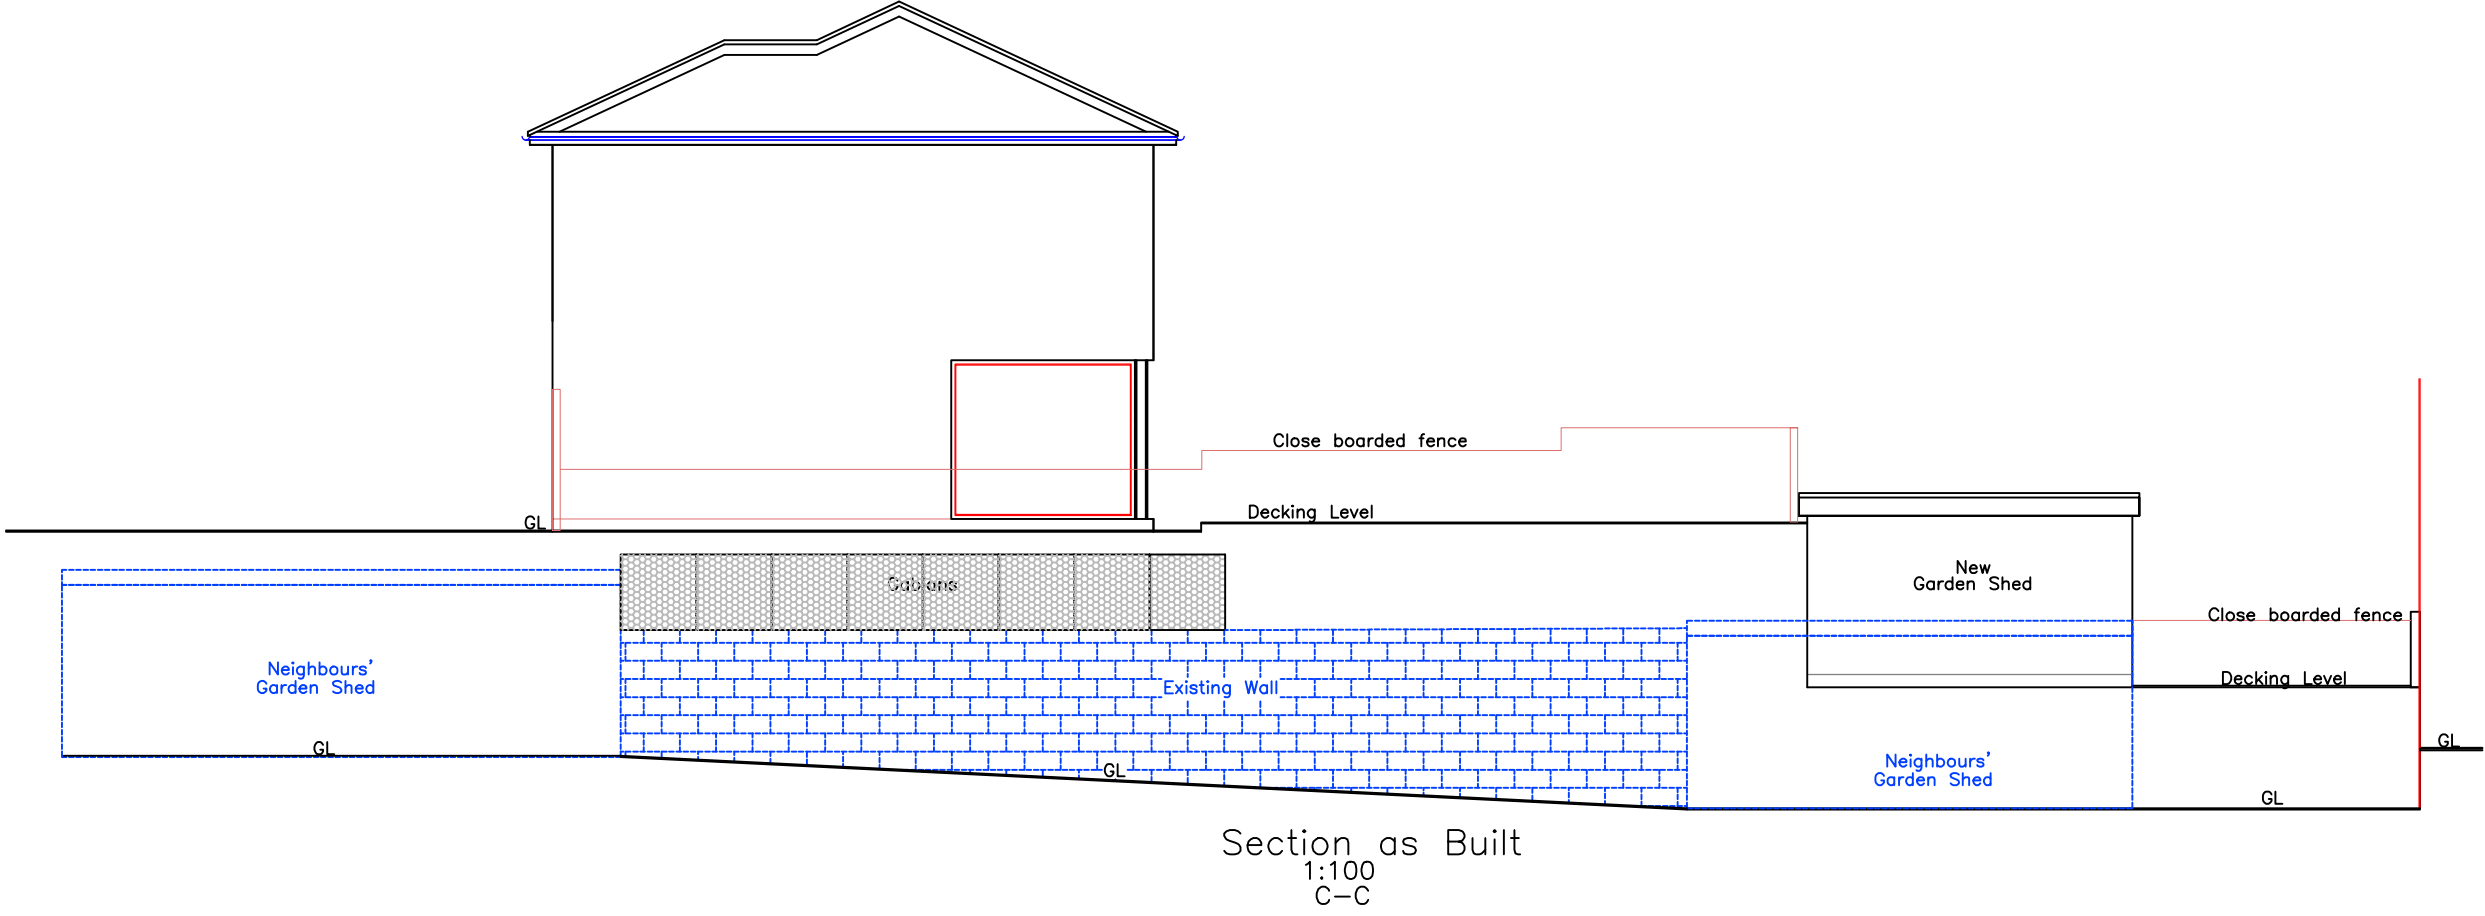

**Utopia Design**  
Architectural Services

Building Planning Application Support  
Paul Thomas: BSc (Hons)  
Tel: 01685 559230. Mob: 07908 725065

Issued Only for Purpose Indicated  
Drawing Status: FOR PRE-APP PLANNING PURPOSES ONLY

Address  
4, Graig Close  
Abercarnid  
Merthyr Tydfil  
CF48 1RA

Project  
Proposed Raised Decking  
with Garden Shed

|                  |                 |        |
|------------------|-----------------|--------|
| Drawn by         | Paper           | Date   |
| PT               | A2              | NOV 23 |
| Title            | Scale           |        |
|                  | 1:100<br>1:200  |        |
|                  | Drawg No        |        |
| Section as Built | GRAIG 4 DECK 03 |        |