



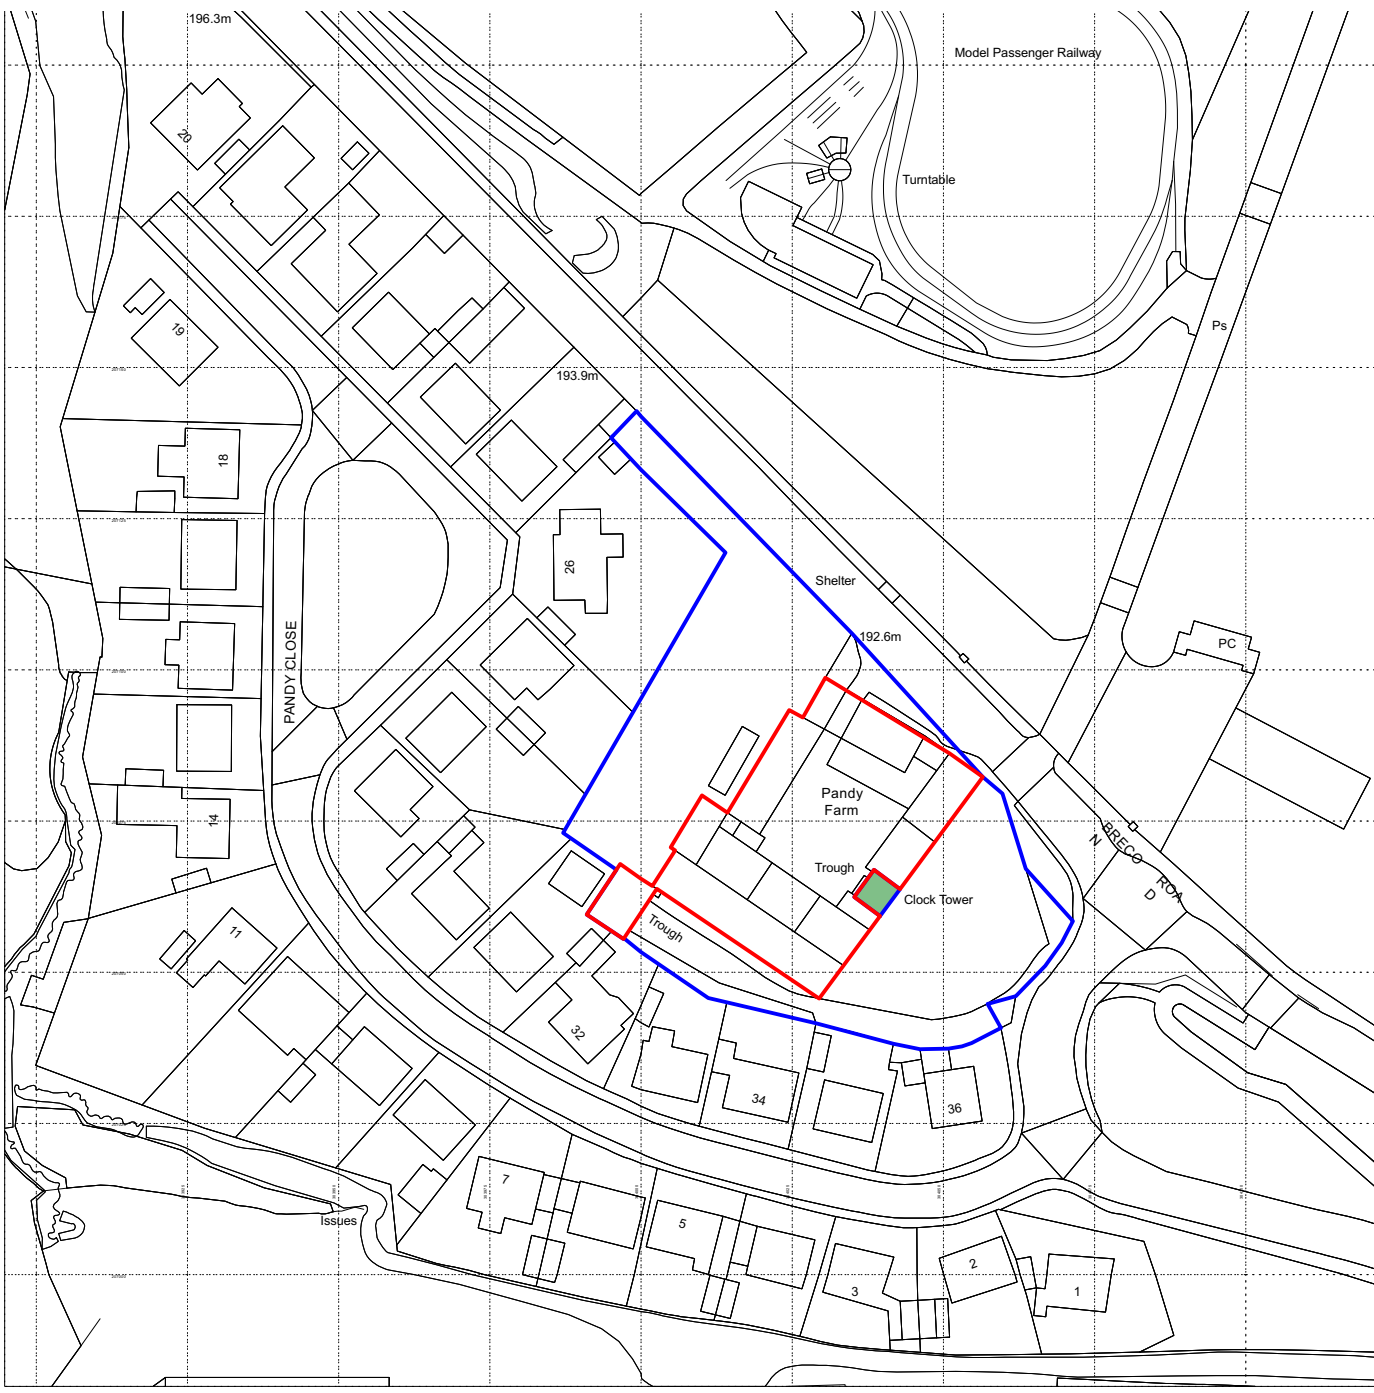


Ordnance Survey, (c) Crown Copyright 2021. All rights reserved. Licence number 100022432


Location Plan
Scale: 1:1250

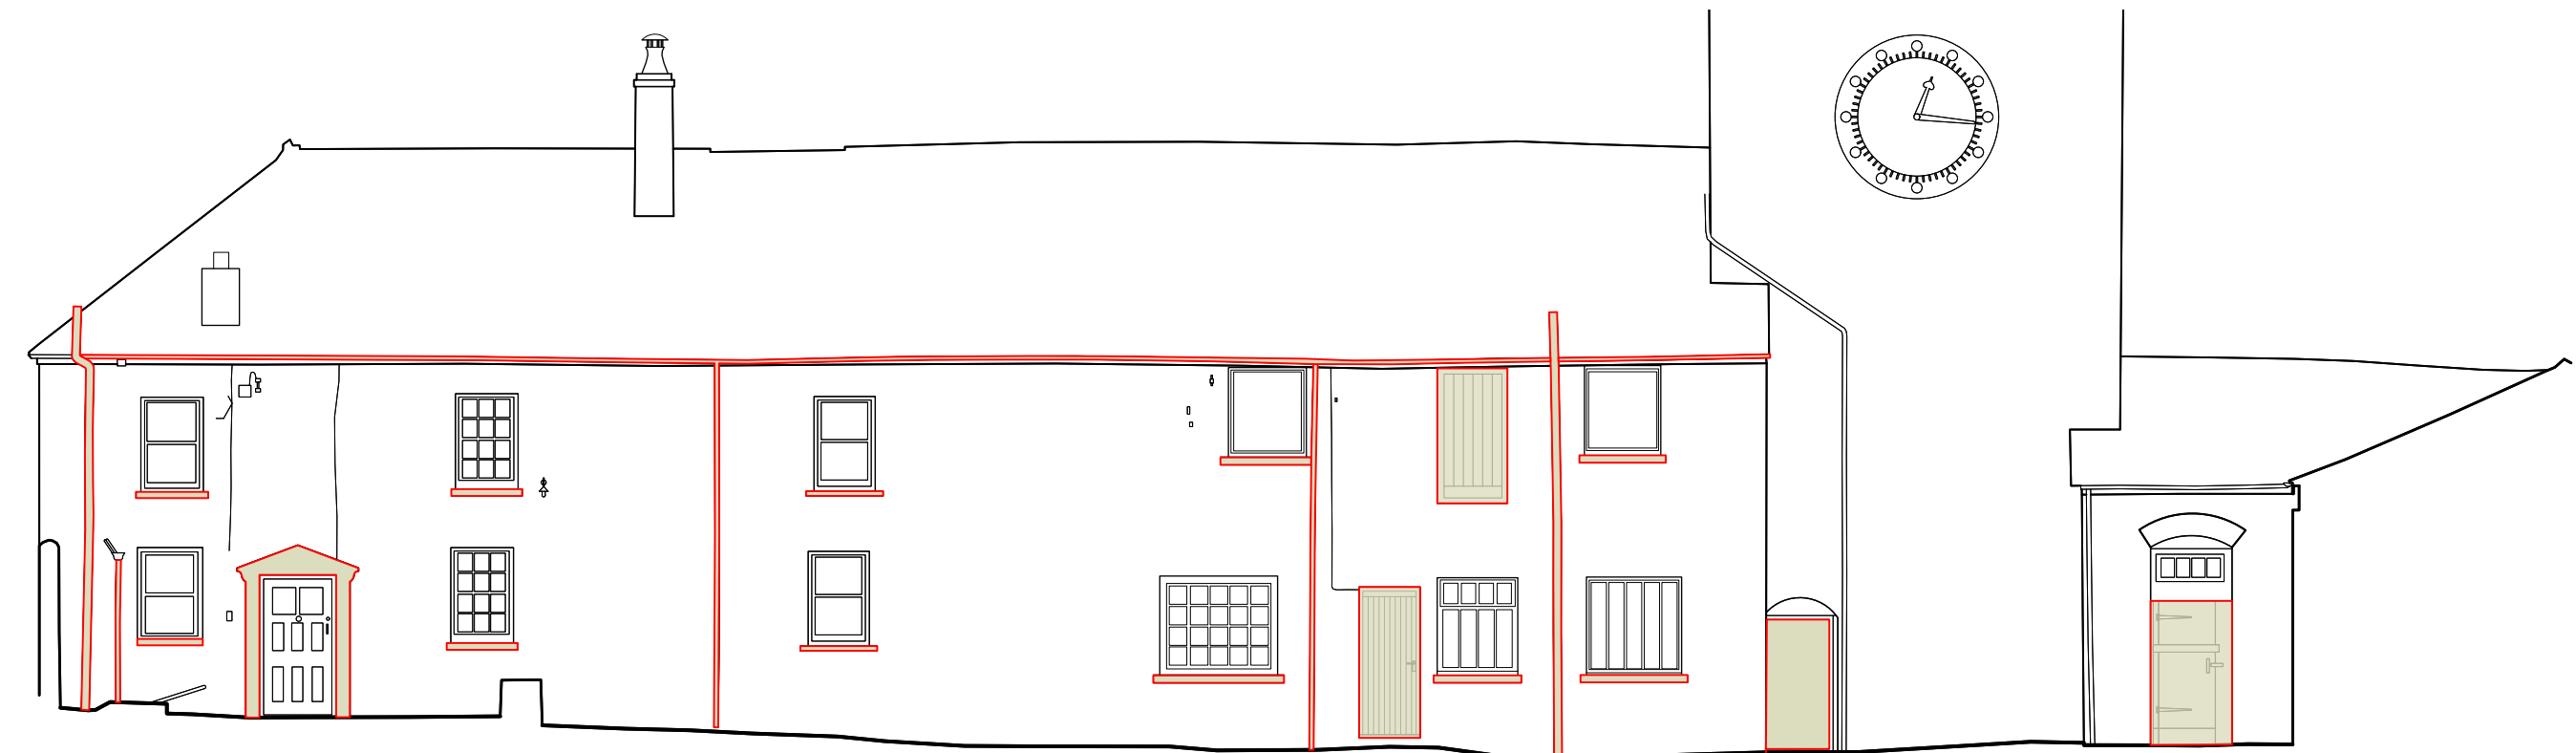


Existing Farmhouse North-West Elevation
Scale: 1:100

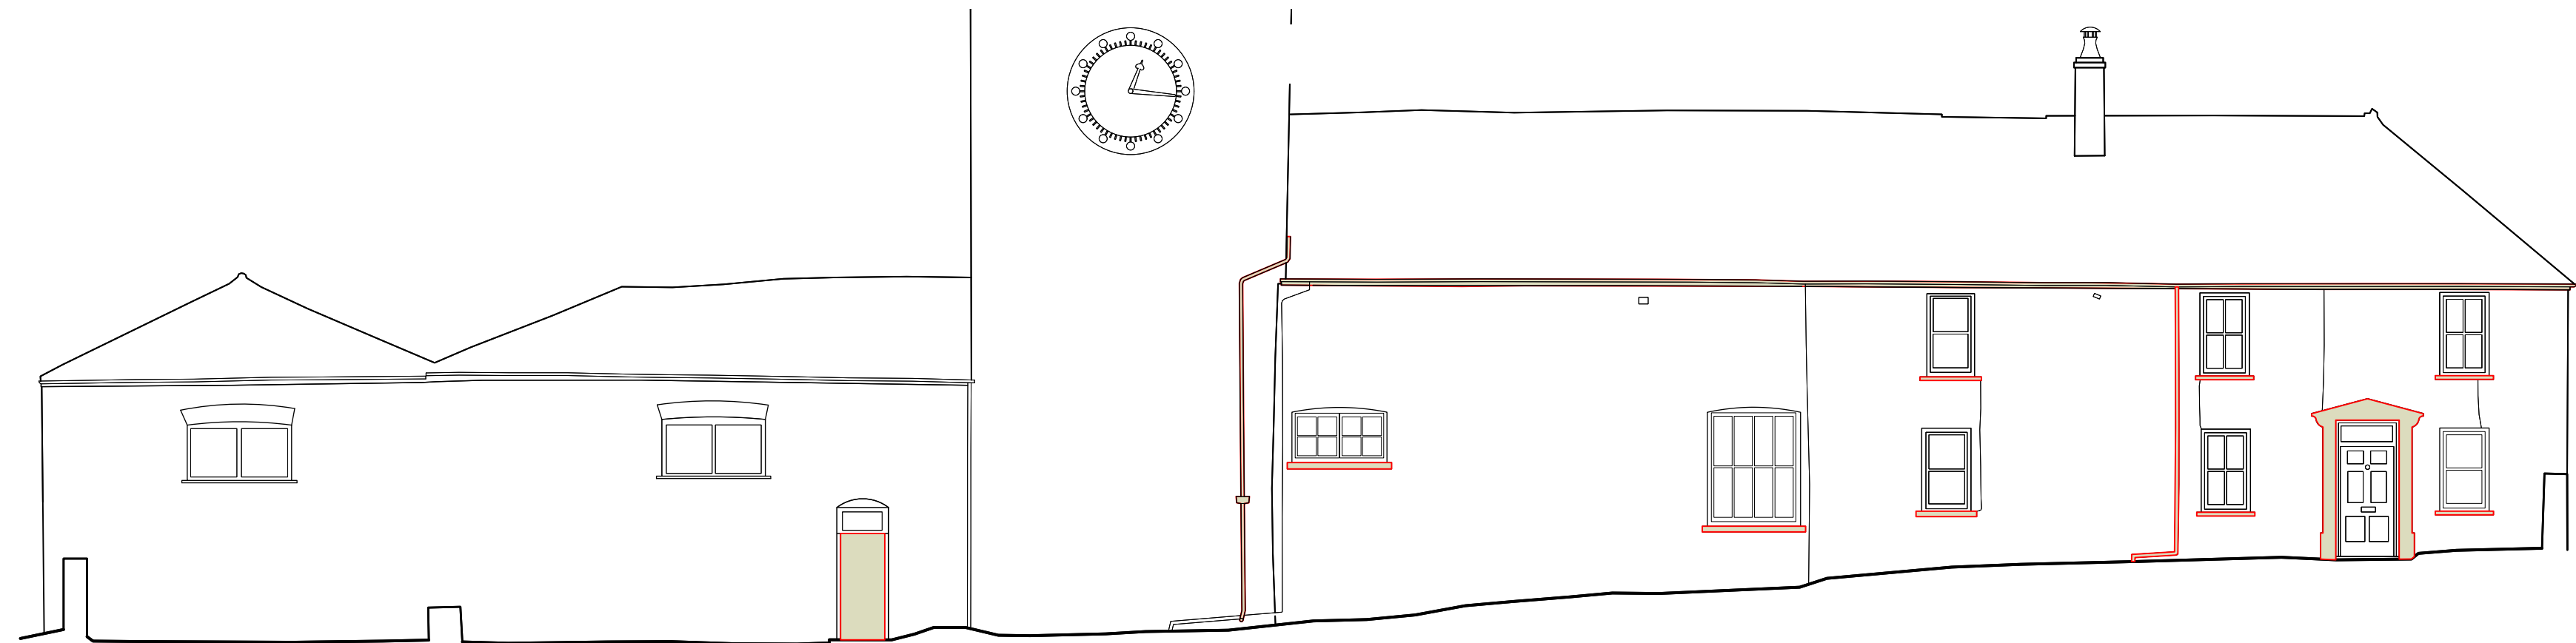


Existing Farmhouse South-East Elevation
Scale: 1:100

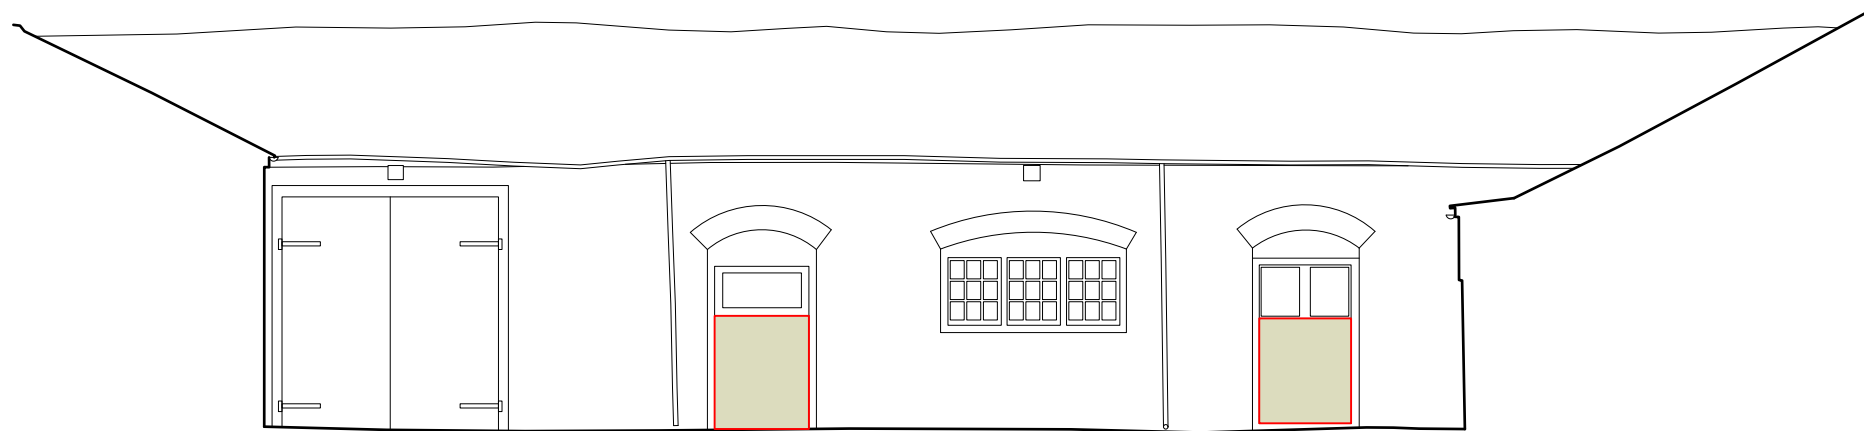

Existing stables North-East Elevation
Scale: 1:100

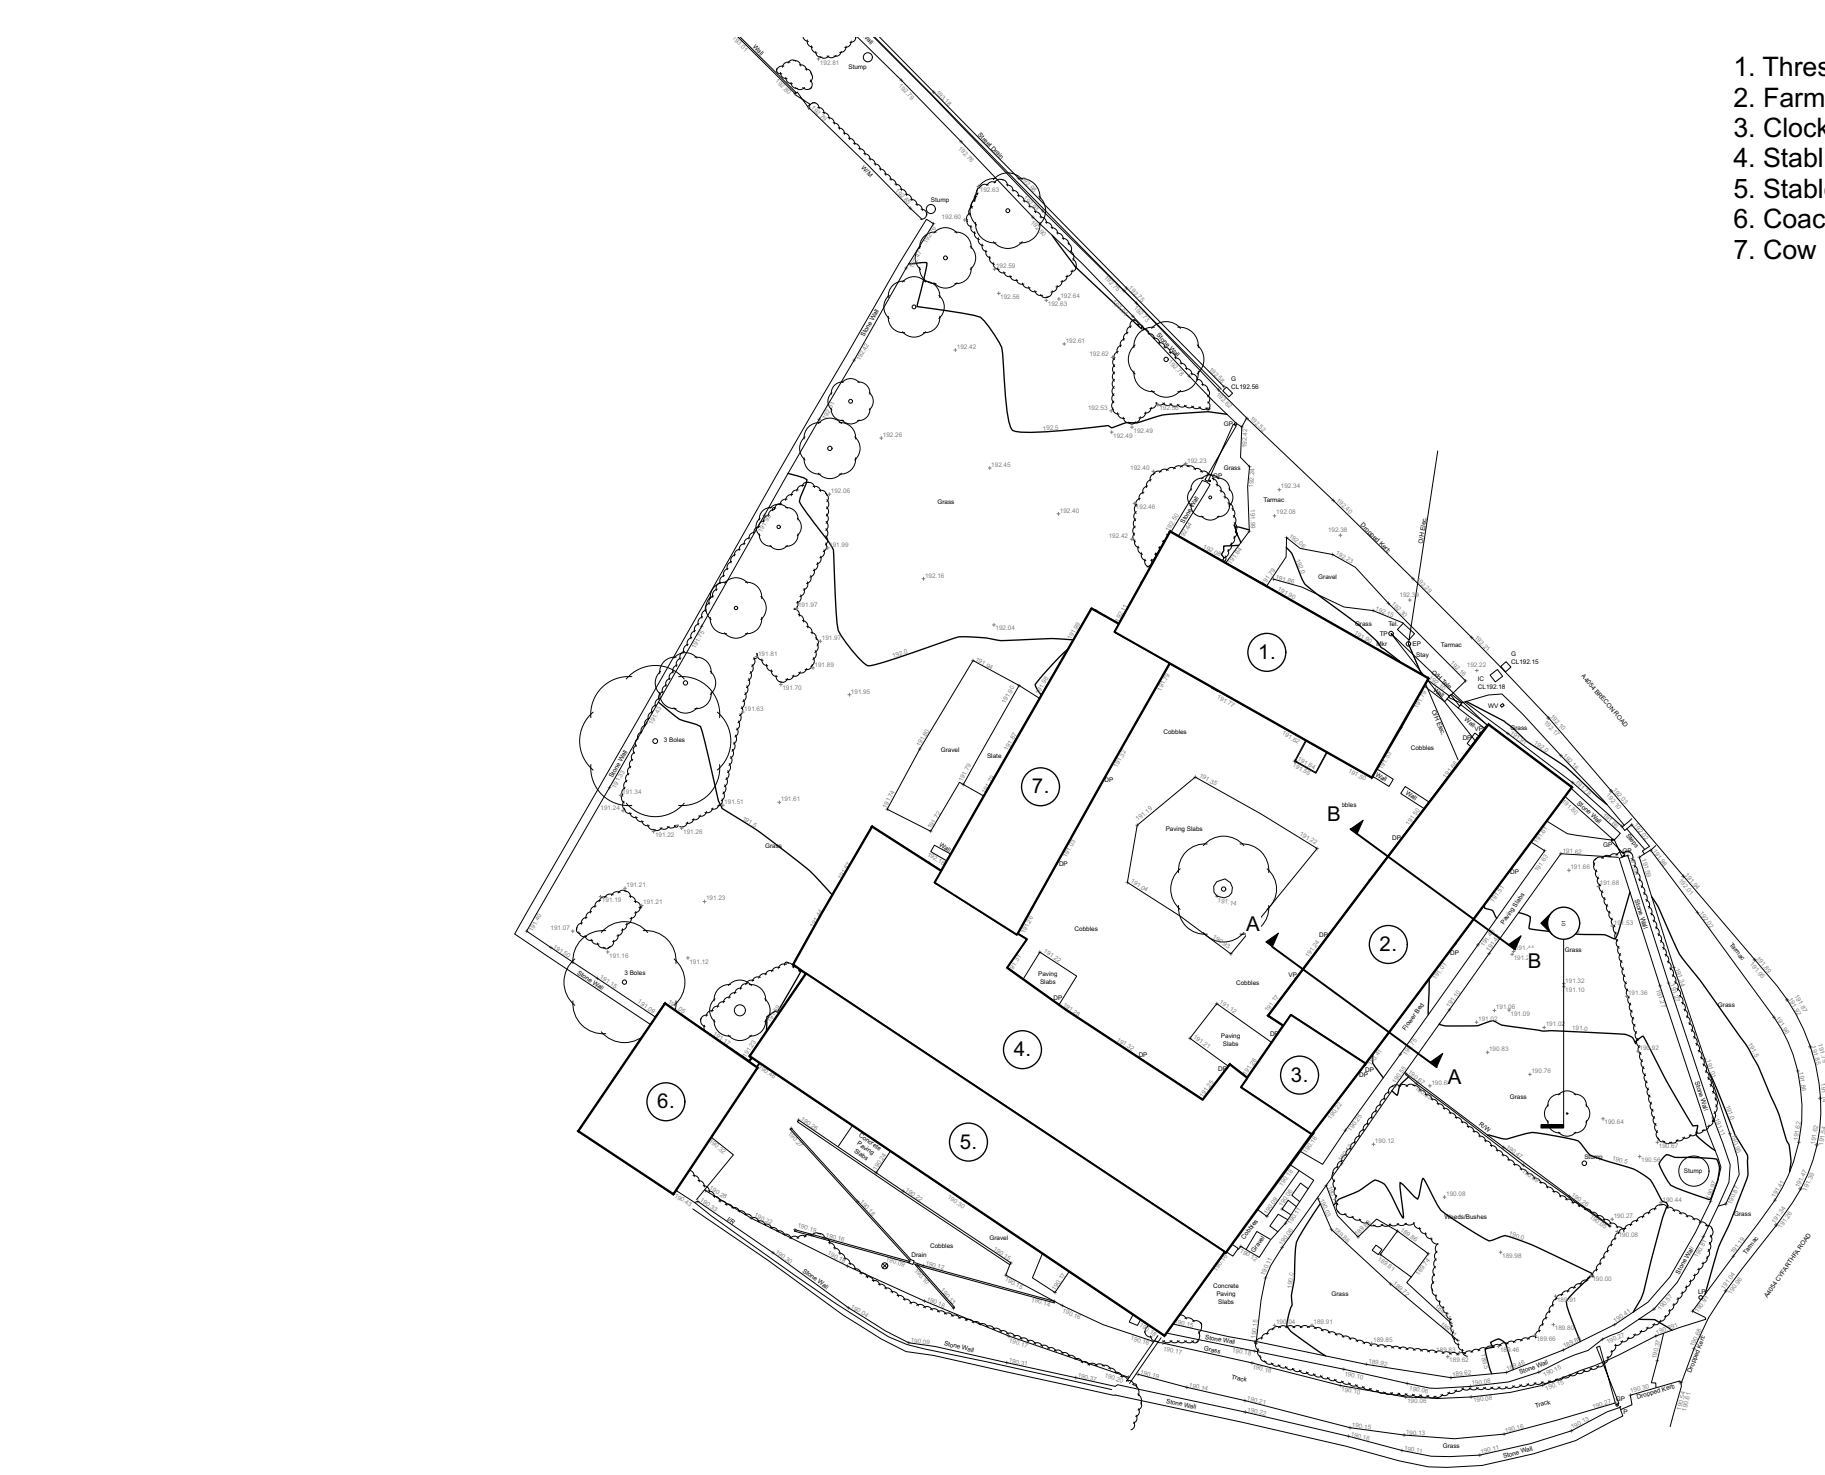


Existing Site Plan
Scale: 1:500

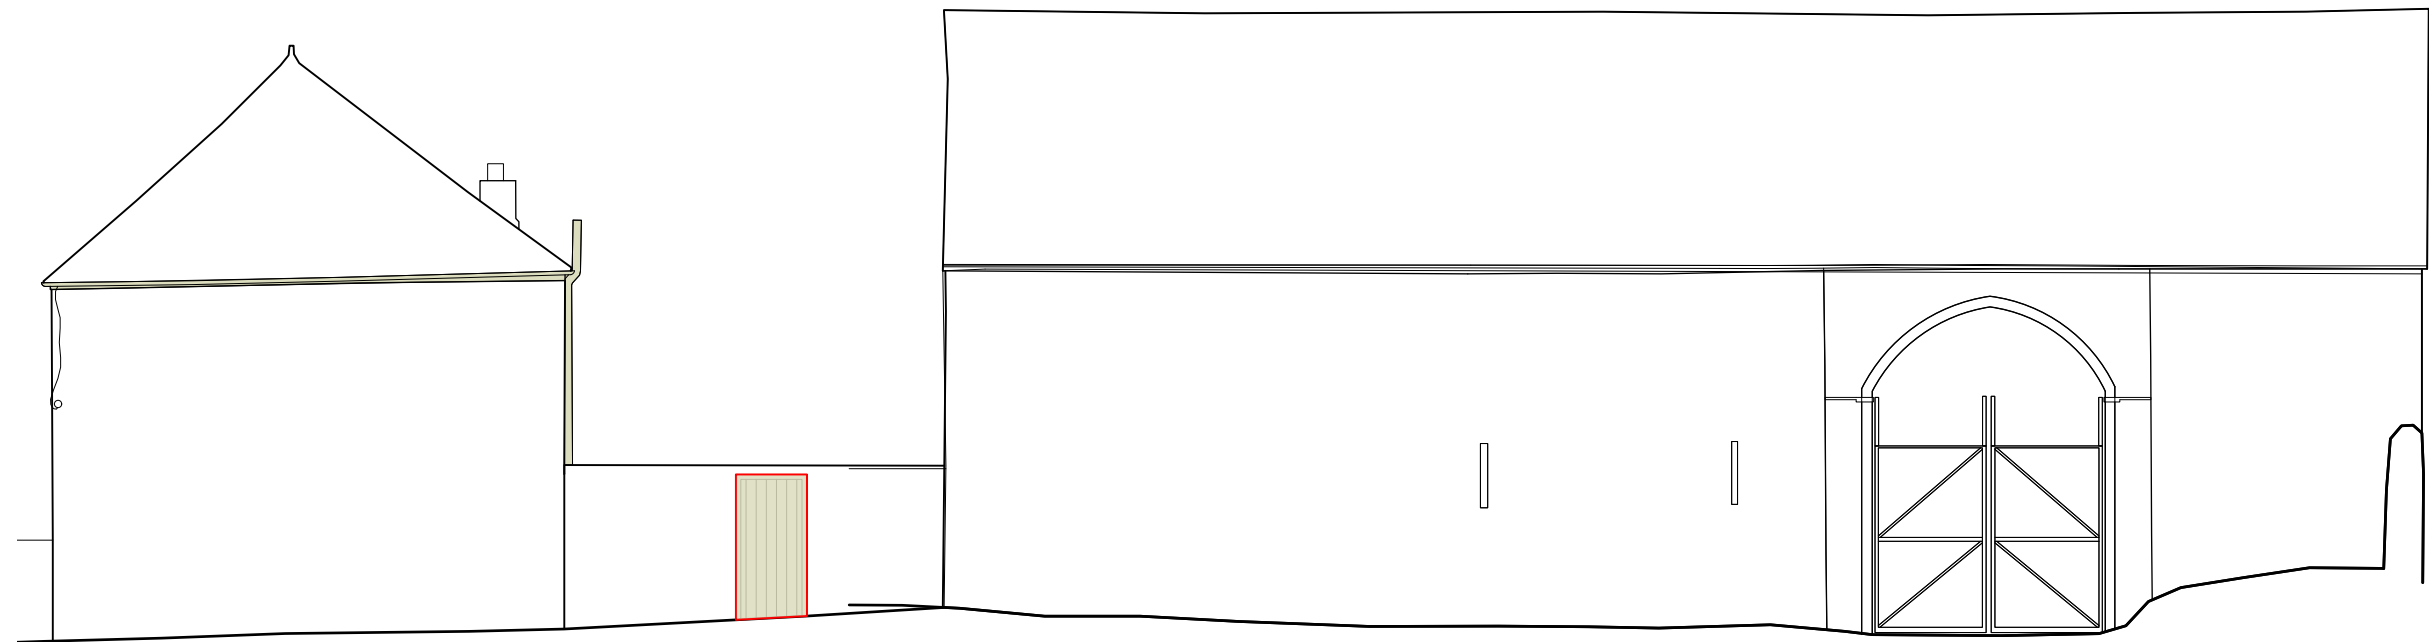


Existing Barn North-East elevation
Scale: 1:100

0 1 2 3 4 5M

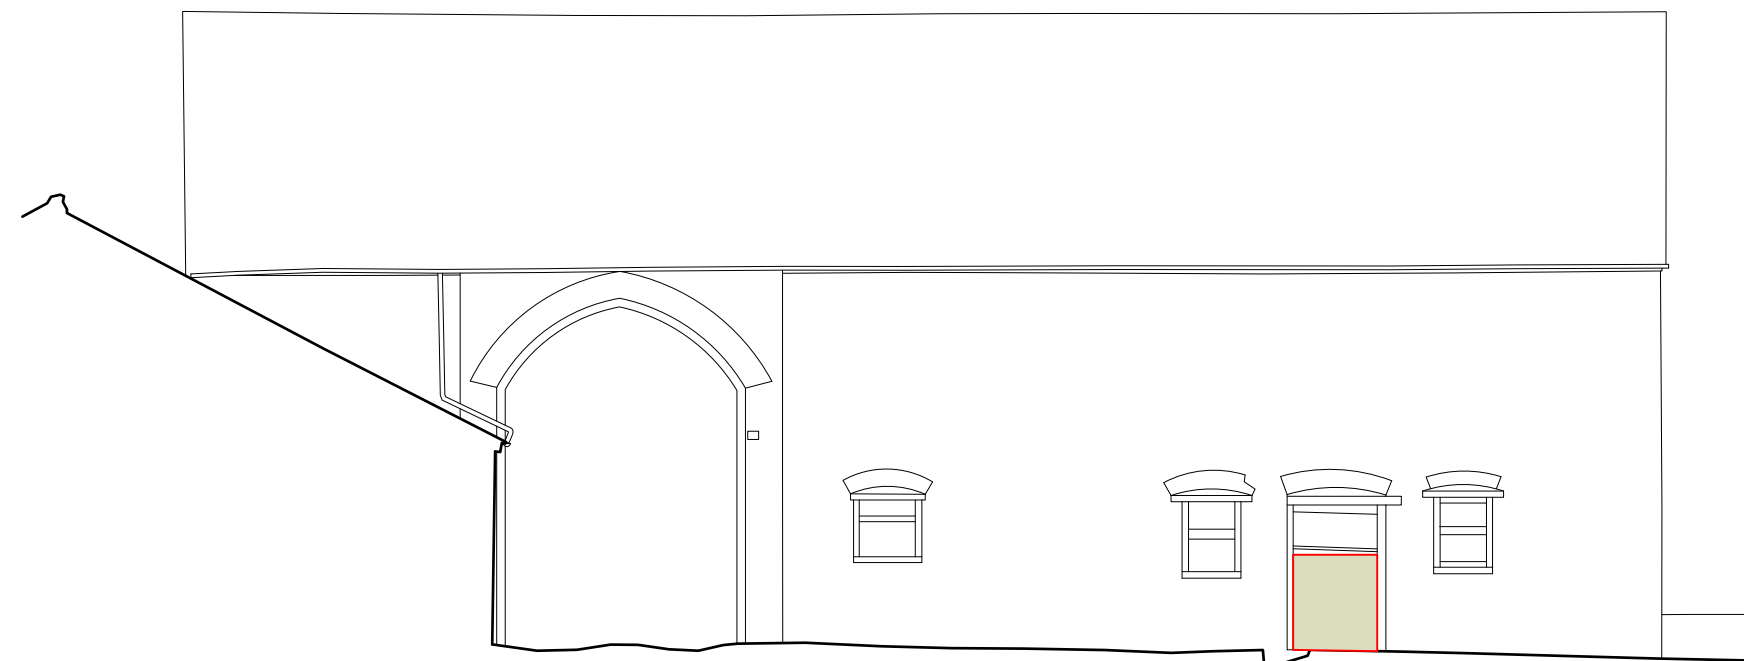

Existing barn South-West Elevation
Scale: 1:100

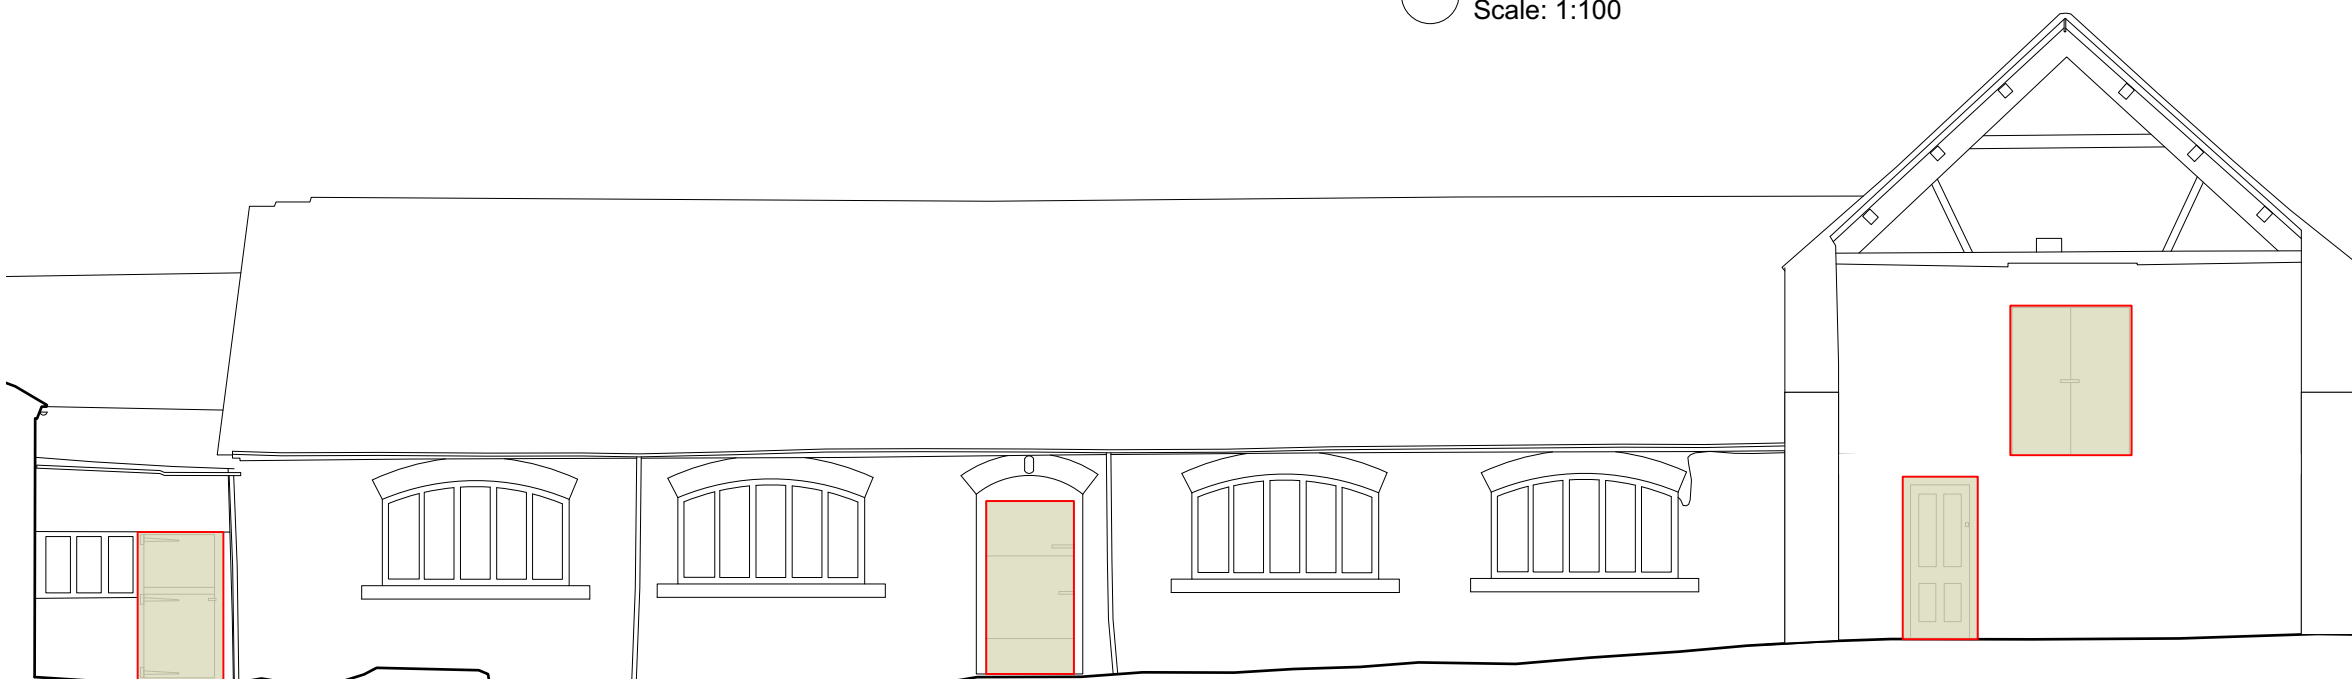

Existing Stables South-West Elevation
Scale: 1:100

1. Threshing/ Combination Barn
2. Farmhouse
3. Clock Tower
4. Stabling (Courtyard)
5. Stables & Tack Room (South)
6. Coach House
7. Cow Housing (East)

Copyright: All rights reserved. This drawing must not be reproduced without permission. Only the original drawing should be relied upon. Contractors, subcontractors and suppliers must verify all dimensions on site before commencing any work or making any shop drawings. All shop drawings to be submitted to the Architect prior to fabrication. This drawing is to be read in conjunction with the Architects specification, bills of quantities / schedules, structural, mechanical & electrical drawings and all discrepancies are to be reported to the architect. Do not scale from this drawing. Dimensions are in millimetres unless otherwise stated.

NOTES

rev	amendments	date	by
A	Red line site boundary amended	06.07.23	NH

KEY:

Building element painted with existing yellow colour. Colour to be replaced with an alternative paint colour - See heritage impact statement and design access statement for further details

Rural Office

Rural Office
Yr Egin, College Rd.
Carmarthen, SA31 3EQ

rural-office.co.uk
enquiries@rural-office.co.uk
01559 505 008

project

Pandy Farm

client

Mr K Jones

drawing title

Farmhouse - paint colour amendments

drawing status

Planning & LBC

scale	date	drawn by	checked by
1:100 @ A1	05.05.23	NH	NM

job no.	drawing no.	revision
179	3-0150	A