

Revisions	
A	Signage note and overnight security gates amended. 17 Sep '19
B	Signage zone added. 20 Sep '19
C	'Contract Documents' Drawing Status added. 18 Oct '19
D	Hatch added indicating extent of second phase works to South Mall. Temporary escape stairs added and noted. 07 Nov '19
E	Lift and stair details updated. 2 no. level resting areas added to the South Mall as requested by Building Control. 16 Jun '20

DIMENSIONS ARE NOT TO BE SCALED FROM THIS DRAWING
THIS DRAWING IS COPYRIGHT


CONSTRUCTION RISK HI NUMBER



NOTE:
THIS DRAWING HAS BEEN PRODUCED FROM THIRD PARTY
INFORMATION AND IS NOT AN AS BUILT DRAWING.


THIS DRAWING IS ONLY A REPRESENTATION AND THEREFORE
DISCREPANCIES MAY BE PRESENT. ALL DIMENSIONS ARE
APPROXIMATE ONLY.

IT IS RECOMMENDED THAT A DETAILED SURVEY IS
COMMISSIONED PRIOR TO ANY FUTURE DESIGN WORK.

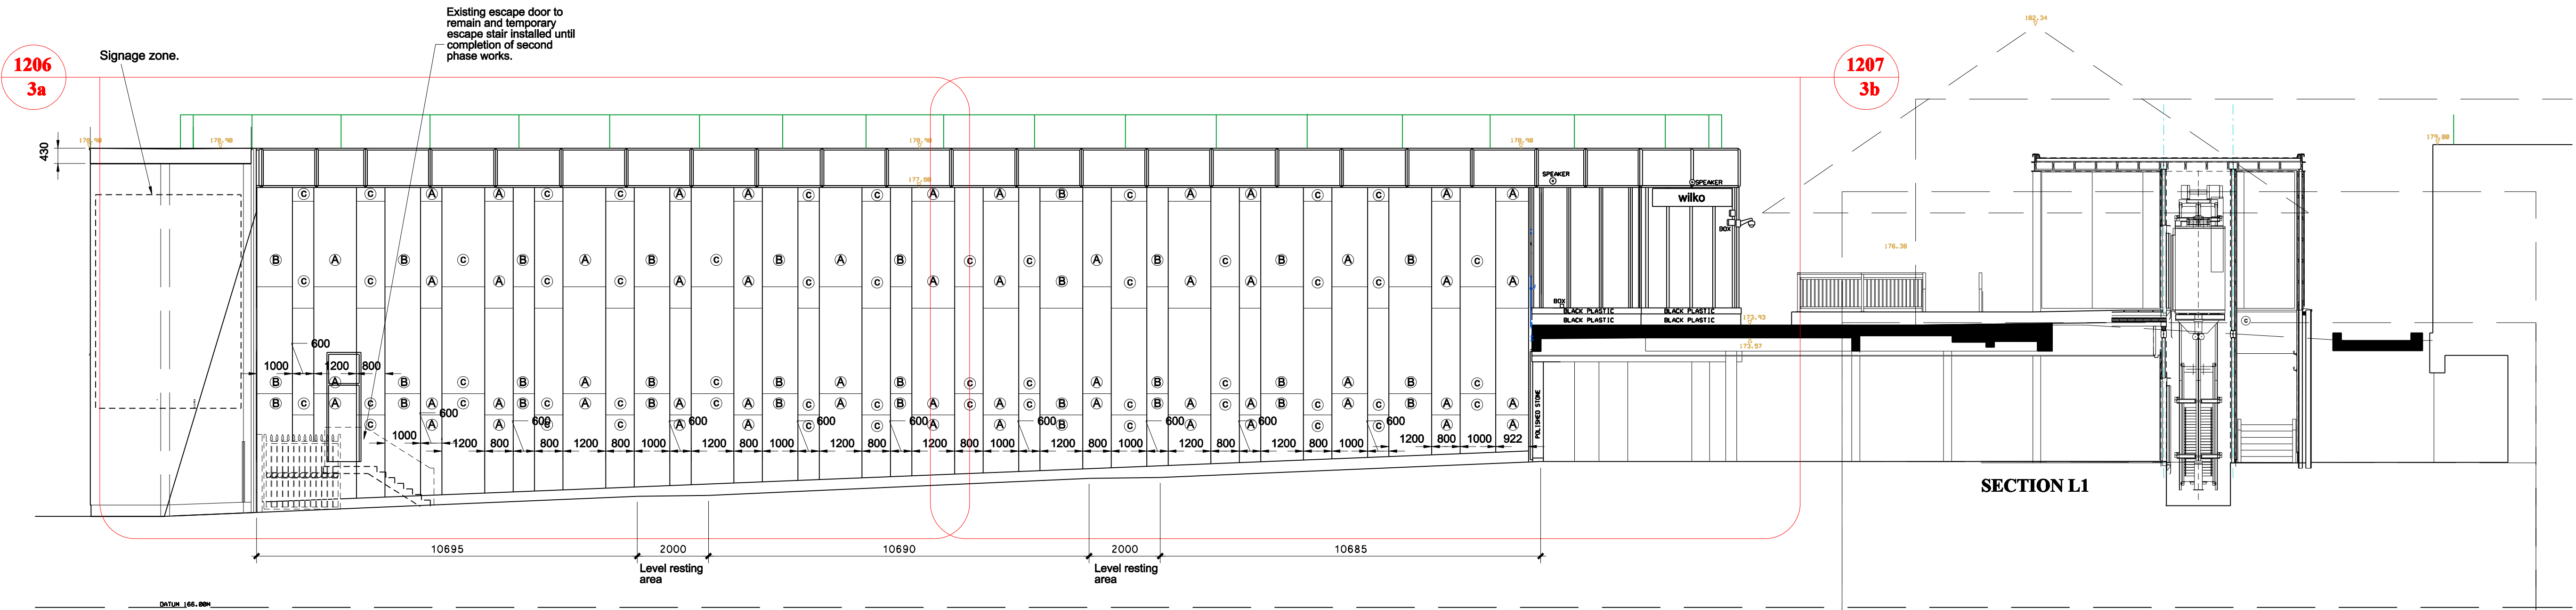


SECTION L1

PROPOSED ELEVATION 3

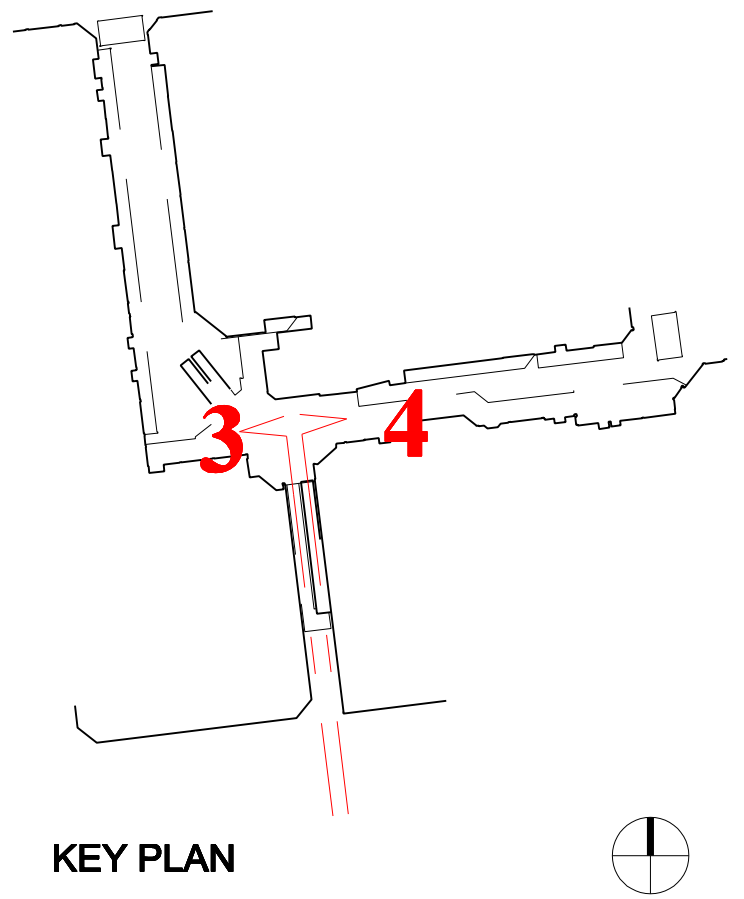

KEY PLAN

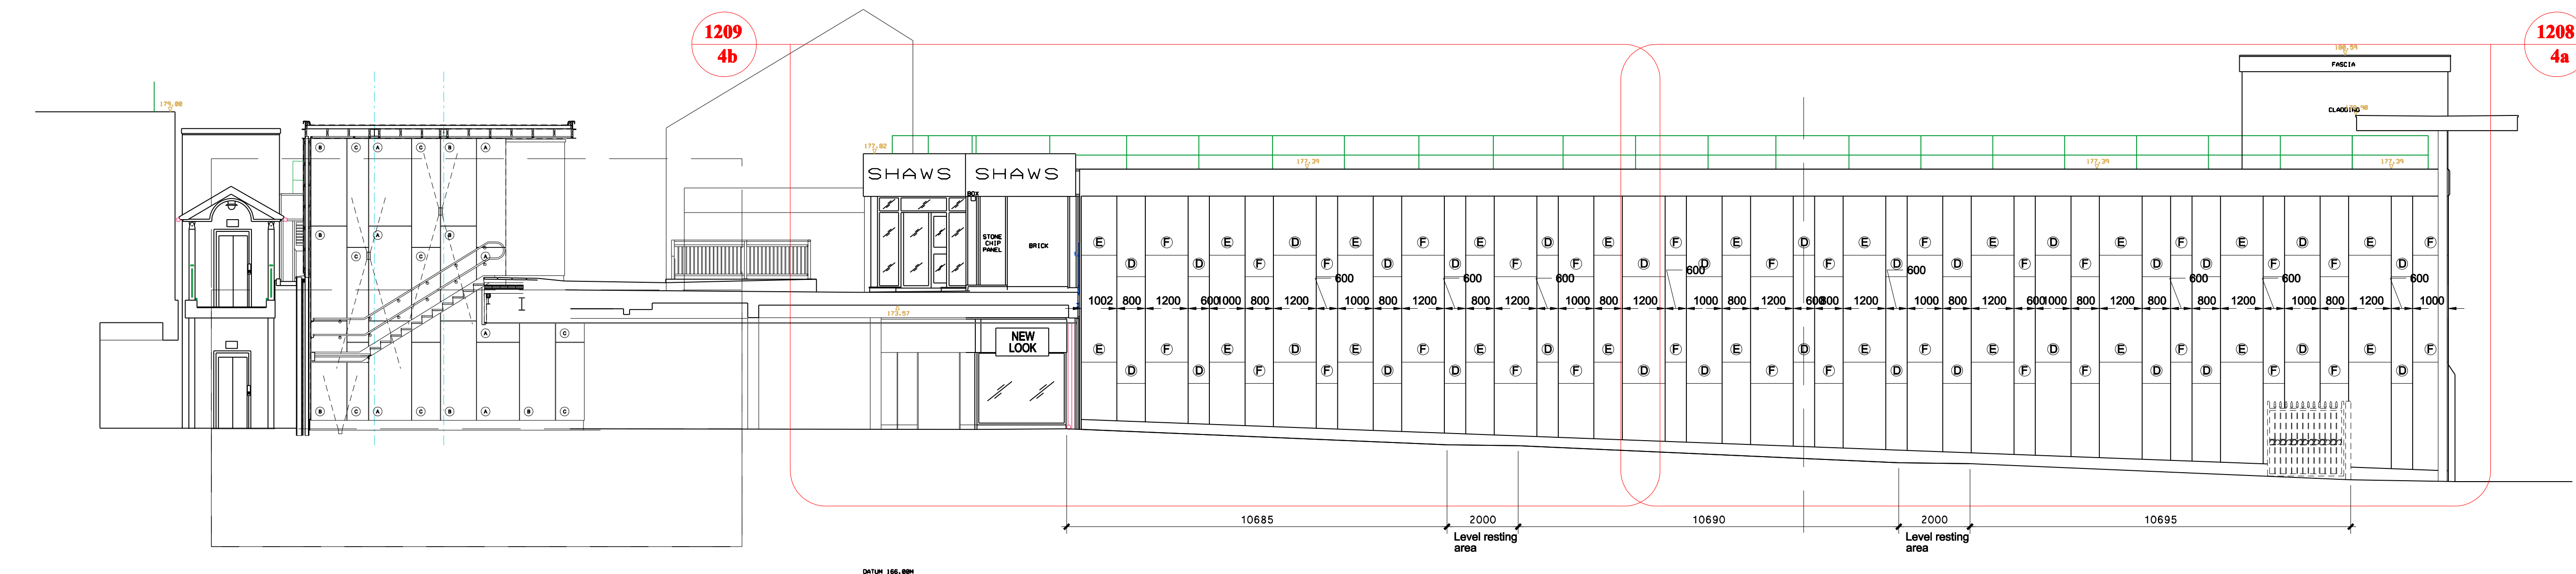

PROPOSED ELEVATION 4

- FINISHES :-
- CLADDING PANELS -
- (A) TRESPA - A08.2.3 SALMON, SATIN FINISH
 - (B) TRESPA - A12.1.8 PASSION RED, SATIN FINISH
 - (C) TRESPA - A12.3.7 CARMINE RED, SATIN FINISH
 - (D) TRESPA - A21.1.0 WINTER GREY, SATIN FINISH
 - (E) TRESPA - A03.4.0 SILVER GREY, SATIN FINISH
 - (F) TRESPA - A21.7.0 STEEL GREY, SATIN FINISH
- RAIN SCREEN CLADDING ON ALUMINIUM SUPPORT
FRAME, DRAINED AND VENTILATED CAVITY WITH
EXPOSED COLOUR MATCHED RIVET FIXINGS.

KEY:-

pentan
architects

22 Cathedral Road
Cardiff CF11 9LJ
t: 029 2030 9010
info@pentan.co.uk

Project
ST TYDFIL SHOPPING CENTRE
Client
R & M WILLIAMS

Drawing Title
PROPOSED SECTION
ELEVATION 3 + 4

Date
MAR '19
Scale
1:100 @ A1
Drawing No.
3779-A-1205
Rev.
E

NOTES. Do not scale. All dimensions are in millimetres unless stated otherwise