

Revisions		
A	First floor balustrade and skirting note amended.	17 Sep '19
B	Signage zone added.	20 Sep '19
C	'Contract Documents' Drawing Status added.	18 Oct '19
D	Stair and lift area details generally updated. PPC aluminium flashing added to edge of floor in lieu of Trespa and exposed grid ceiling system added in lieu of linear ceiling system.	16 Jun '20


DIMENSIONS ARE NOT TO BE SCALED FROM THIS DRAWING
THIS DRAWING IS COPYRIGHT




NOTE:
THIS DRAWING HAS BEEN PRODUCED FROM THIRD PARTY
INFORMATION AND IS NOT AN AS BUILT DRAWING.

THIS DRAWING IS ONLY A REPRESENTATION AND THEREFORE
DISCREPANCIES MAY BE PRESENT. ALL DIMENSIONS ARE
APPROXIMATE ONLY.

IT IS RECOMMENDED THAT A DETAILED SURVEY IS
COMMISSIONED PRIOR TO ANY FUTURE DESIGN WORK.

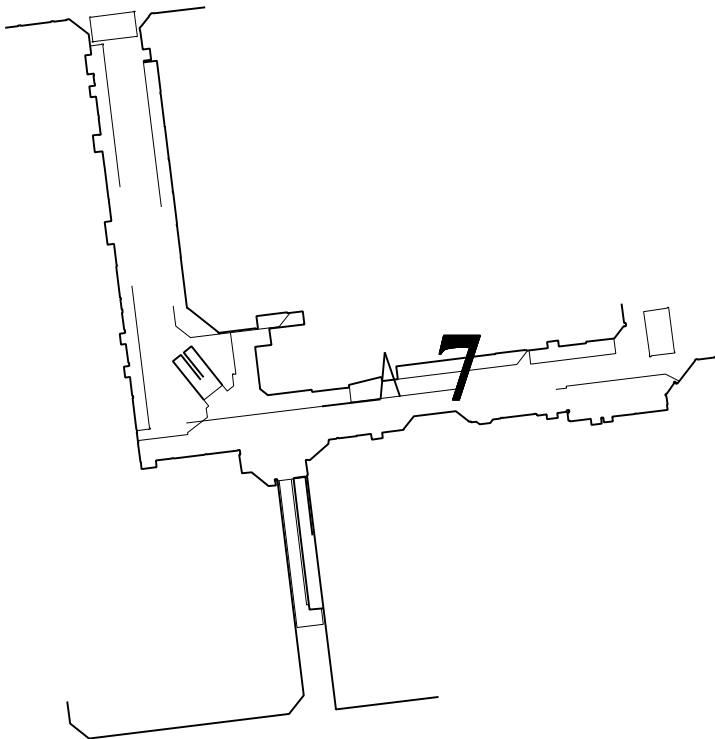

KEY PLAN

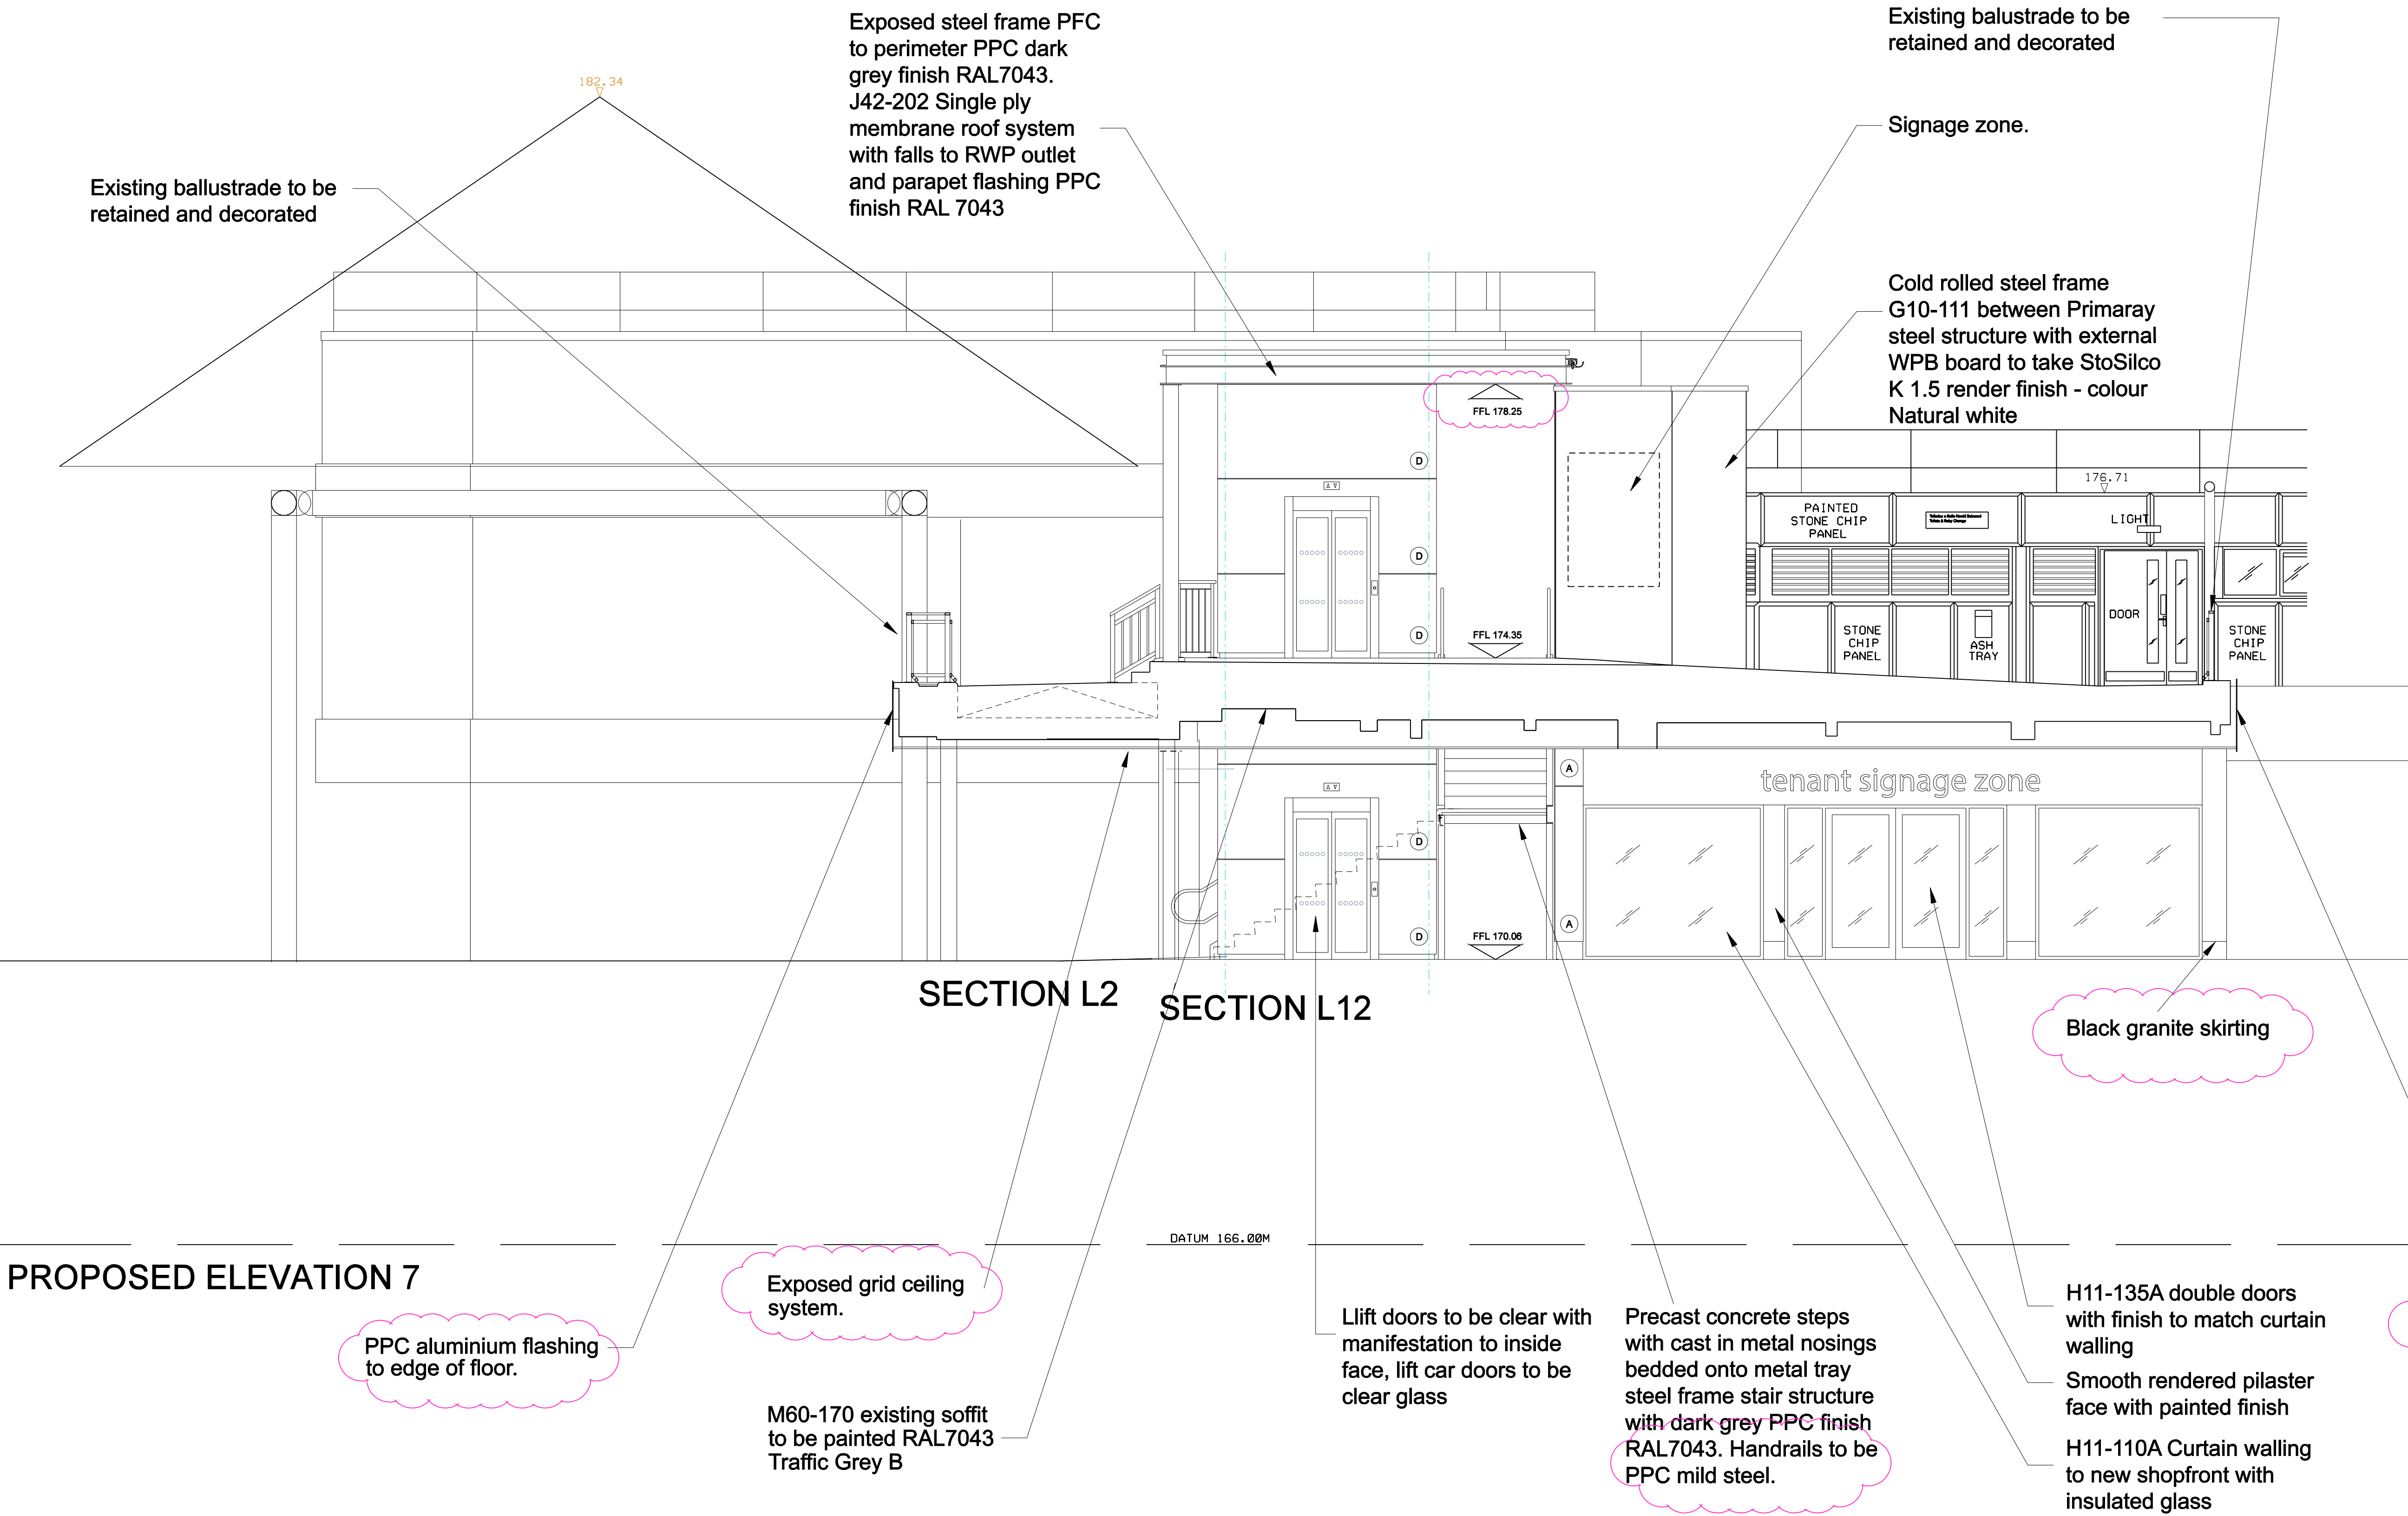

PROPOSED ELEVATION 7

pentan
architects

22 Cathedral Road
Cardiff CF11 9LJ
t: 029 2030 9010
info@pentan.co.uk

Project
ST TYDFIL SHOPPING CENTRE
Client
R & M WILLIAMS
Drawing Title
PROPOSED SECTION
ELEVATION 7

NOTES. Do not scale. All dimensions are in millimetres unless stated otherwise

Date
MAR '19
Scale
1:50 @ A1
Drawing No.
3779_A_1220
Rev.
D