





210300

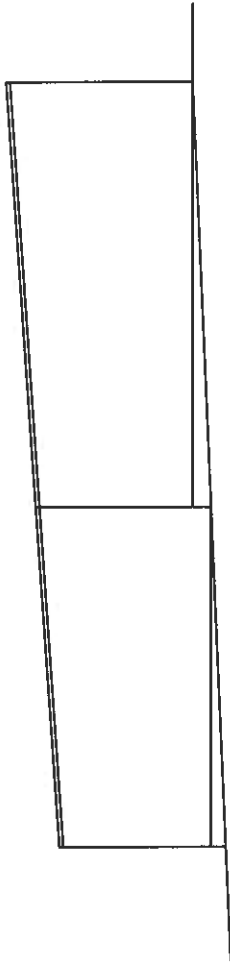


SIDE ELEVATION - ~~EXISTING~~
Proposed

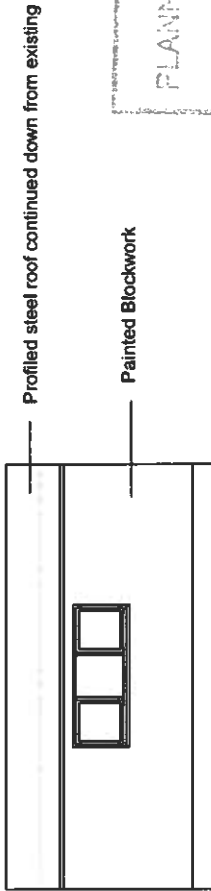


REAR ELEVATION - ~~EXISTING~~
proposed

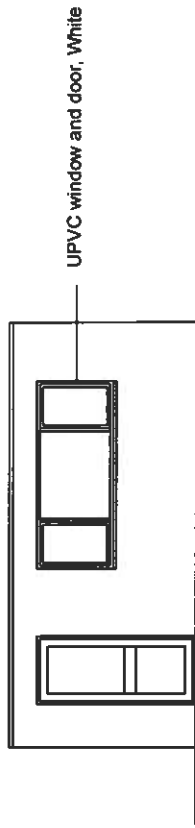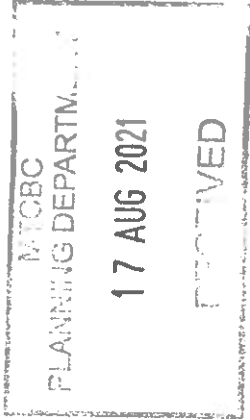

FRONT ELEVATION - ~~EXISTING~~
Proposed

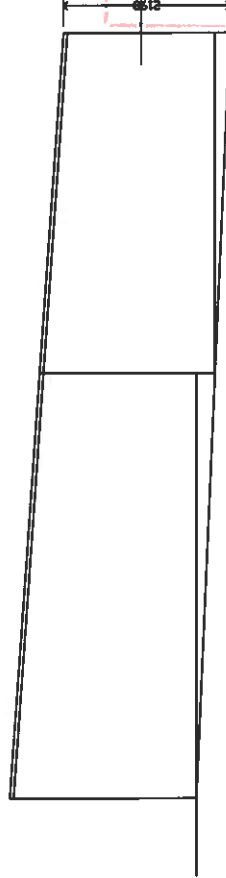

SIDE ELEVATION - ~~EXISTING~~
Proposed

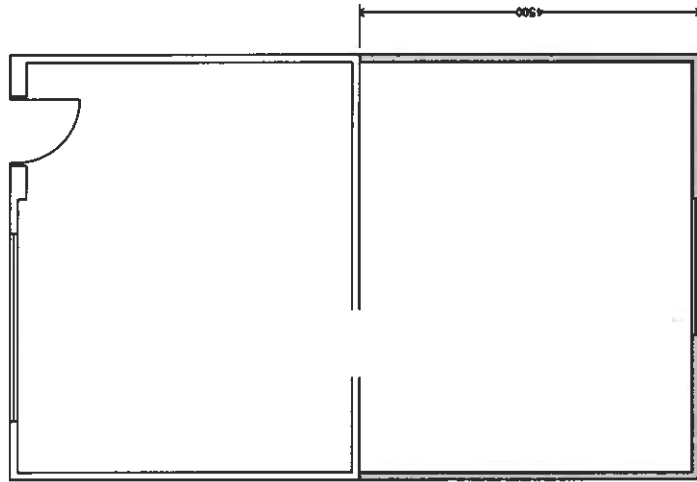

GROUND FLOOR PLAN - ~~EXISTING~~
Proposed

k.j.lloyd
AADip. RIBA
CHARTERED ARCHITECT

49 Coed Y Pia, Llanbradach
Caerphilly, CF83 3PT

PROJECT
PROPOSED GYM
21 ASH CRESCENT
MERTHYR TYDFIL

SCALE
1:100 @ A3
DRAWN
KL

DATE
AUG 2021
DRG NO.
02

DRAWING
PROPOSED PLAN AND ELEVATIONS

THIS DRAWING IS COPYRIGHT