


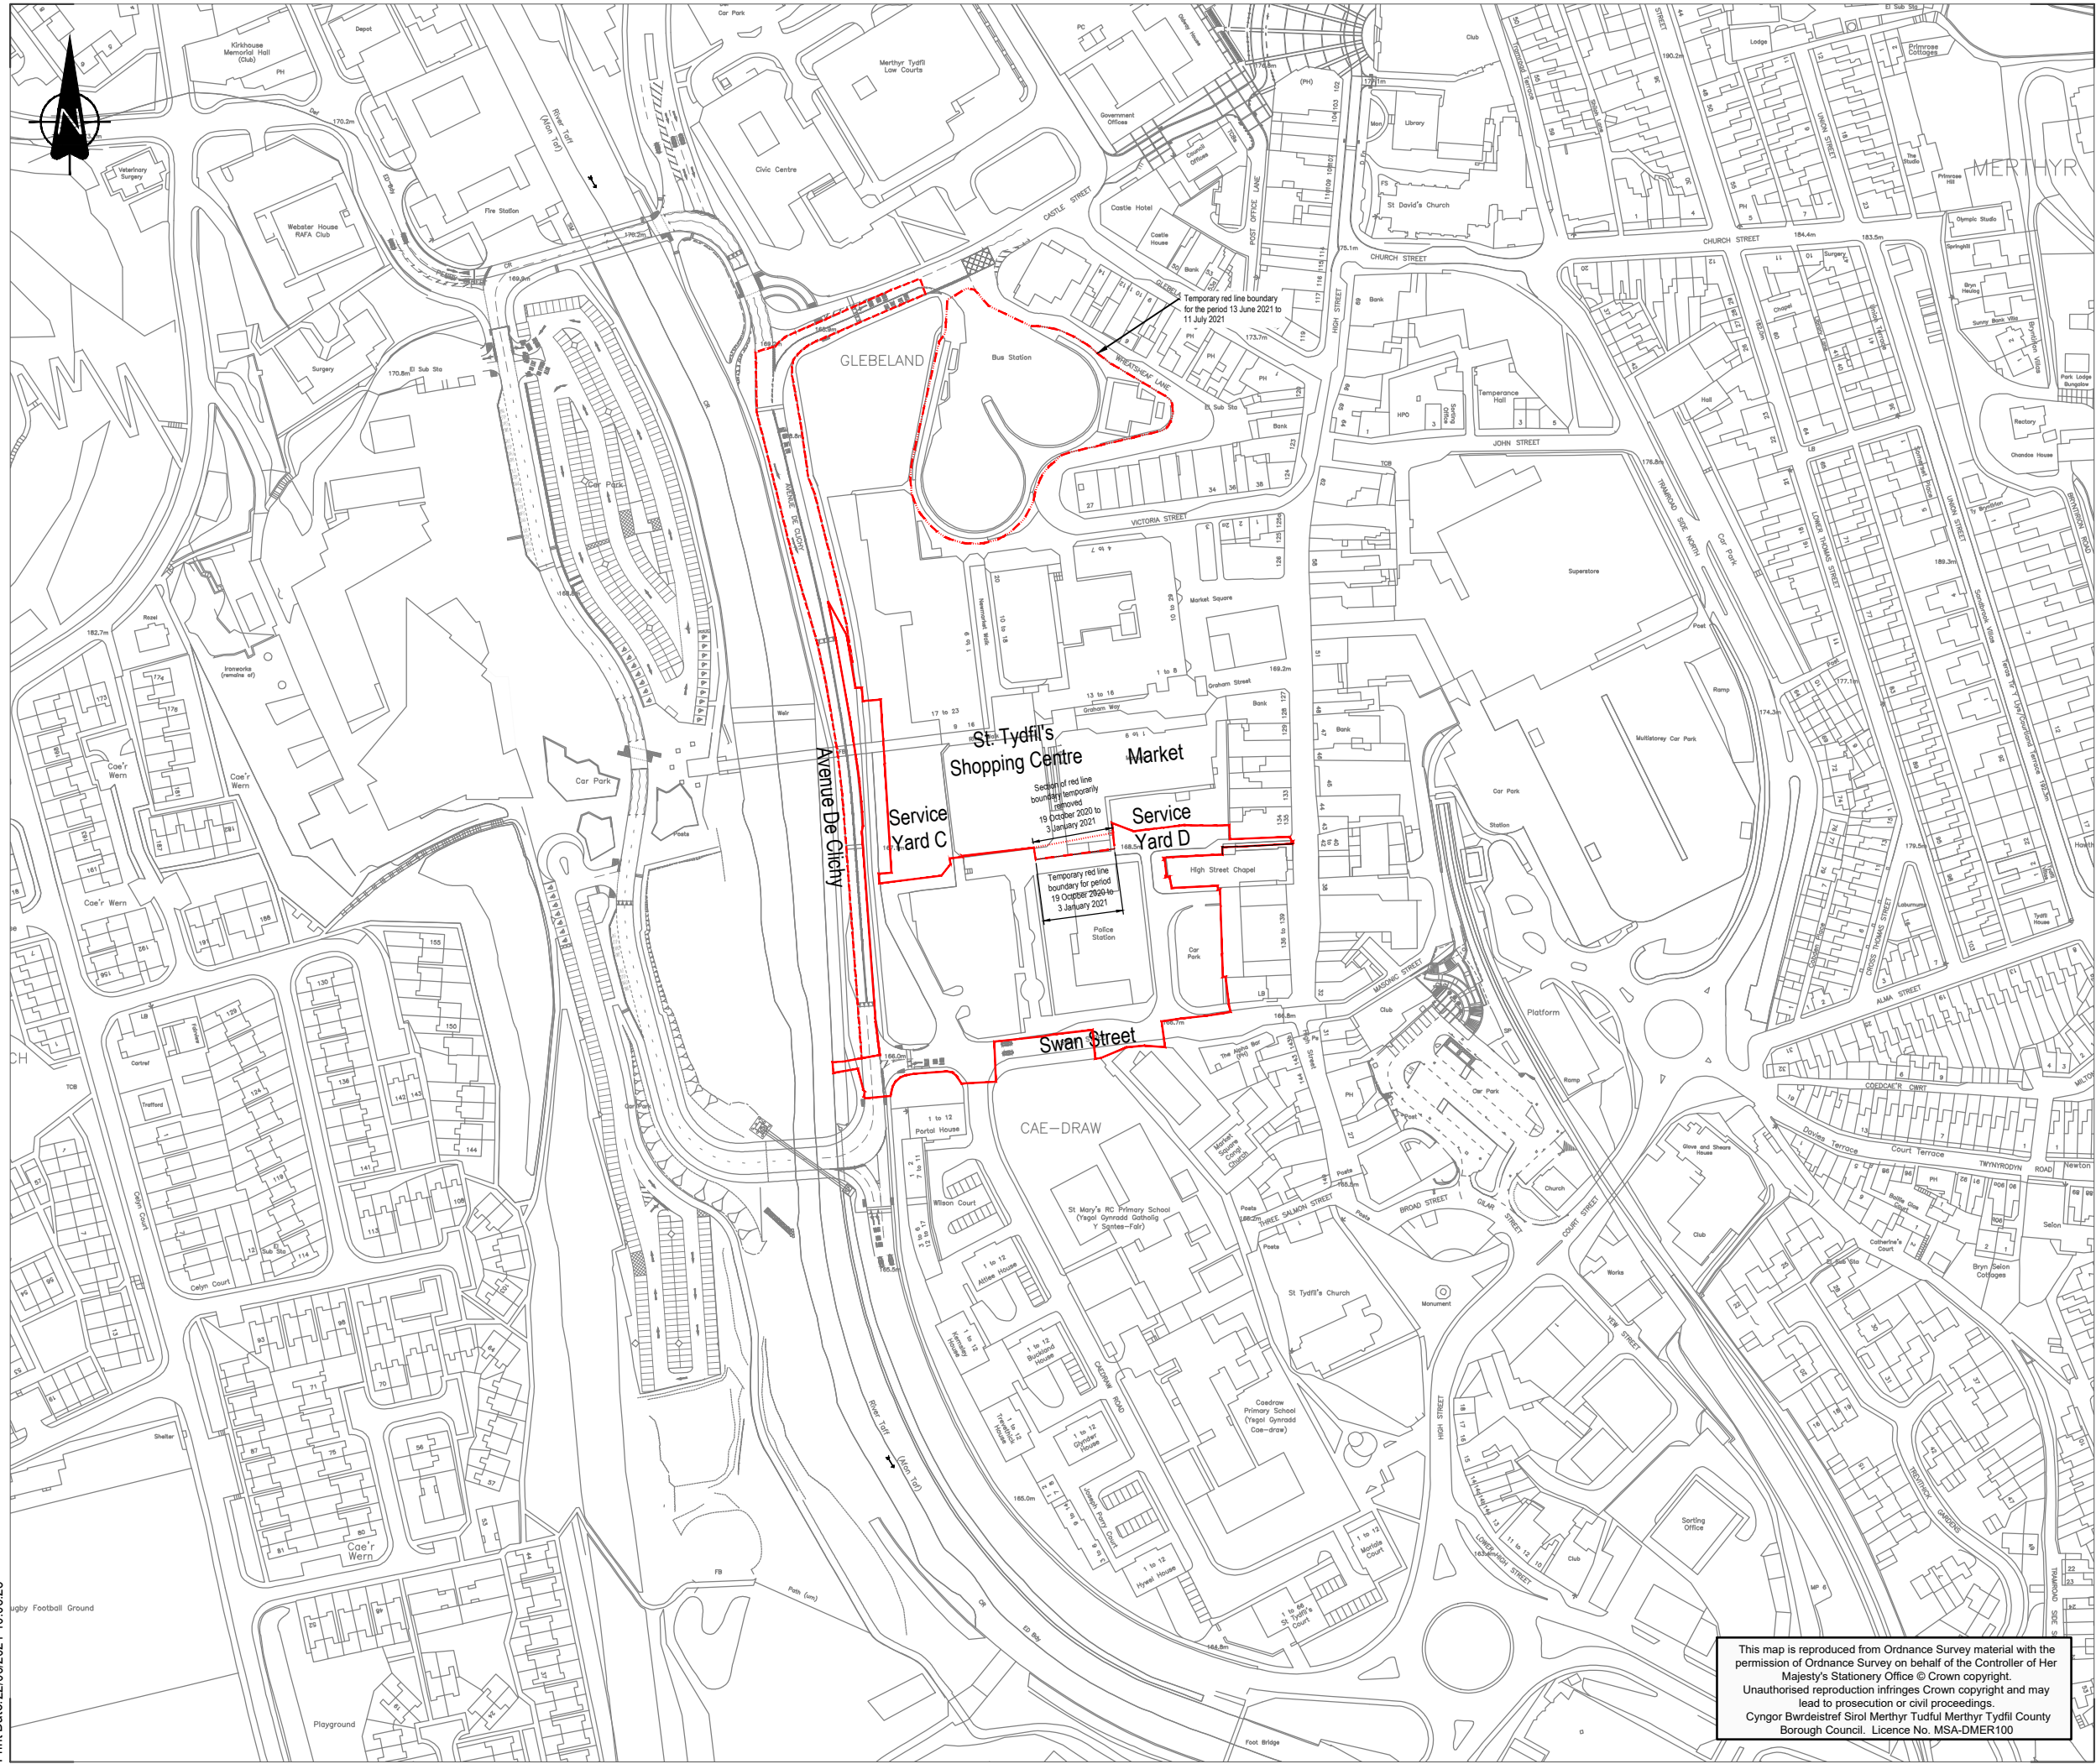

Key:

- Site Boundary
- Site Boundary for additional works to signing and road markings Avenue De Clichy/Castle Street
- Section of red line boundary temporarily removed
- Temporary location of red line boundary

SAFETY, HEALTH AND ENVIRONMENTAL INFORMATION

IN ADDITION TO THE HAZARDS/RISKS NORMALLY ASSOCIATED WITH THE TYPES OF WORK DETAILED ON THIS DRAWING, NOTE THE FOLLOWING

NO SHE HAZARD IDENTIFIED

IT IS ASSUMED THAT ALL WORKS WILL BE CARRIED OUT BY A COMPETENT CONTRACTOR WORKING, WHERE APPROPRIATE, TO AN APPROVED METHOD STATEMENT

C03	MJ	IP	IP	Temporary site boundary added to old bus station	21/06/2021
C02	MJ	IP	IP	Site Boundary temporarily amended.	21/10/2020
C01	MJ	IP	DW	Site boundary amended in area of church	09/07/2019
C00	WH	IP	DW	Construction Issue & site boundary amended	27/06/2019

Rev	Dwn	Chk'd	App'd	Description	Date
-----	-----	-------	-------	-------------	------

Purpose of Issue
A - Suitable for Construction

Classification
Confidential

Client


MERTHYR TYDFIL
County Borough Council
Cynghor Bwrdeistref Sirol
MERTHYR TYDFUL

Project
Merthyr Bus Station

Drawing
Site Boundary
Location Plan

Scale @ A3	Drawn	Checked	Approved
1:2500	MAJ	LM	IP

Project No.	Date
CS/083694	29-Feb-2016

Drawing Identifier	BS1192 Compliant
Project - Originator - Zone - Level - File Type - Role - Number	rev
MBS-CAP-00-XX-DR-C-101	C03

CAPITA

Civil Engineering

St David's House, Pascal Close, St Mellons, Cardiff, CF3 0LW
029 2080 3500
www.capitaproperty.co.uk
Capita Property and infrastructure Ltd.

This map is reproduced from Ordnance Survey material with the permission of Ordnance Survey on behalf of the Controller of Her Majesty's Stationery Office © Crown copyright. Unauthorised reproduction infringes Crown copyright and may lead to prosecution or civil proceedings. Cynghor Bwrdeistref Sirol Merthyr Tydfil County Borough Council. Licence No. MSA-DMER100