
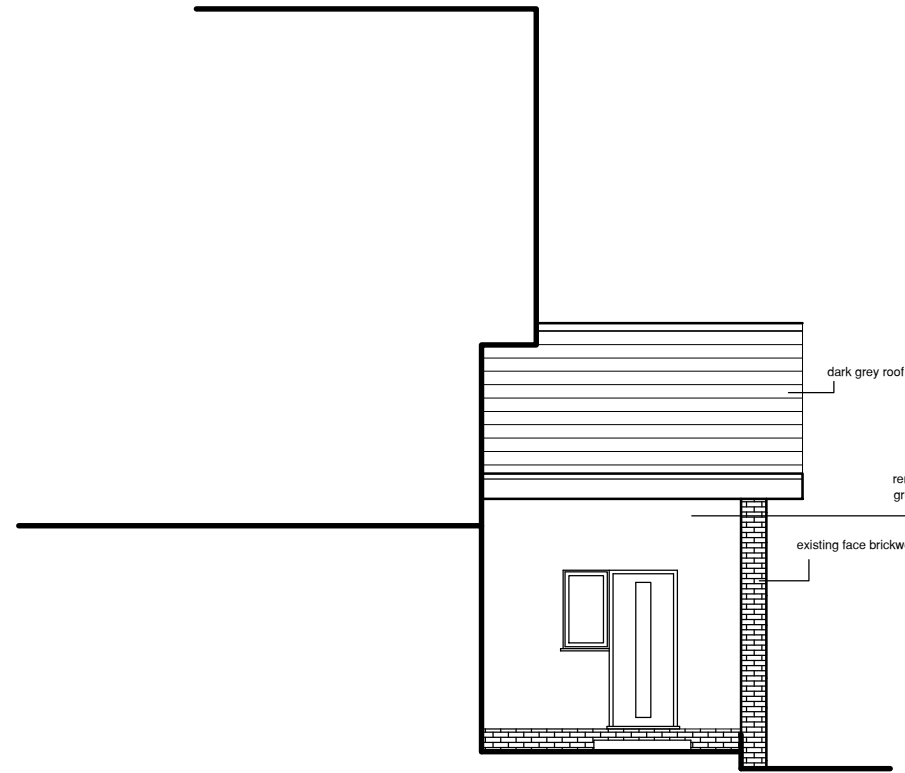
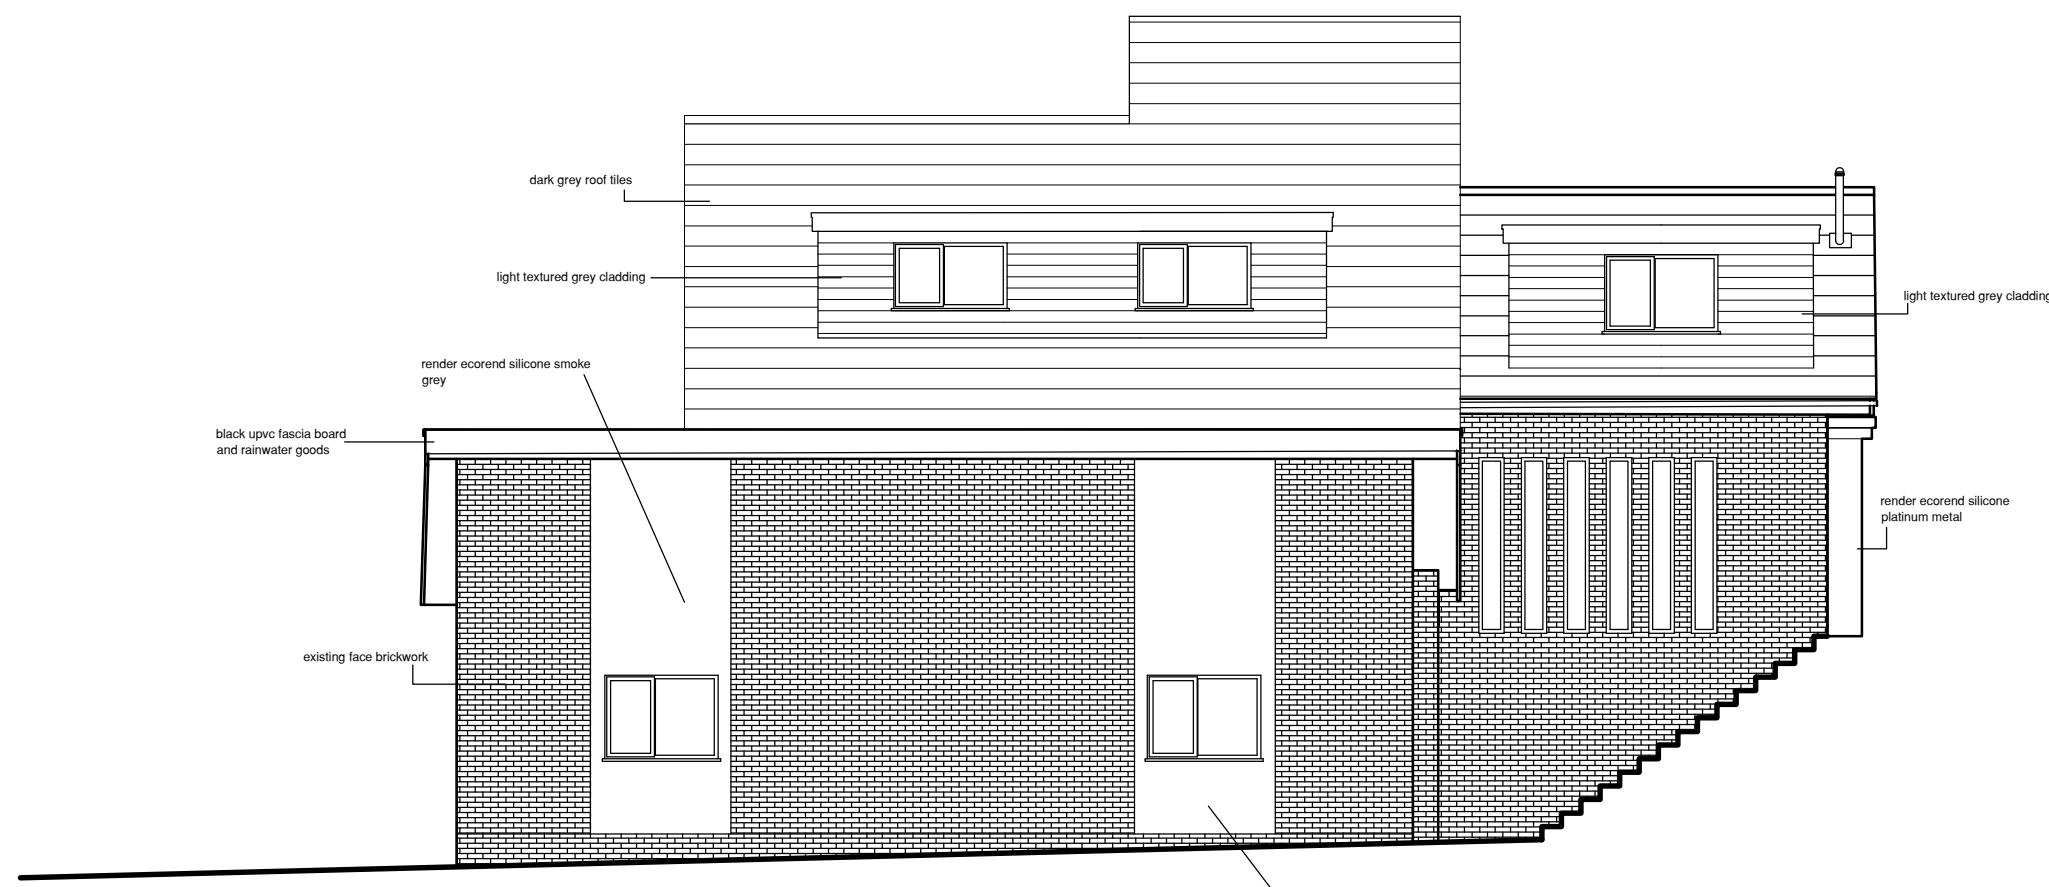
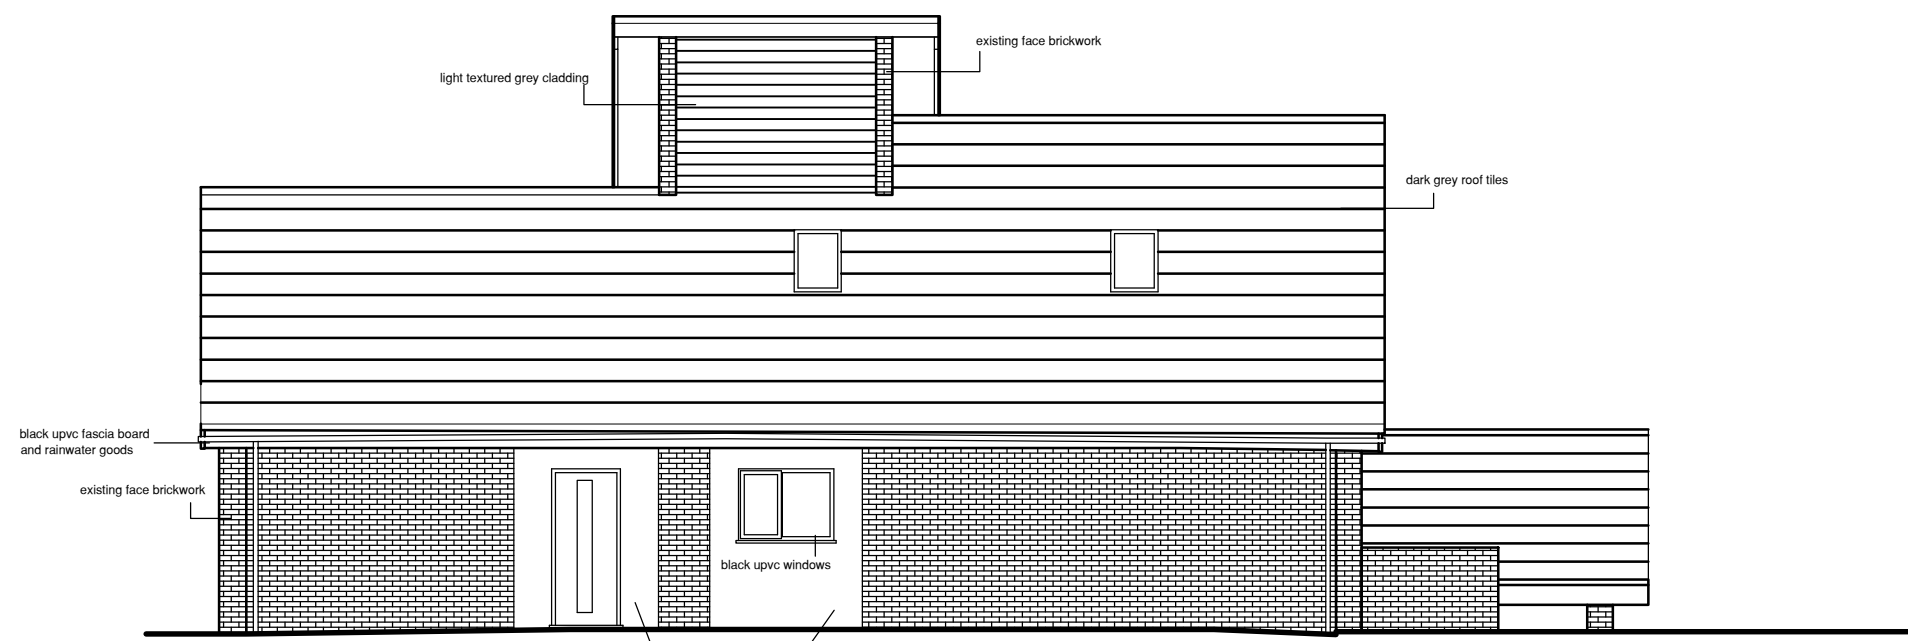
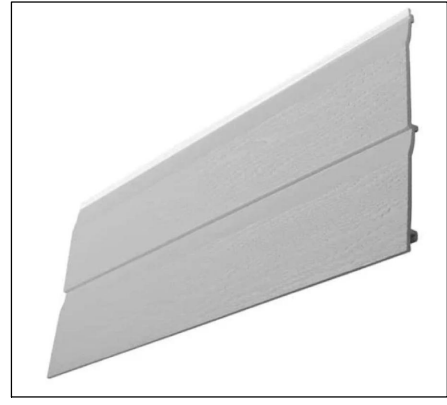
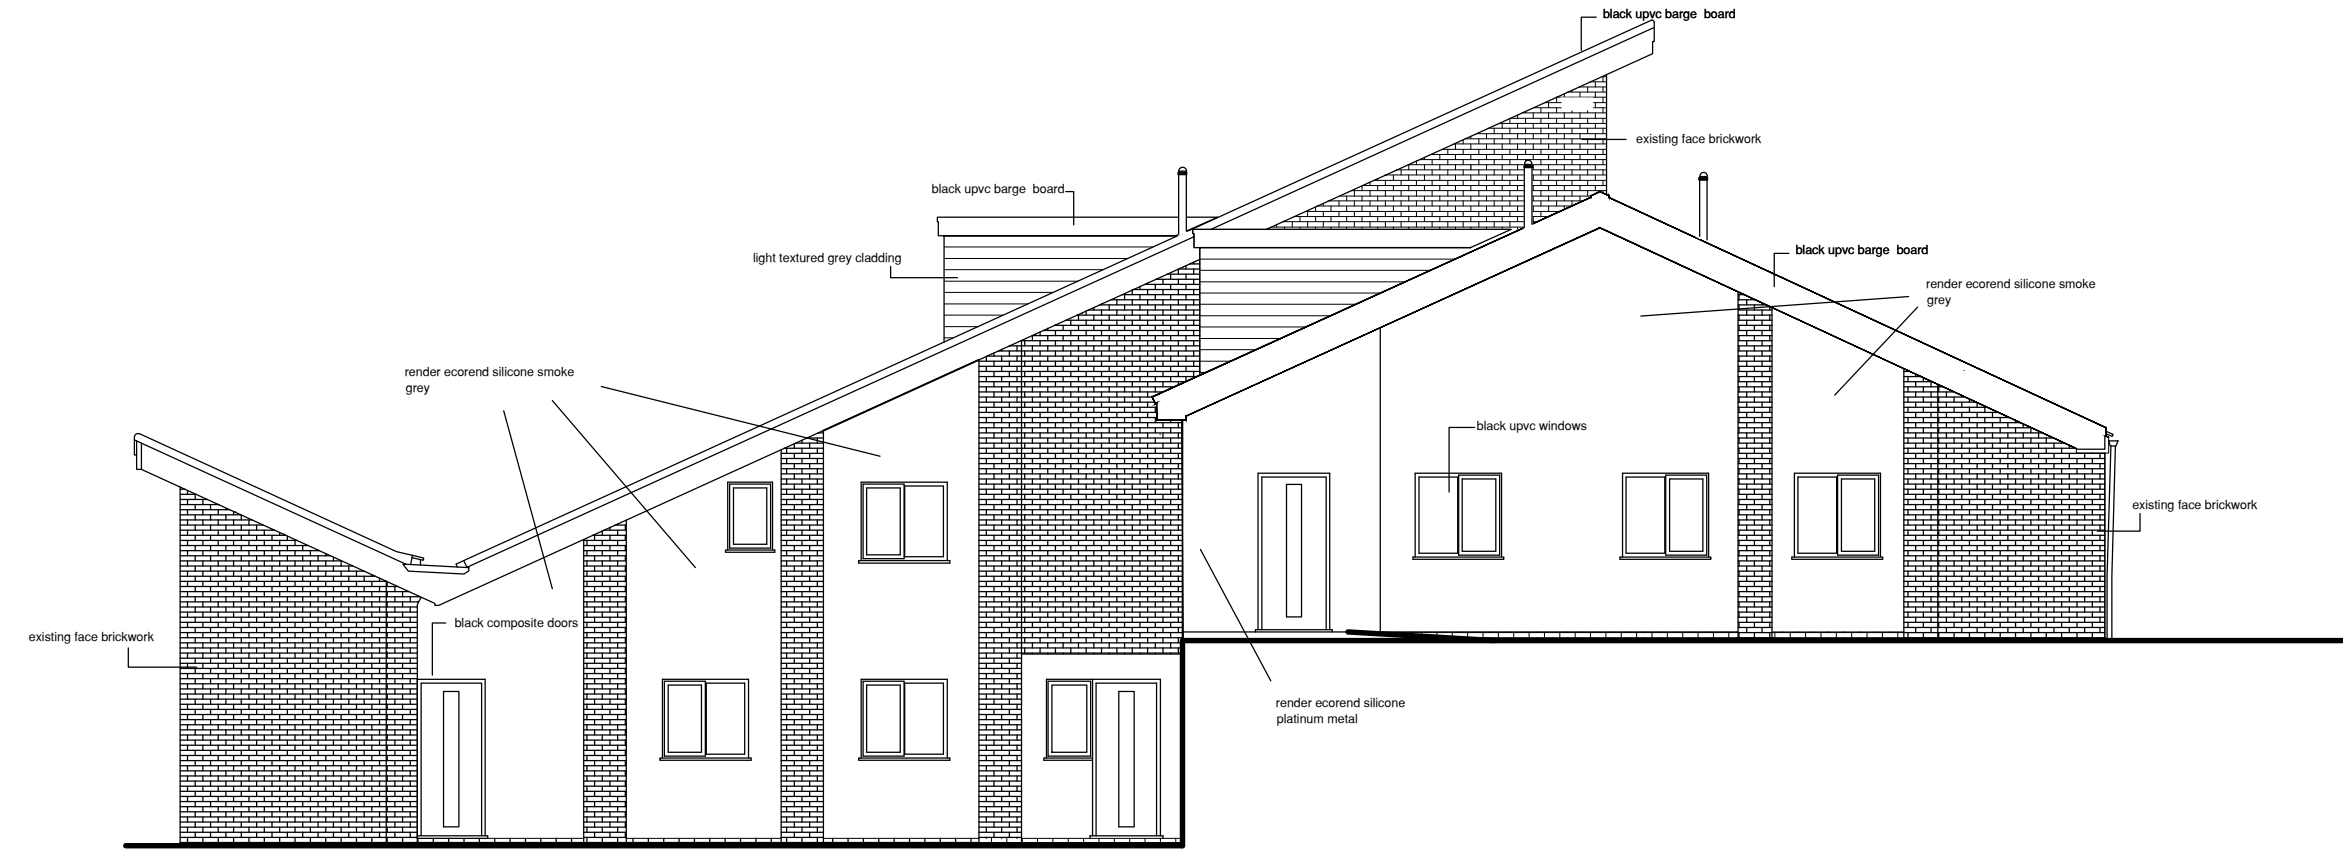


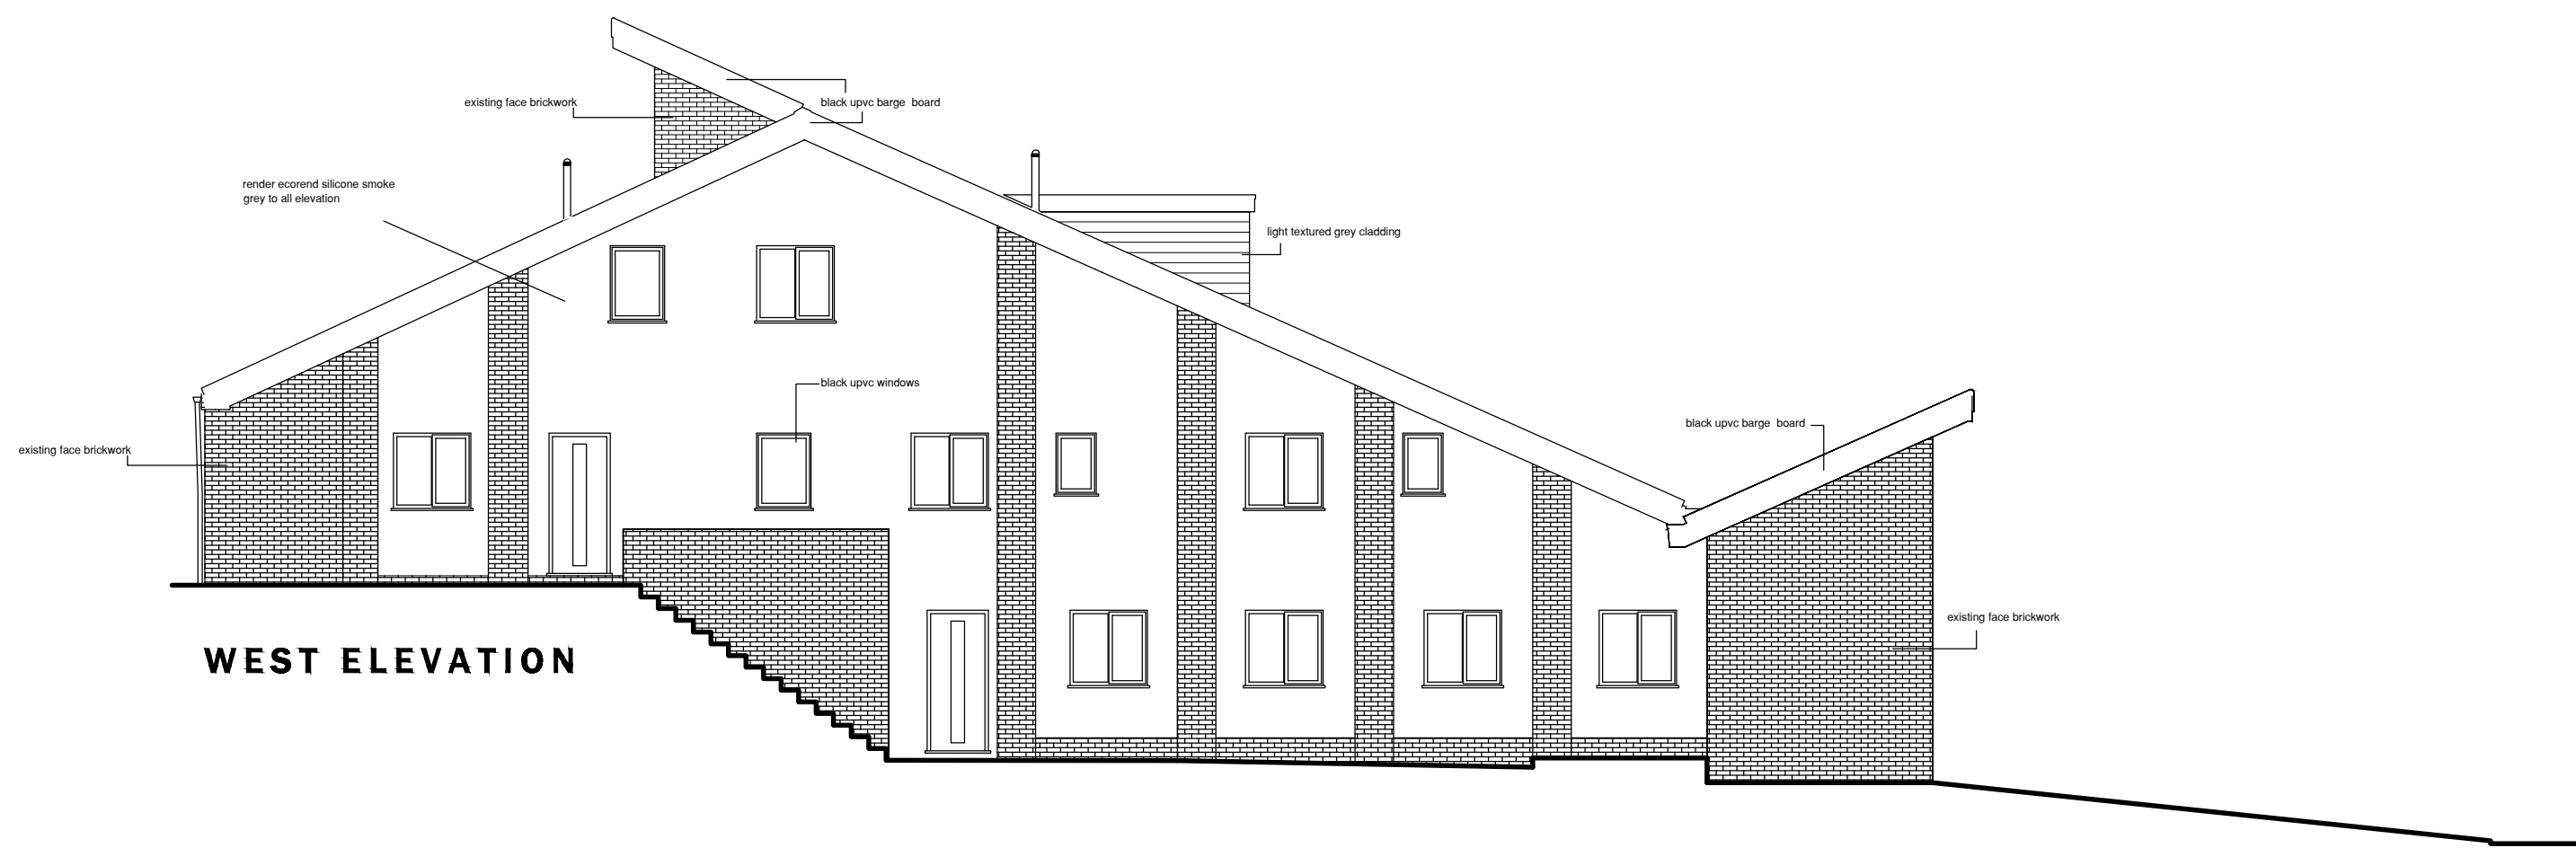

THIS DRAWING IS COPYRIGHT ©

Ken Bateman
Chartered Surveyor
S.S. (Hons) MRICS, C. BALE & WOLFE

project
Former Wesley Chapel
Dowlais
Dowlais

title
As built elevations
indicating materials

Date: April 2024

Scale: A1@ 1:100

Drawn:

Drawing No.

Rev.

Materials 001