
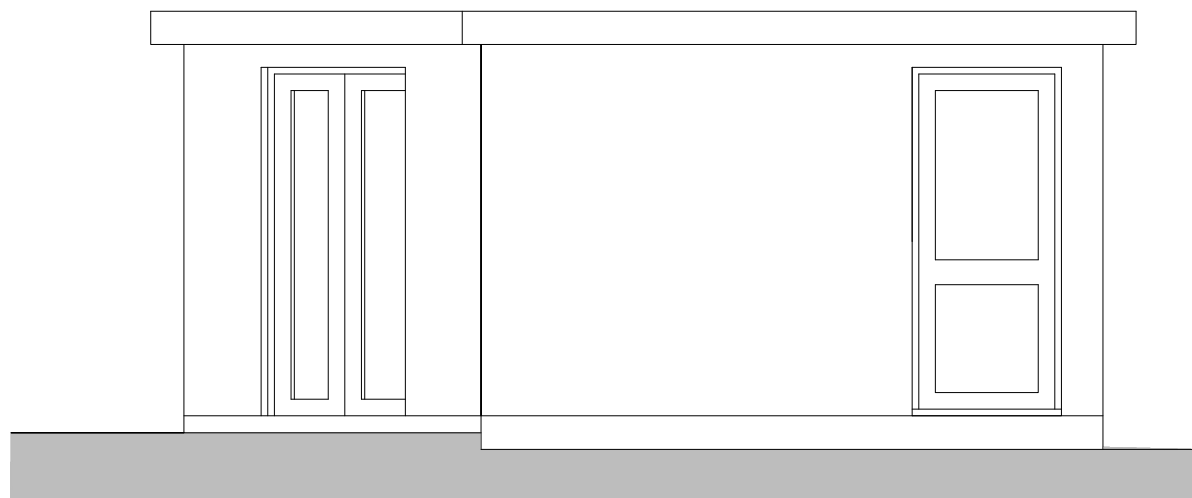
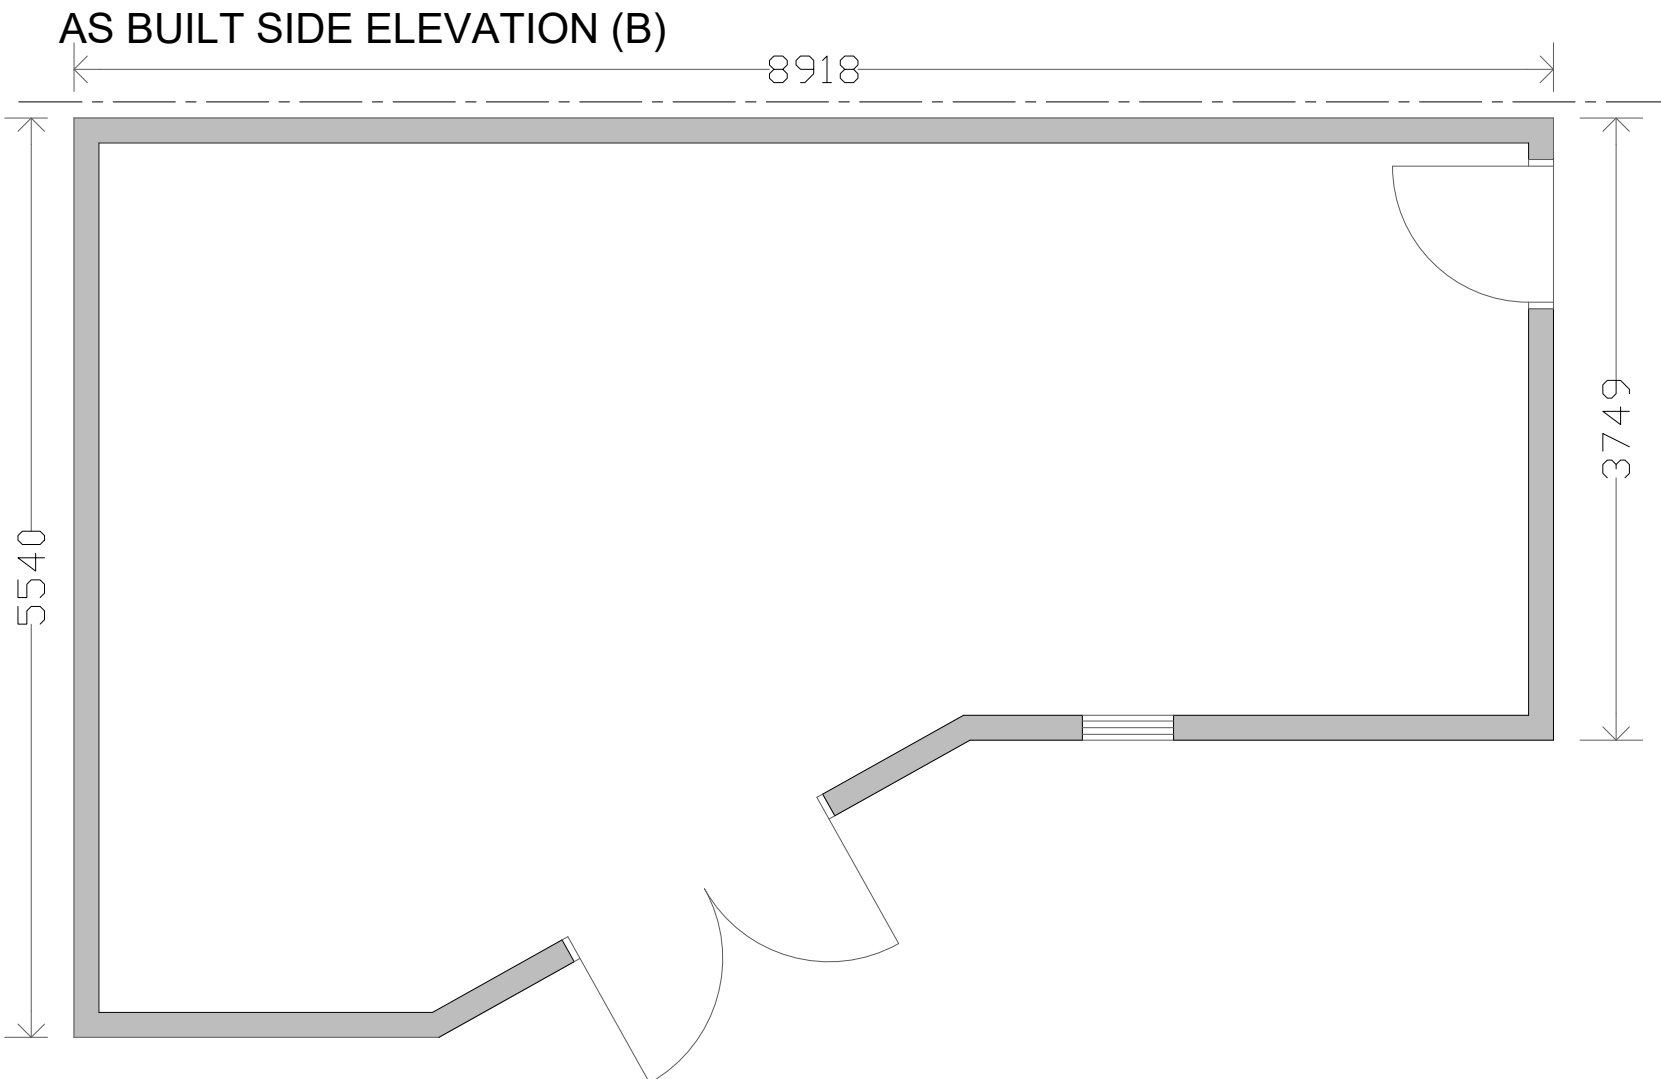
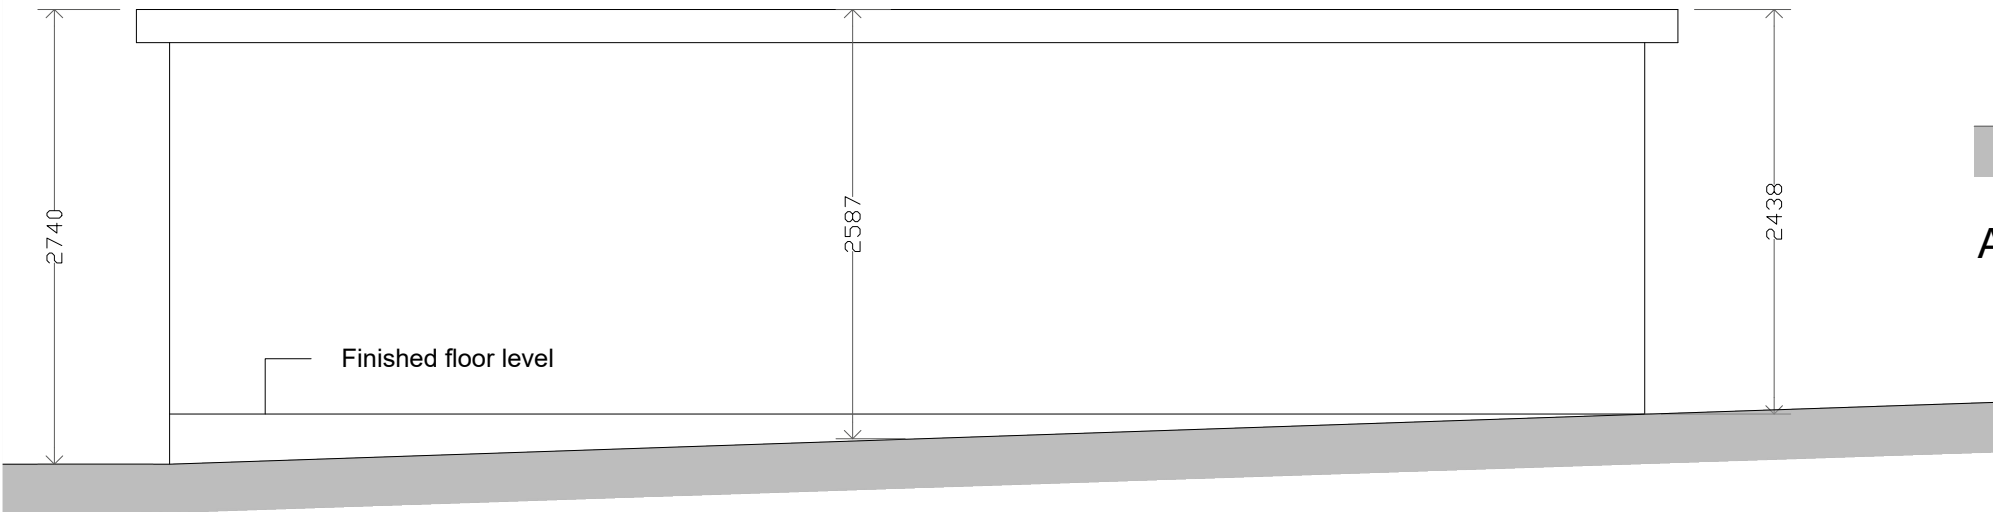
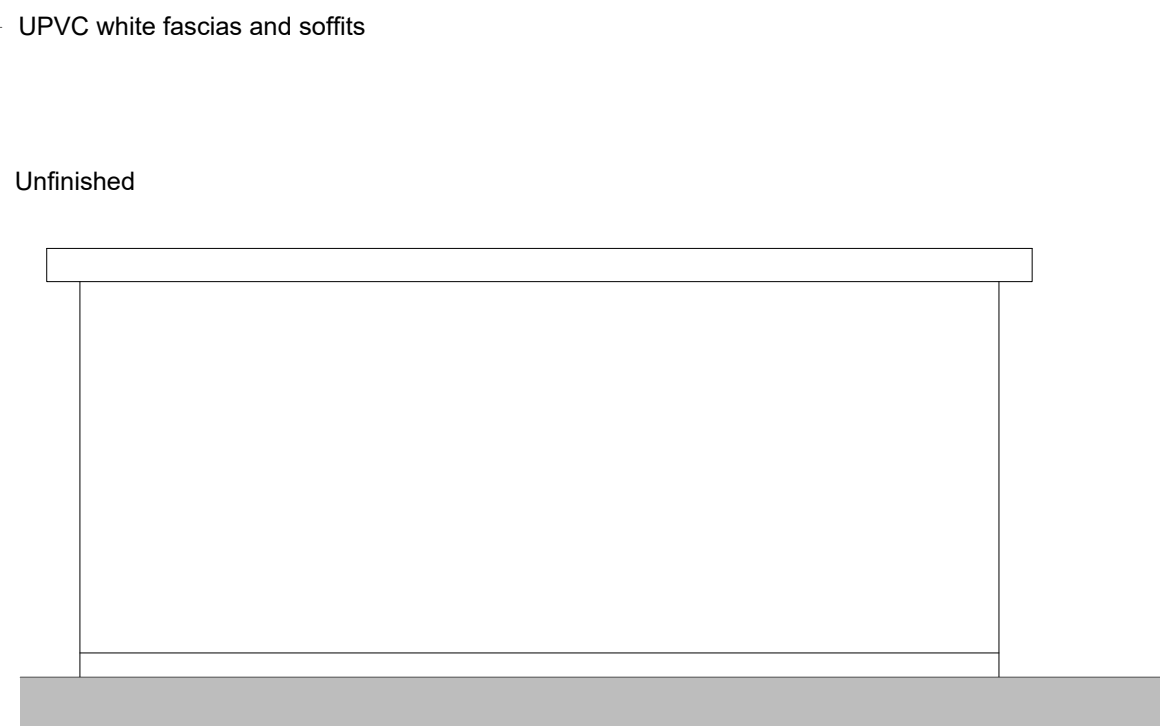


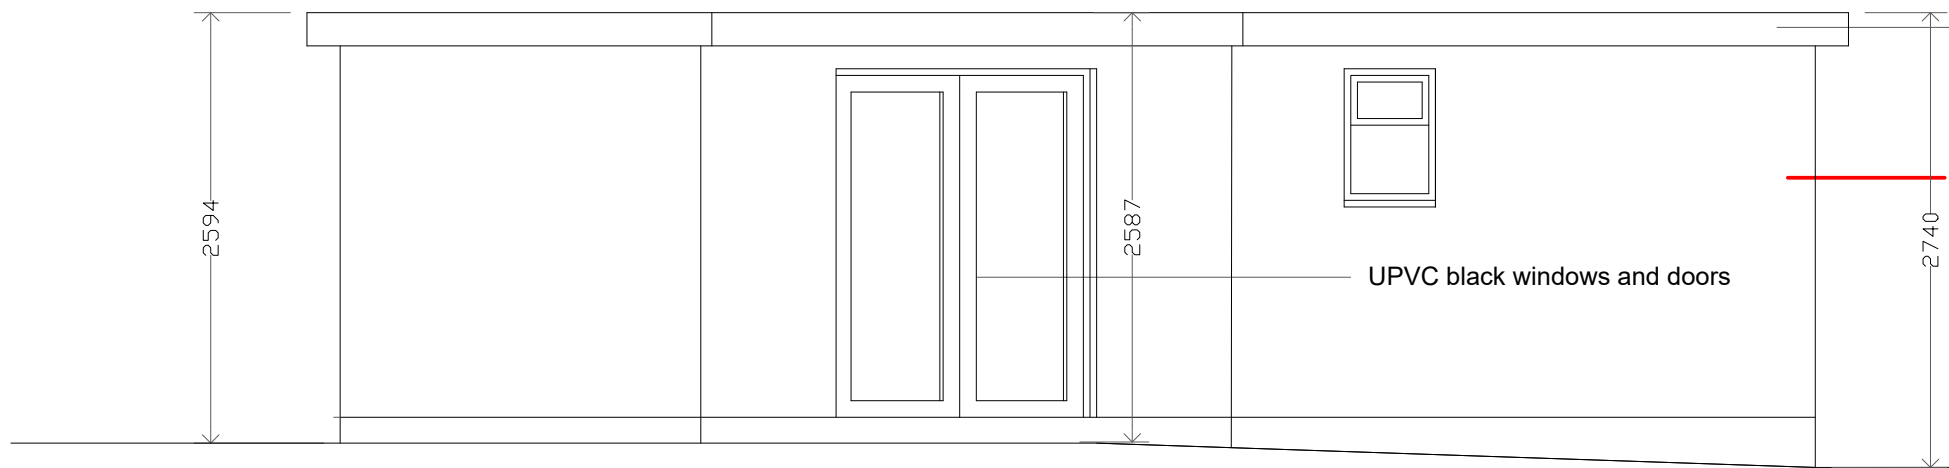

AS BUILT SIDE ELEVATION (A)

AMENDMENTS : A. Additional notation added Nov. 2024

k.j.lloyd AADip. RIBA CHARTERED ARCHITECT		49 Coed Y Pia, LLanbradach Caerphilly, CF83 3PT	
PROJECT	GARDEN OUTBUILDING 84 KINGFISHER CRESCENT MERTHYR TYDFIL CF48 4TL		SCALE 1:50 @ A3
			DATE SEPT 2024
DRAWING	AS BUILT PLAN AND ELEVATIONS		DRAWN KL
			DRG.NO. 01

THIS DRAWING IS COPYRIGHT