
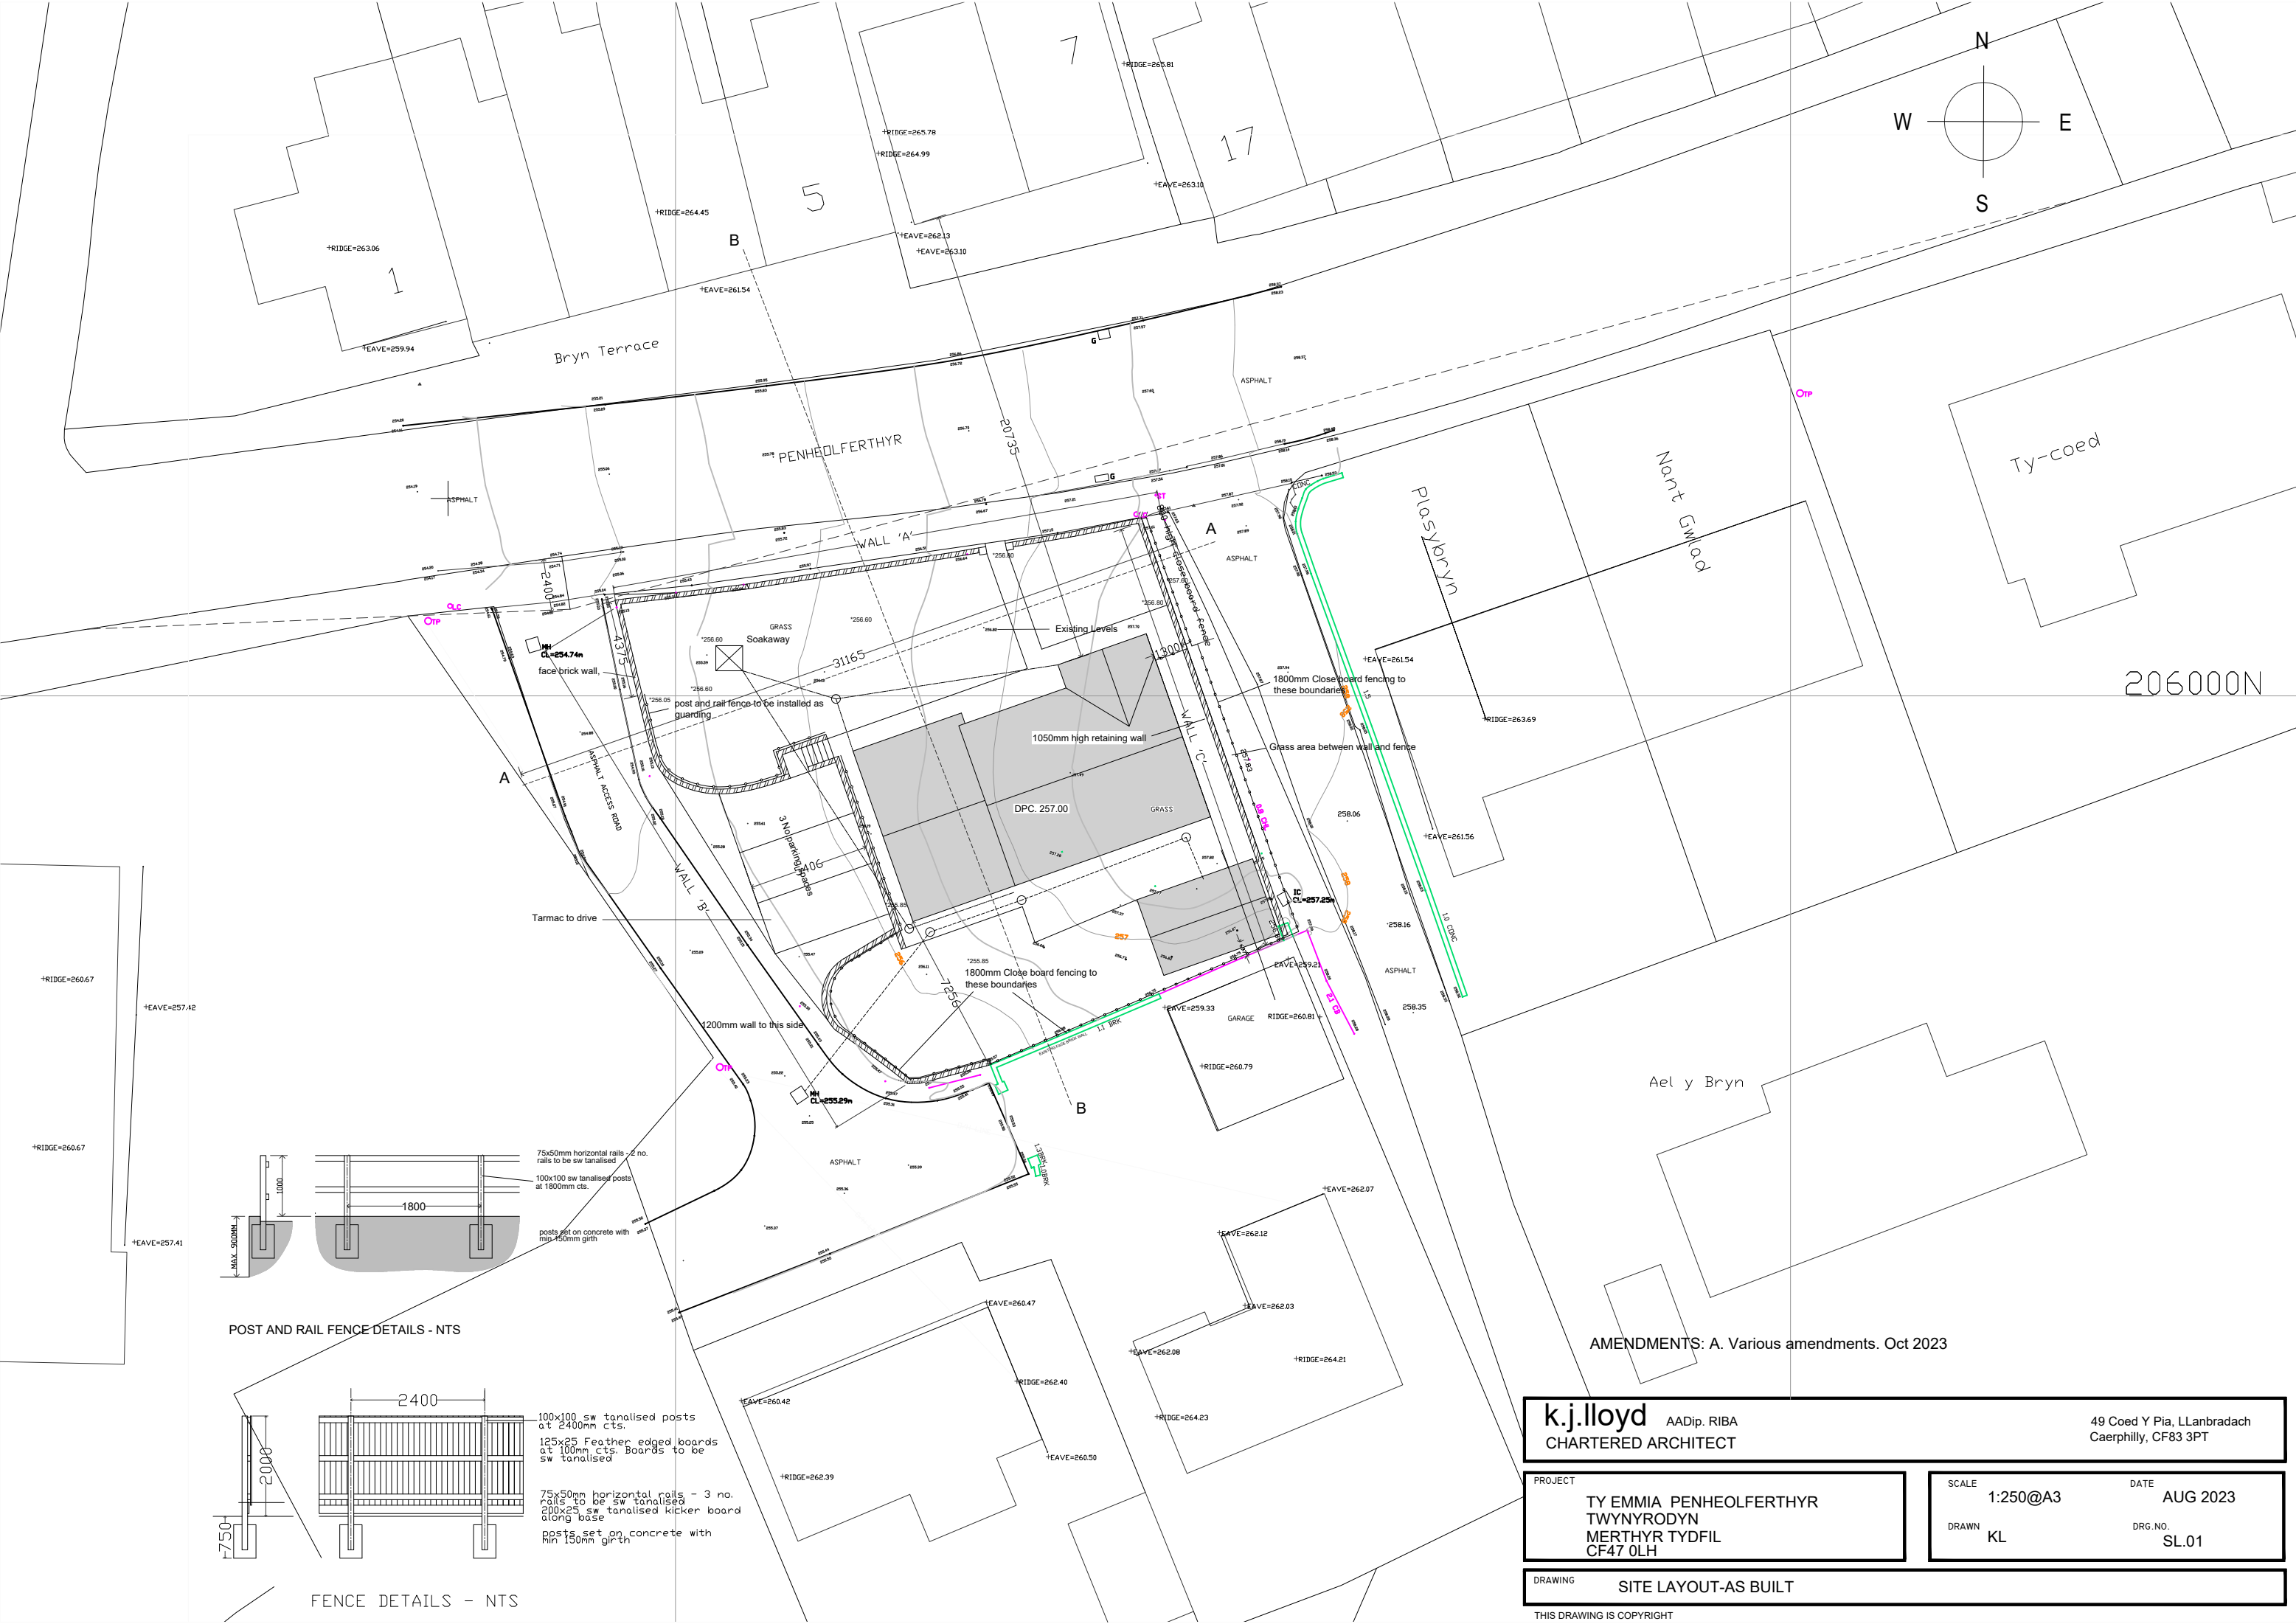
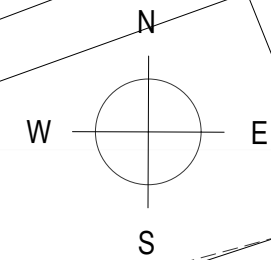


POST AND RAIL FENCE DETAILS - NTS

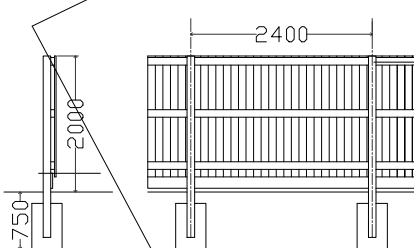

FENCE DETAILS - NTS

k.j.lloyd AADip. RIBA CHARTERED ARCHITECT		49 Coed Y Pia, LLanbradach Caerphilly, CF83 3PT	
PROJECT TY EMMIA PENHEOLFERTHYR TWYNYRODYN MERTHYR TYDFIL CF47 0LH		SCALE 1:250@A3	DATE AUG 2023
DRAWING SITE LAYOUT-AS BUILT		DRAWN KL	DRG. NO. SL.01
AMENDMENTS: A. Various amendments. Oct 2023			
THIS DRAWING IS COPYRIGHT			