



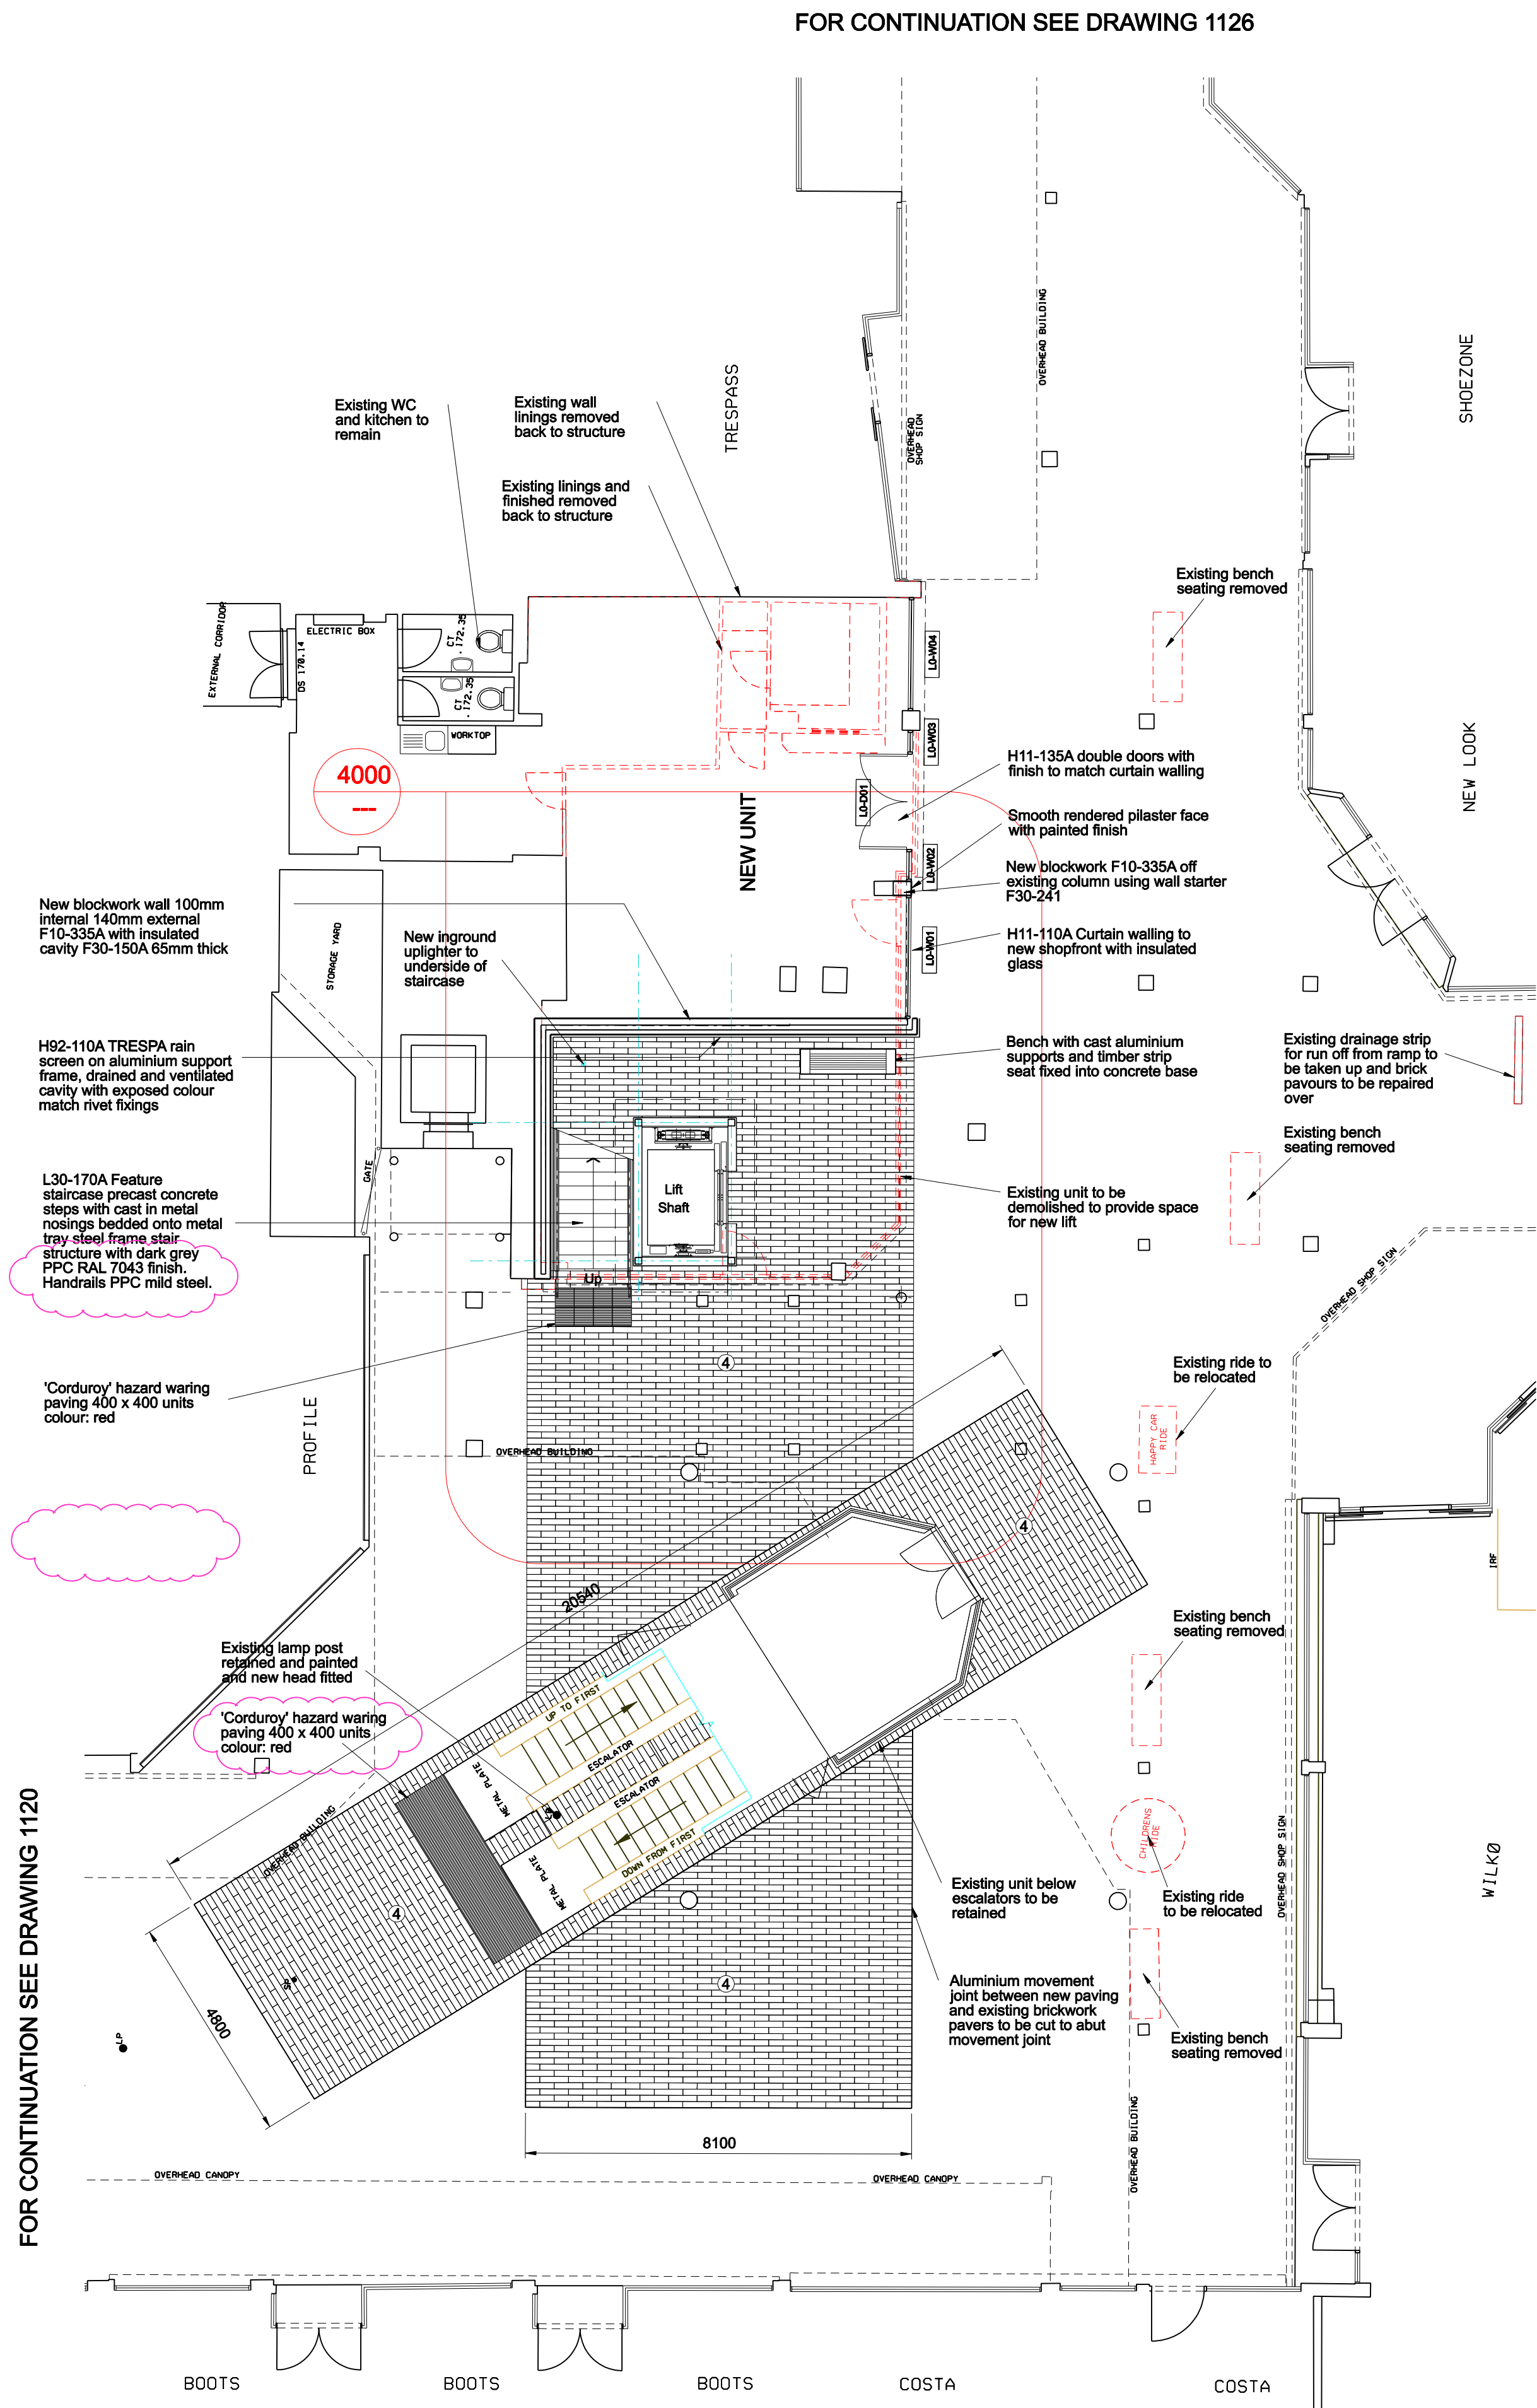

CENTRAL SQUARE - PROPOSED GROUND FLOOR

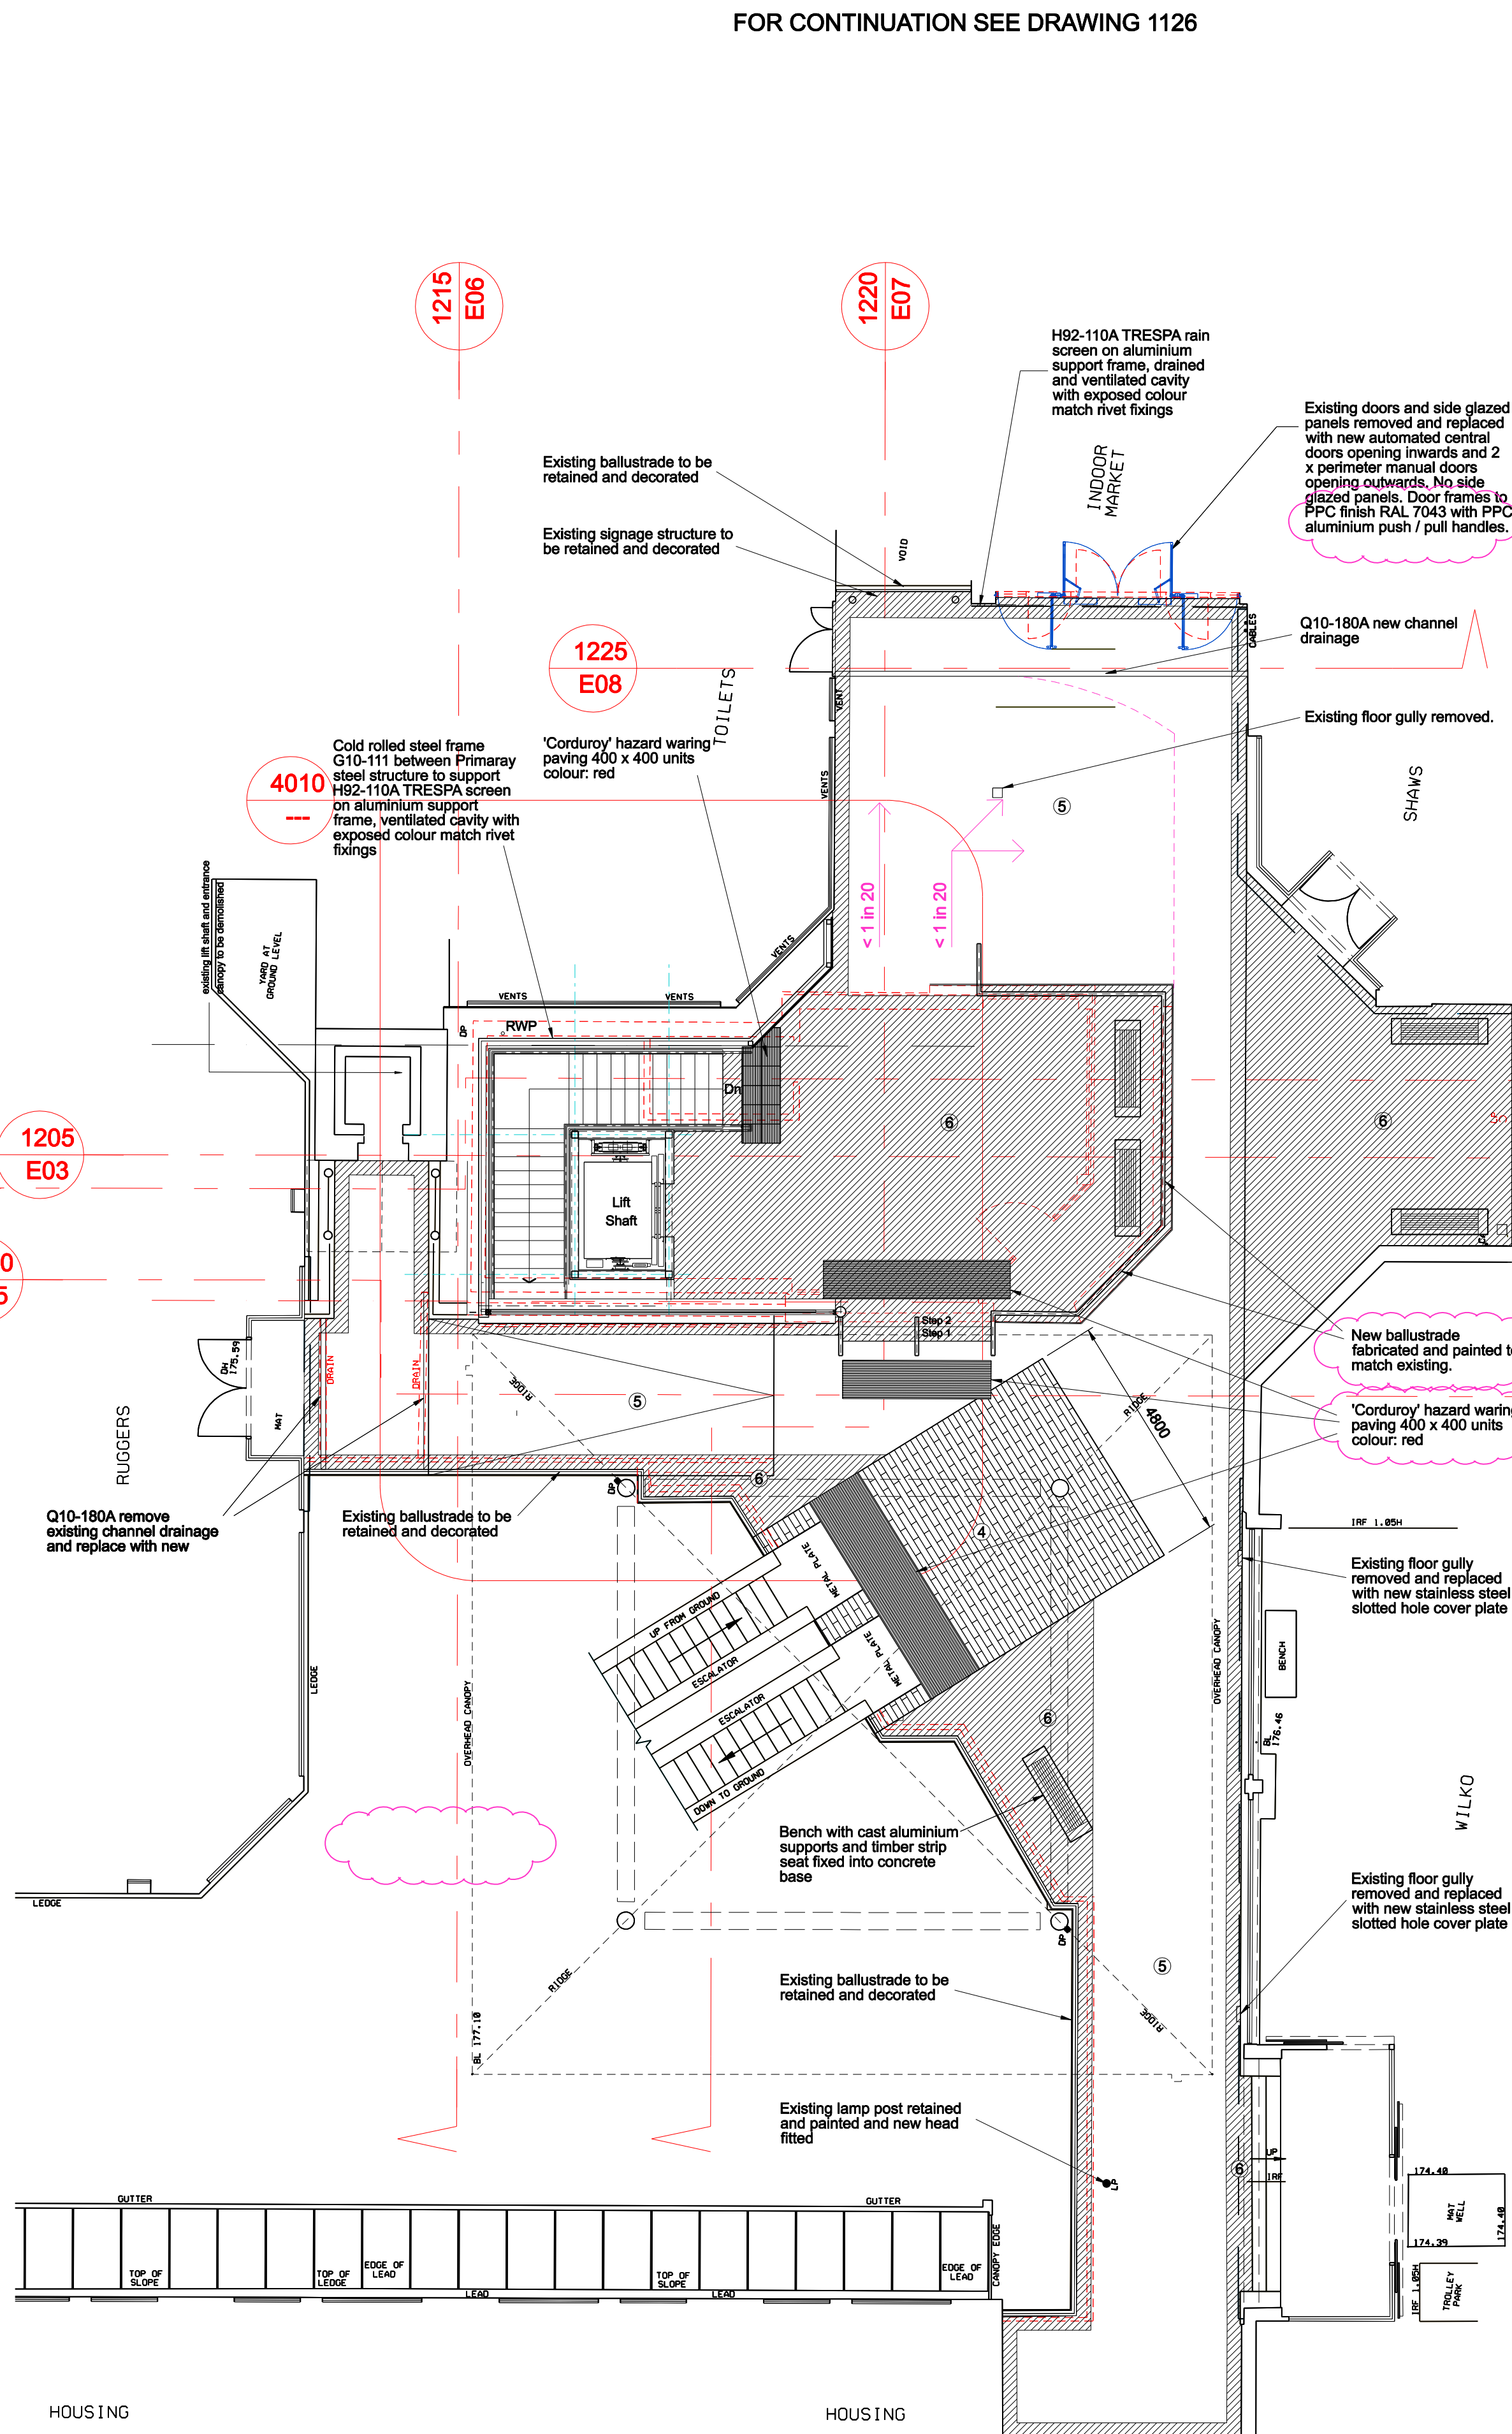


CENTRAL SQUARE - PROPOSED FIRST FLOOR

Revisions		
A	Bench & lamp post notes amended & paving finishes key added.	17 Sep '19
B	'Contract Documents' Drawing Status added. Note referring to scenic lift & new fingerpost sign omitted.	18 Oct '19
C	Steps & ramped access to raised area adjacent to the lift / staircase on first floor added. Marshalls Conservation paving added to first floor in lieu of Modal paving.	29 Apr '20
D	Lift and stair details and adjacent raised area to first floor updated. Paving reference 6 colour changed to Charcoal. 'Corduroy' paving added to top and bottom of escalators. Note referring to new escalators omitted.	16 Jun '20

DIMENSIONS ARE NOT TO BE SCALED FROM THIS DRAWING
THIS DRAWING IS COPYRIGHT

CONSTRUCTION RISK
HI NUMBER

NOTE:
THIS DRAWING HAS BEEN PRODUCED FROM THIRD PARTY INFORMATION AND IS NOT AN AS BUILT DRAWING.
THIS DRAWING IS ONLY A REPRESENTATION AND THEREFORE DISCREPANCIES MAY BE PRESENT. ALL DIMENSIONS ARE APPROXIMATE ONLY.
IT IS RECOMMENDED THAT A DETAILED SURVEY IS COMMISSIONED PRIOR TO ANY FUTURE DESIGN WORK.

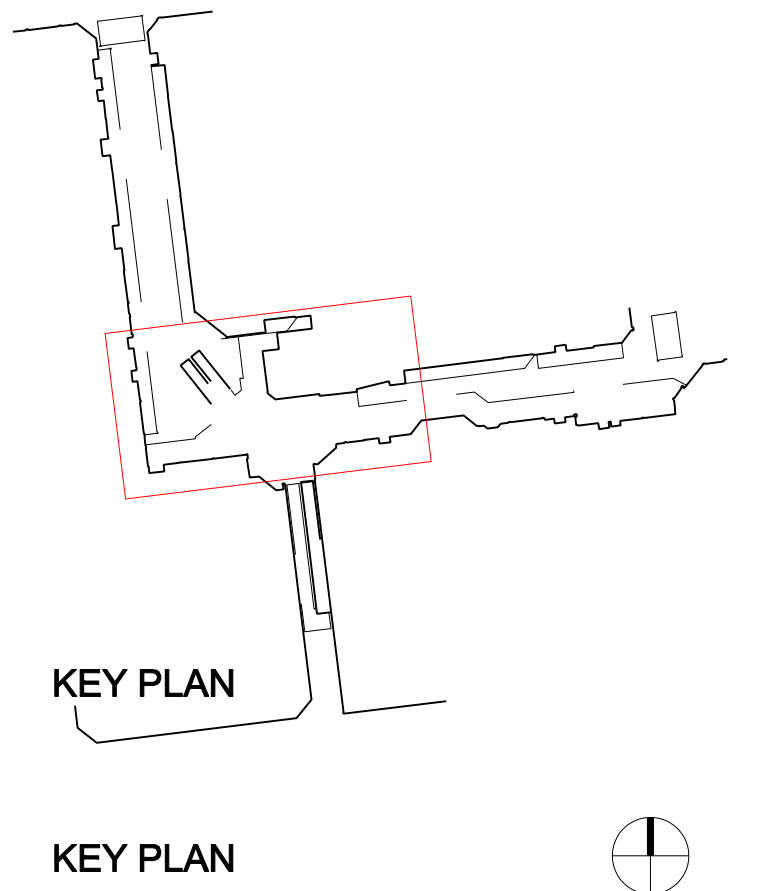

NOTE: ALL NEW FIRST FLOOR PAVING AREAS TO INCLUDE NEW TANKING TO STRUCTURAL DECK

- FINISHES :-
- PAVING -
- ④ MARSHALLS - MODAL
- COLOURS: LIGHT GRANITE, LIGHT CREAM GRANITE AND MID GREY GRANITE, COLOURS LAID RANDOMLY IN STRETCHER BOND PATTERN
- LENGTH 600mm
- WIDTH 300mm
 - ⑤ MARSHALLS - CONSERVATION TEXTURED
- COLOUR: SILVER GREY
LAID IN STRETCHER BOND PATTERN
- LENGTH 900mm
- WIDTH 300mm
 - ⑥ MARSHALLS - CONSERVATION TEXTURED
- COLOURS: CHARCOAL
LAID IN STRETCHER BOND PATTERN
- LENGTH 900mm
- WIDTH 300mm

pentan architects 22 Cathedral Road Cardiff CF11 9LJ t: 029 2030 9010 info@pentan.co.uk	Project ST TYDFIL SHOPPING CENTRE	Date MAR '19
	Client R & M WILLIAMS	Scale 1:100 @ A1
	Drawing Title PROPOSED CENTRAL SQUARE GROUND & FIRST FLOOR PLAN	Drawing No. 3779_A_1122
		Rev. D

NOTES: Do not scale. All dimensions are in millimetres unless stated otherwise