


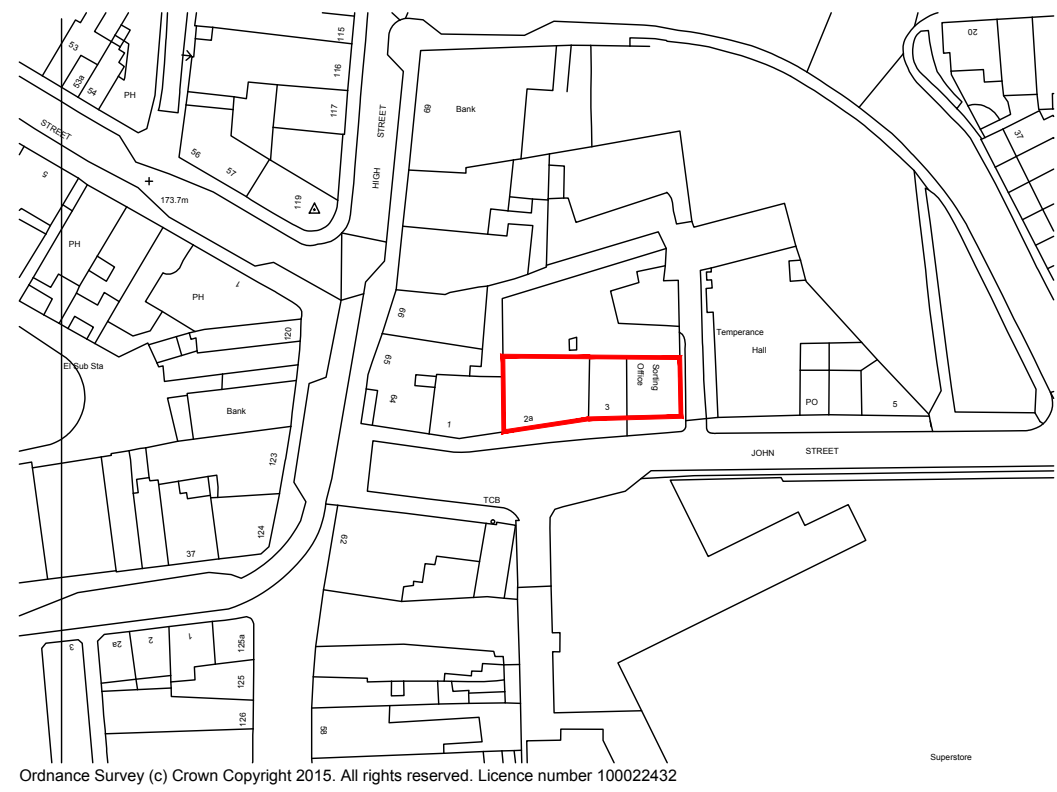

SITE LOCATION PLAN
Scale 1:1250



Existing dorma windows with
UPVC casment windows

Existing "Velux" roof
windows to remain

Installed UPVC casment
windows with bottom opener
to mimic timber sash
windows in existing opening

Existing timber windows
and doors to remain

Installed UPVC casment
windows with bottom opener
to mimic timber sash
windows in existing opening

Installed UPVC casment
windows with bottom opener
to mimic timber sash
windows in existing opening

EXISTING / AS BUILT ELEVATION
Scale 1:75

New flush fit casement
windows

Existing "Velux" roof
windows to remain

Proposed UPVC sliding
sash windows in existing
openings

Existing timber windows
and doors to remain

Proposed UPVC sliding
sash windows in existing
openings

Proposed UPVC sliding
sash windows in existing
openings

Proposed Post office
frontage to remain

PROPOSED ELEVATION
Scale 1:75

NOTES

- 1) All dimensions in millimeters Unless otherwise noted.
- 2) Drawings intended for purposes as described.
- 3) Any discrepancies to be brought to the attention of RPD Building Consultants immediately.
- 4) Do not scale off this drawing for construction purposes
- 5) This drawing is to read in conjunction with RPD Building Consultants construction notes.

© This Drawing is copyright
It must not be reproduced or disclosed to
third parties without the permission of
RPD.

LEGEND

	Existing wall to remain
	Proposed wall
	Removed wall
	Steel beam / feature over
	Existing underground drainage pipe
	Existing above ground waste pipe
	Proposed underground drainage pipe
	Existing fuse board
	Existing boiler
	Existing gas / electric meter
	Existing incoming water stop tap

DESCRIPTION
Dorma windows to be replaced confirmed

DATE
Nov
23

REVISION
A

PROJECT / SITE ADDRESS / CLIENT

PROPOSED REPLACEMENT WINDOWS
2 & 3 JOHN STREET, MERTHYR TYDFIL
CF47 0AE

MR M PRICE

DRAWING TITLE

SITE LOCATION PLAN
EXISTING, AS BUILT & PROPOSED
FRONT ELEVATION

DETAILS

Scales	As shown @ A1	Date	JUL 23
Drawn	RPD	Checked	CMP
Job No.	JS2	Drawing No.	01
Status	Construction	Revision	A



RPD BUILDING CONSULTANTS LIMITED
61 WESTERN AVENUE, NEWPORT, NP20 3QZ
T - 01633 677514 W - www.rpd.uk.com E - richard@rpd.uk.com