




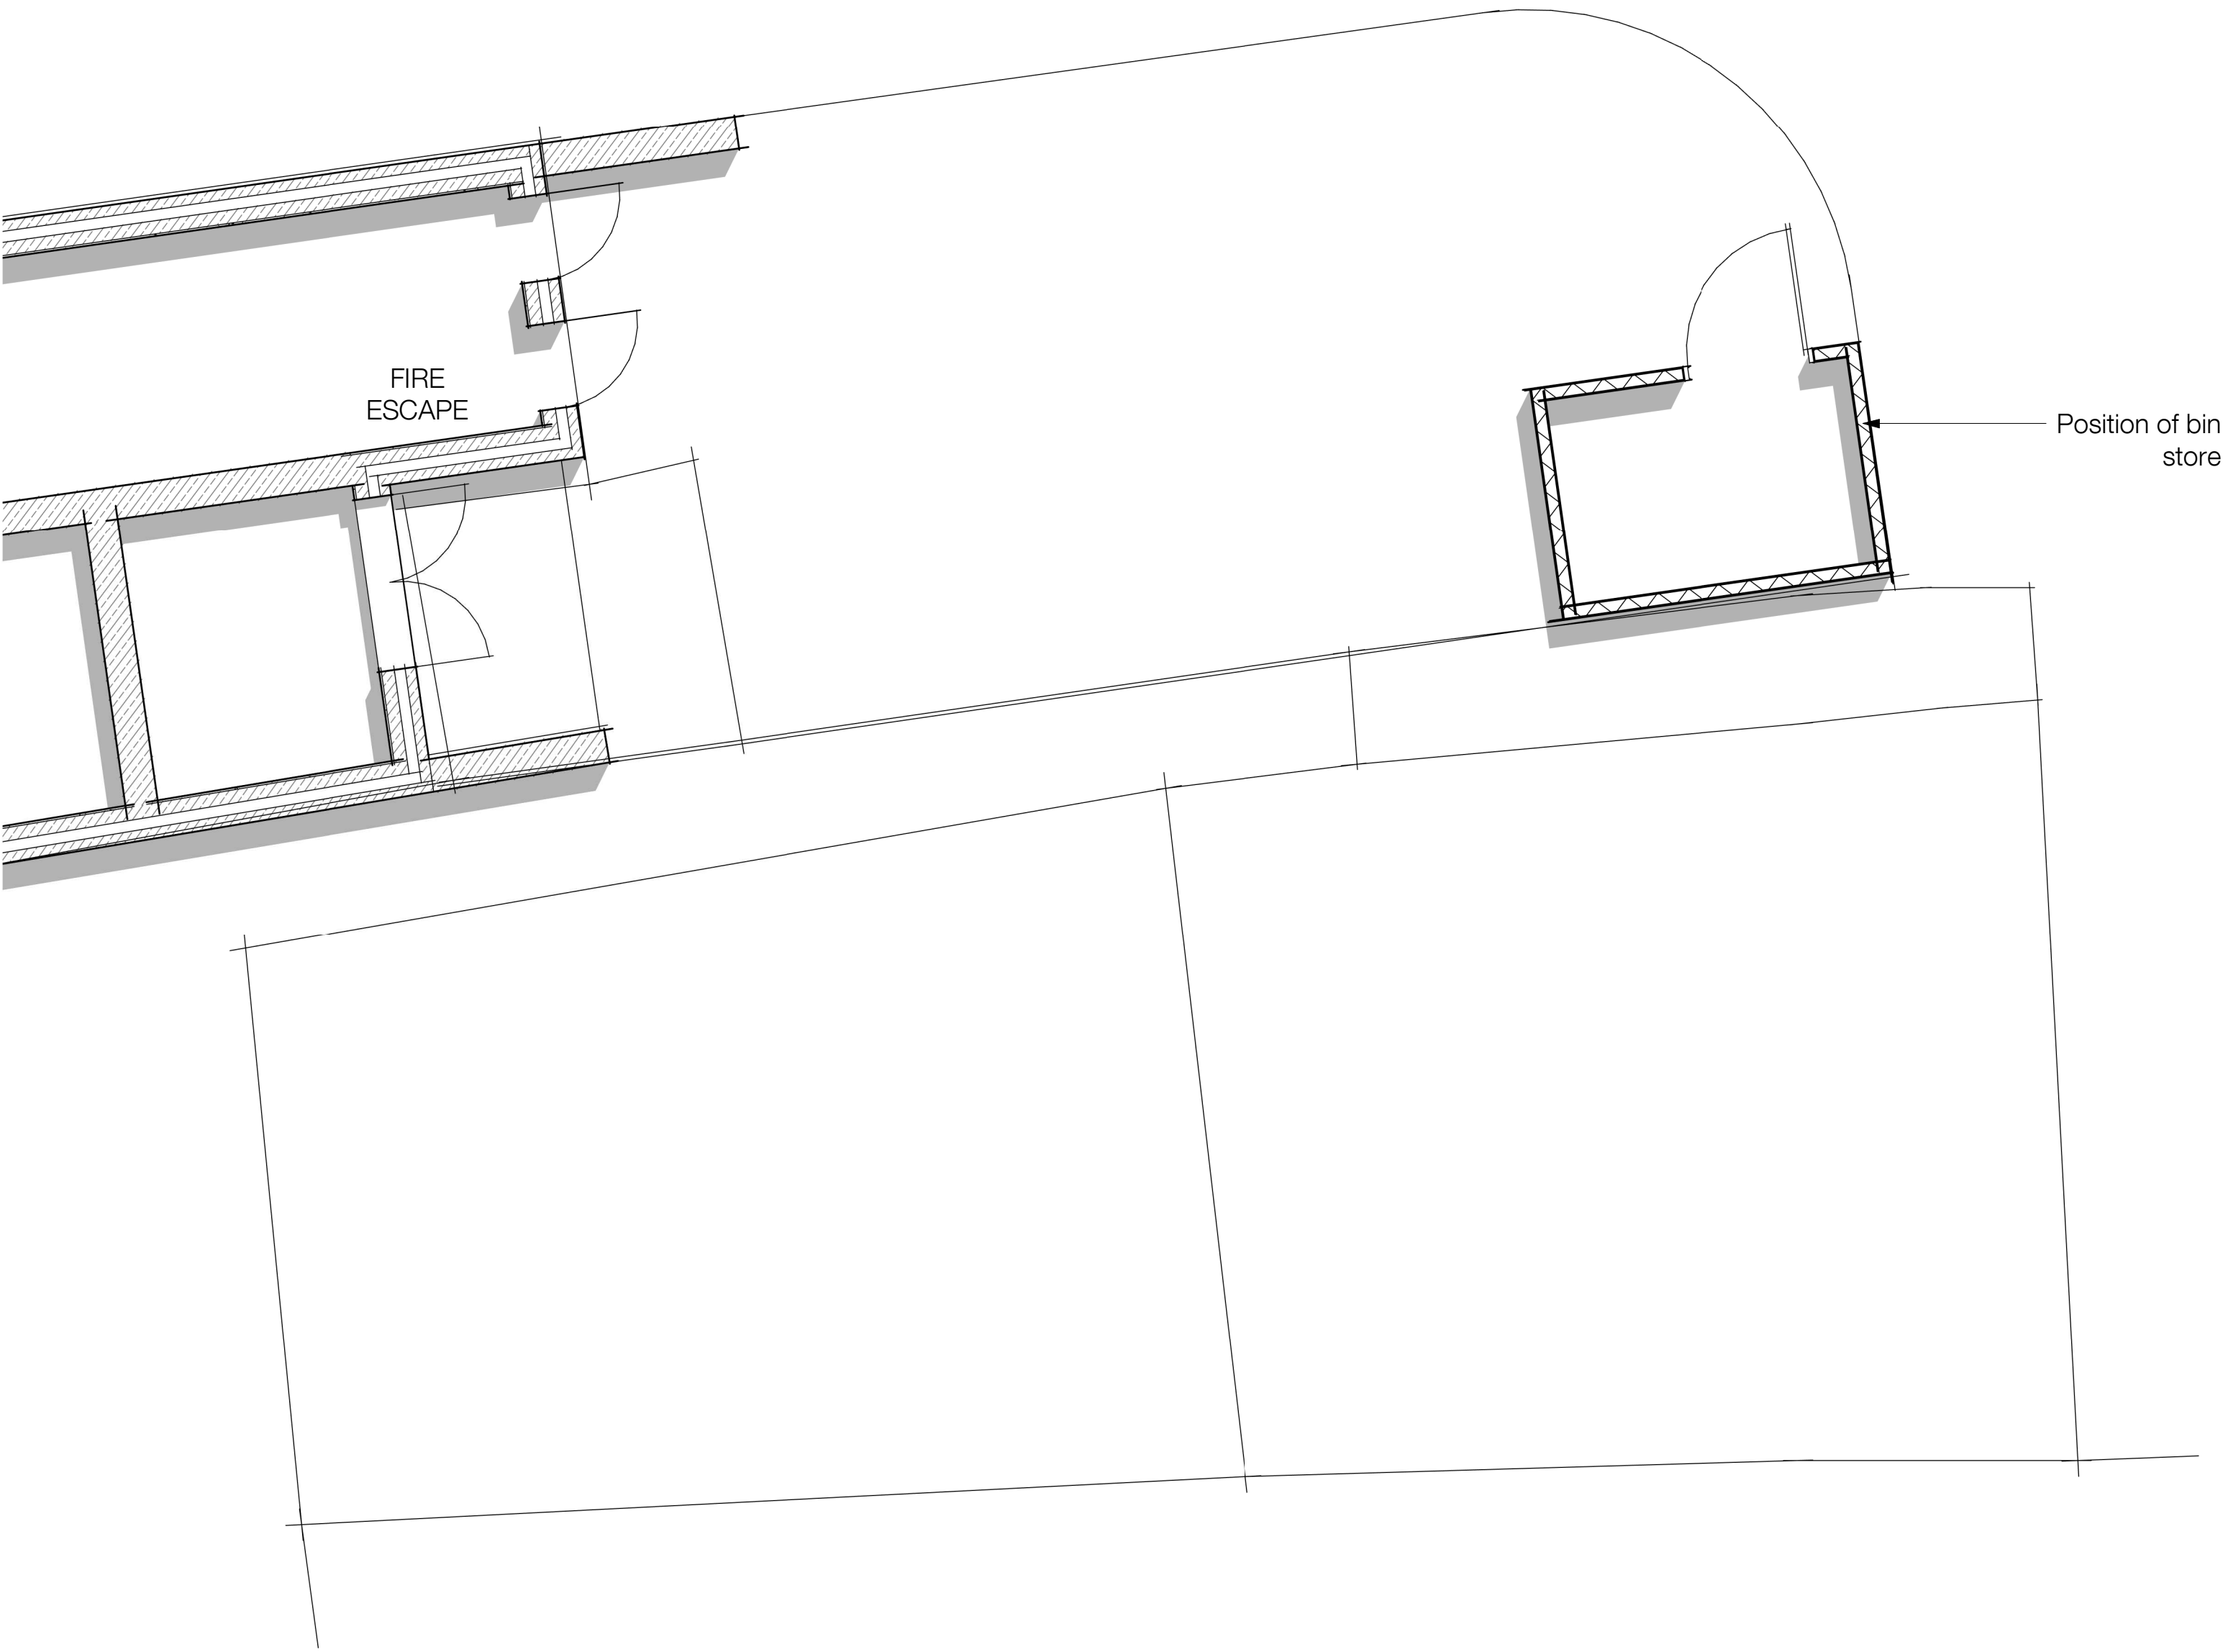


01 Ground floor plan as built
1 : 50

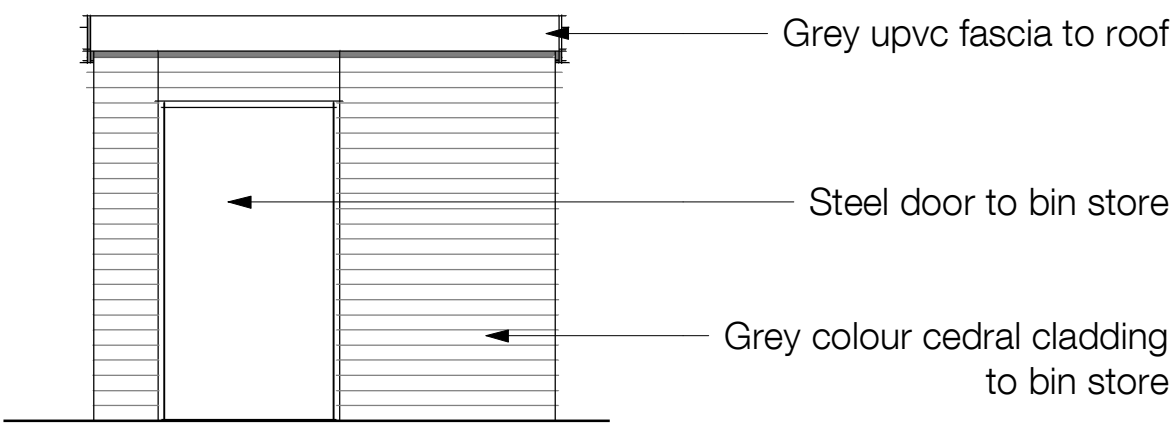


02 Front elevation
1 : 50

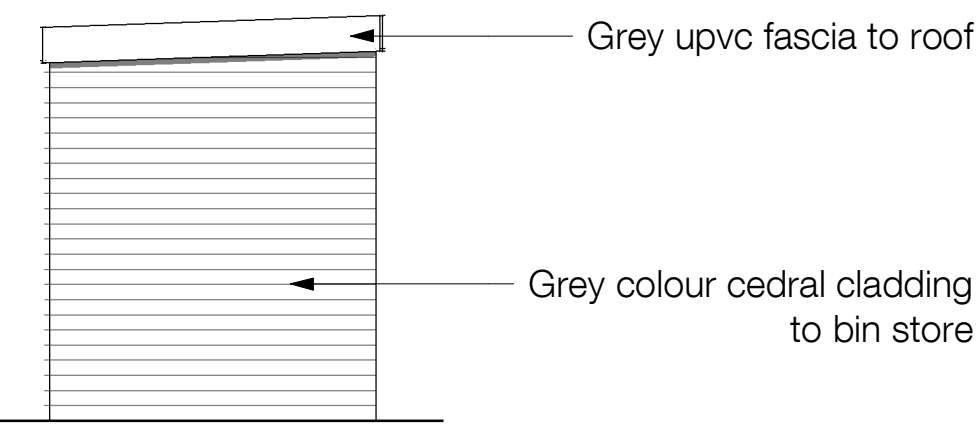

03 Side elevation 1
1 : 50

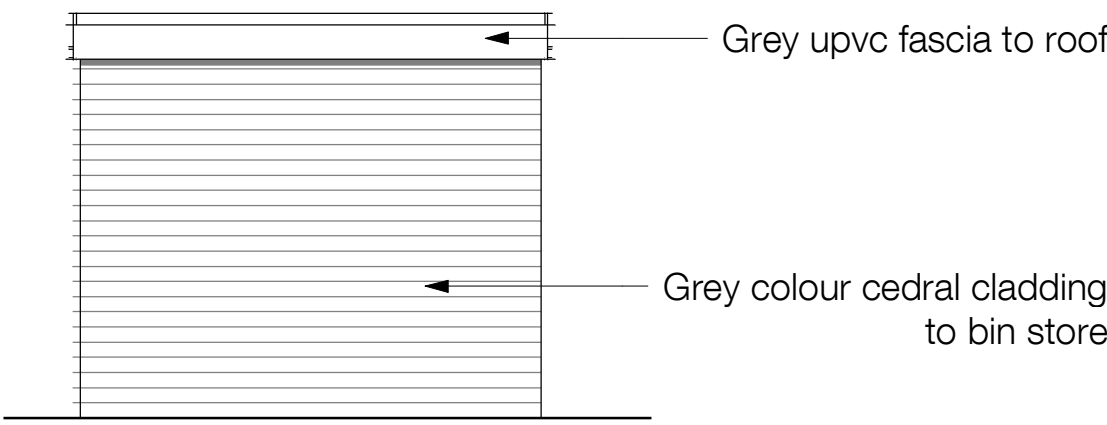

04 Rear elevation
1 : 50

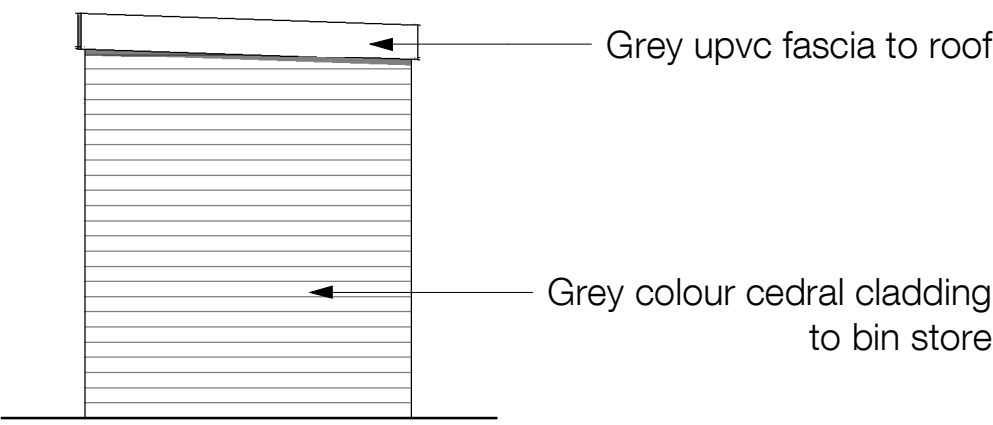

05 Side elevation 2
1 : 50

Notes

Do not scale from this drawing. Use figured dimensions only, which are displayed in millimeters unless stated otherwise. The contractor is requested to check all dimensions before work is put in hand. Any discrepancies within the drawing should be reported prior to commencement of works.

Copyright of this drawing belongs solely to CMKA Ltd. This drawing must only be used for the purpose for which it is supplied and its contents must not be reproduced for any purpose without written permission.

**CHAMBERLAIN
MOSS
KING**
architecture

97a Glebe Street | Penarth
Vale of Glamorgan | CF64 1EE

T. 02920 306400
www.chamberlainmossking.co.uk

Project	Bin Store @ High Street
Project number	L588
Client	TEDS DEVELOPMENTS LTD
Title	Plans & elevations
Drawing number	A002
Scale	1 : 50 at A1
Revision	
Status	PLANNING
Drawn	
Date	05.05.2021