
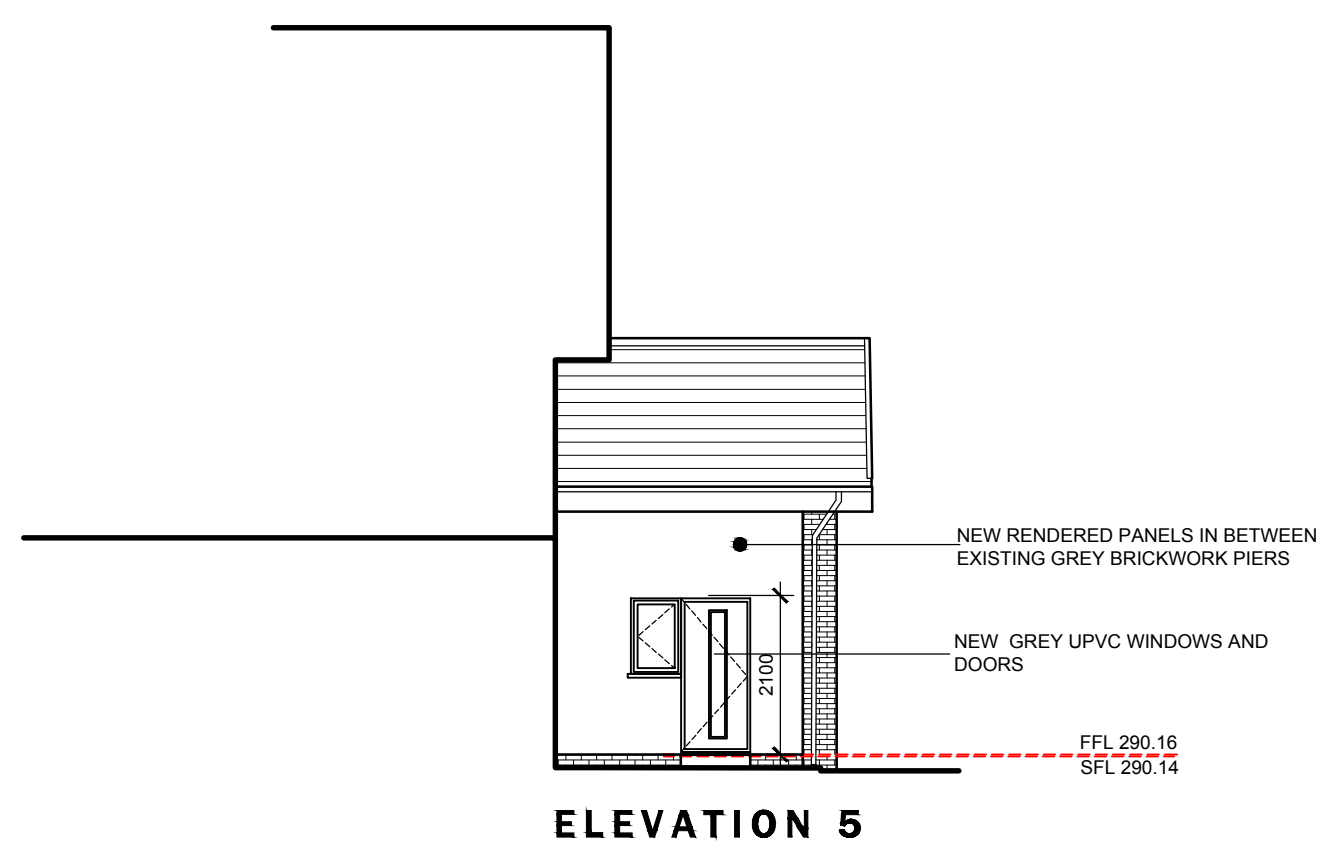
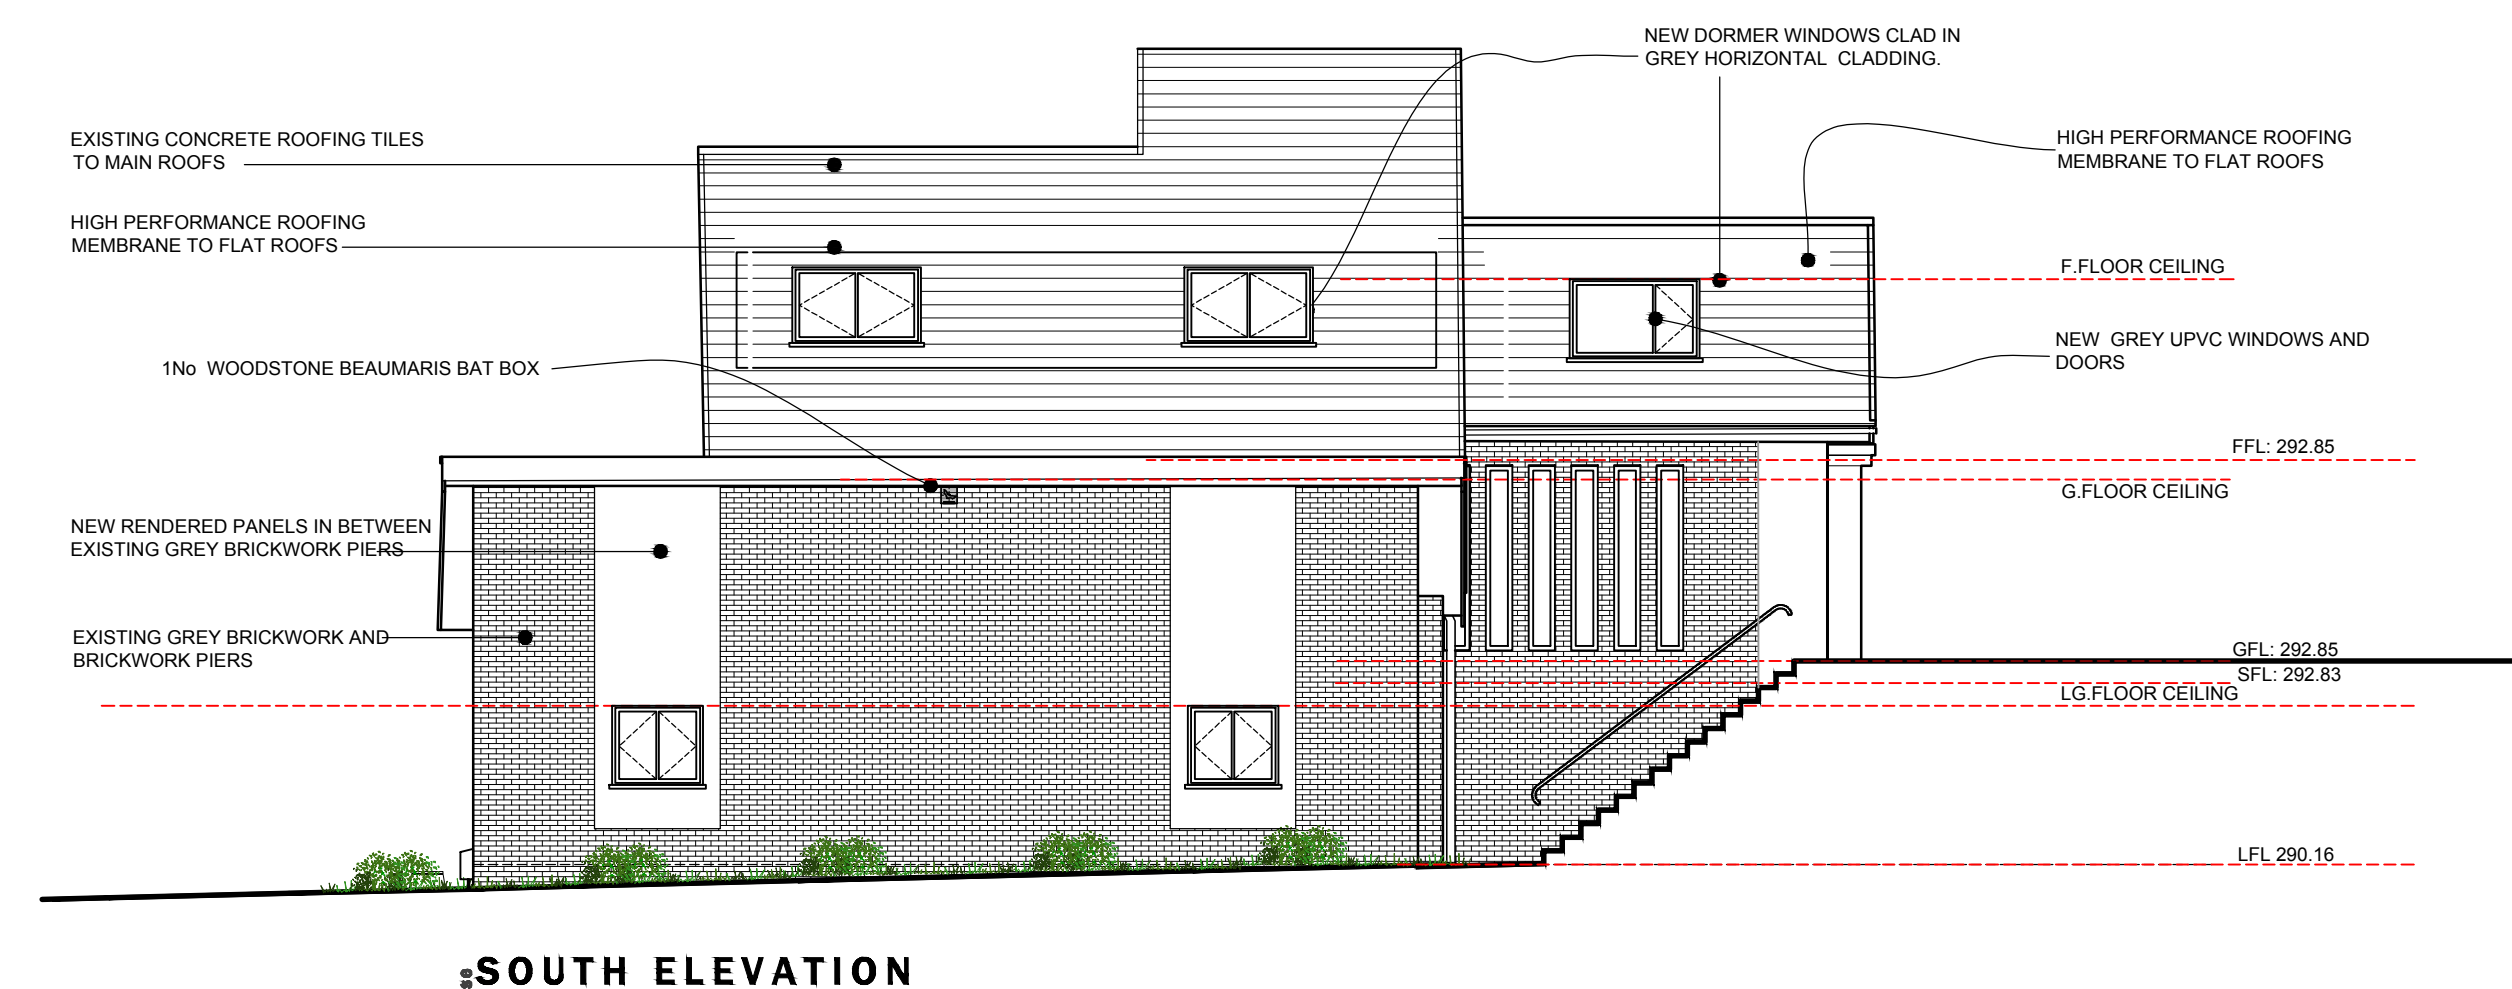


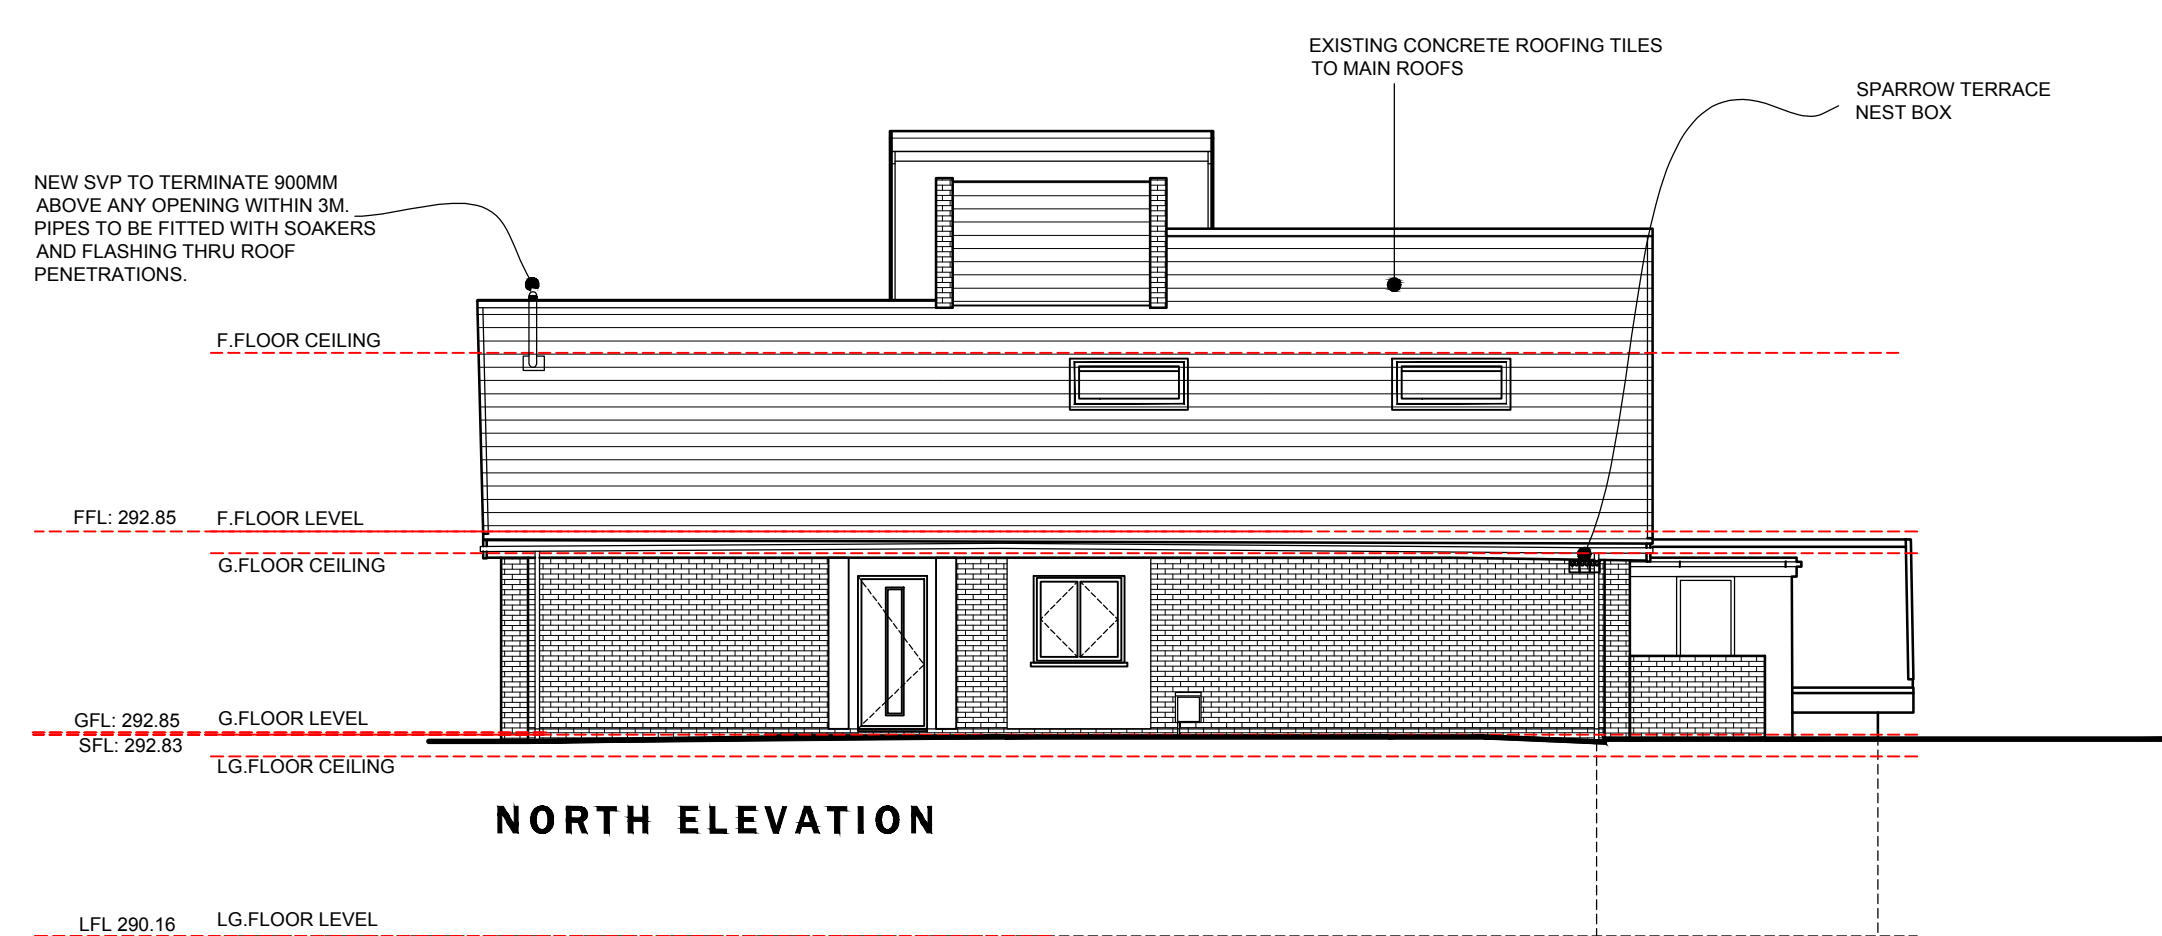

Client	Drawing No	Scale	Revision
Mr A Thomas	LT2116.04.02	1:100 @A1	K
Job Title	Drawing Title	Date	Checked
Wesley Chapel, Dowlais	Proposed Elevations	Oct 21	KML

Revisions		REV/G	DATE	REVISIONS	REV/J	DATE	REVISIONS
1	REVISIONS TO SUIT CLIENT COMMENTS	REV/D	JUNE 22	ADDITIONAL BIRD BOXES ADDED AS PER BAY REPORT	REV/G	OCT 22	FURTHER CHANGES TO BIRD AND BAT BOX LOCATIONS
2	MINOR CHANGES TO SUIT PRE-PLANNING APPLICATION BIRD AND BAT BOXES RELOCATED	REV/H	JUNE 24	WALL LIGHTS ADDED	REV/H	JUNE 24	REVISIONS SUBMITTED TO SUIT AS BUILT SITUATION
3	CHANGES TO SUIT CLIENT COMMENTS	REV/F	SEPT 22	WALL LIGHTS REMOVED	REV/J	JULY 24	PLANS FURTHER REVISED TO SUIT AS BUILT
4	REVISIONS TO SUIT CLIENT COMMENTS	REV/C	APRIL 22	COMPASS ORIENTATION TO INCLUDE			
5	REVISIONS TO SUIT CLIENT COMMENTS						REV/J OCT 24 ROOFING FINISHES UPDATED AND ECOLOGY DETAILS RE-ADDED.

Do not scale from this drawing. The users of this drawing shall check dimensions & report all errors and omissions to LeTruccio Design.

This drawing is copyright. It must not be copied, used or disclosed to third party without prior permission of LeTruccio Design.

This drawing is copyright. It must not be copied, used or disclosed to third party without prior permission of LeTrucco Design.

REVISED July 24
ANS FURTHER REVISED TO SUIT ASR III T

WALL LIGHTS REMOVED.

ELEVATION TITLE UPDATED TO INCLUDE
COMPASS ANNOTATION


ELEVATION TITLE
COMPASS ANNOT

NAME DATE

50

.....

Drawing Purpose

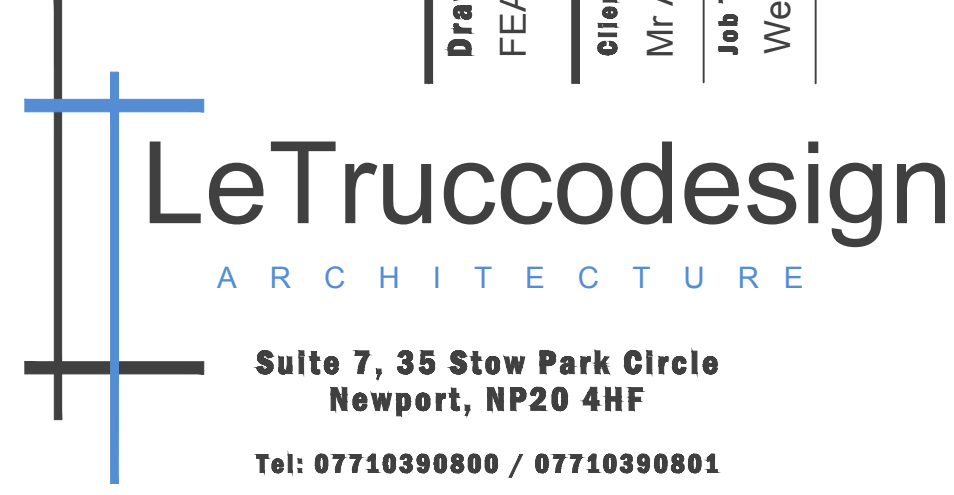

**Suite 7, 35 Stow Park Circle
Newport, NP20 4HF**

Tel: 07710390800 / 07710390801

Tel: 07710390800 / 07710390801

PROPOSED ELEVATIONS

0 1000 2000 3000 4000 5000mm