

Revisions		
A	Section Lines L9, L11 and L12 added.	17 Sep '19
B	'Contract Documents' Drawing Status added.	18 Oct '19
C	Stair and lift area details generally updated. Brushed stainless steel recessed spotlights added.	16 Jun '20

DIMENSIONS ARE NOT TO BE SCALED FROM THIS DRAWING
THIS DRAWING IS COPYRIGHT

CONSTRUCTION RISK


HI NUMBER




NOTE:
THIS DRAWING HAS BEEN PRODUCED FROM THIRD PARTY
INFORMATION AND IS NOT AN AS BUILT DRAWING.

THIS DRAWING IS ONLY A REPRESENTATION AND THEREFORE
DISCREPANCIES MAY BE PRESENT. ALL DIMENSIONS ARE
APPROXIMATE ONLY.

IT IS RECOMMENDED THAT A DETAILED SURVEY IS
COMMISSIONED PRIOR TO ANY FUTURE DESIGN WORK.

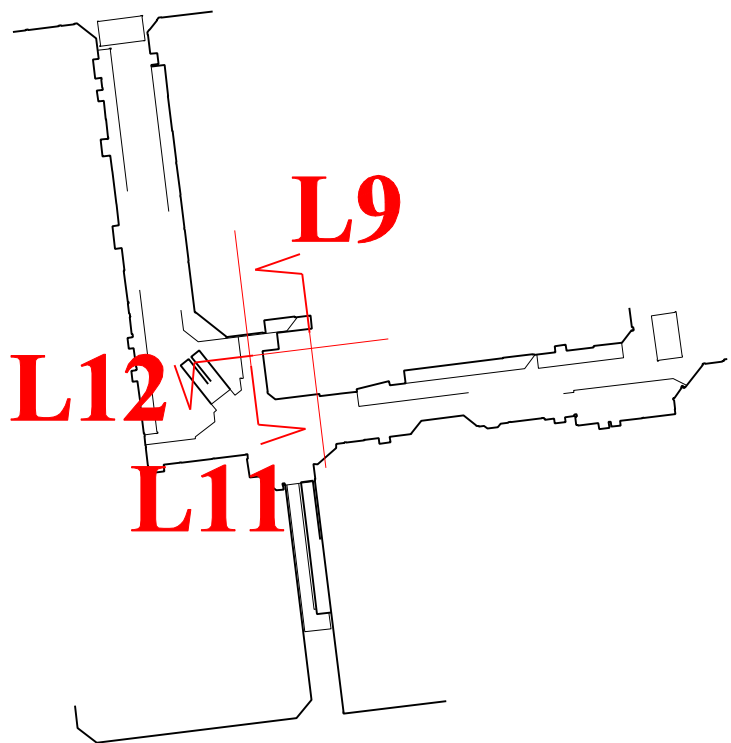

KEY PLAN

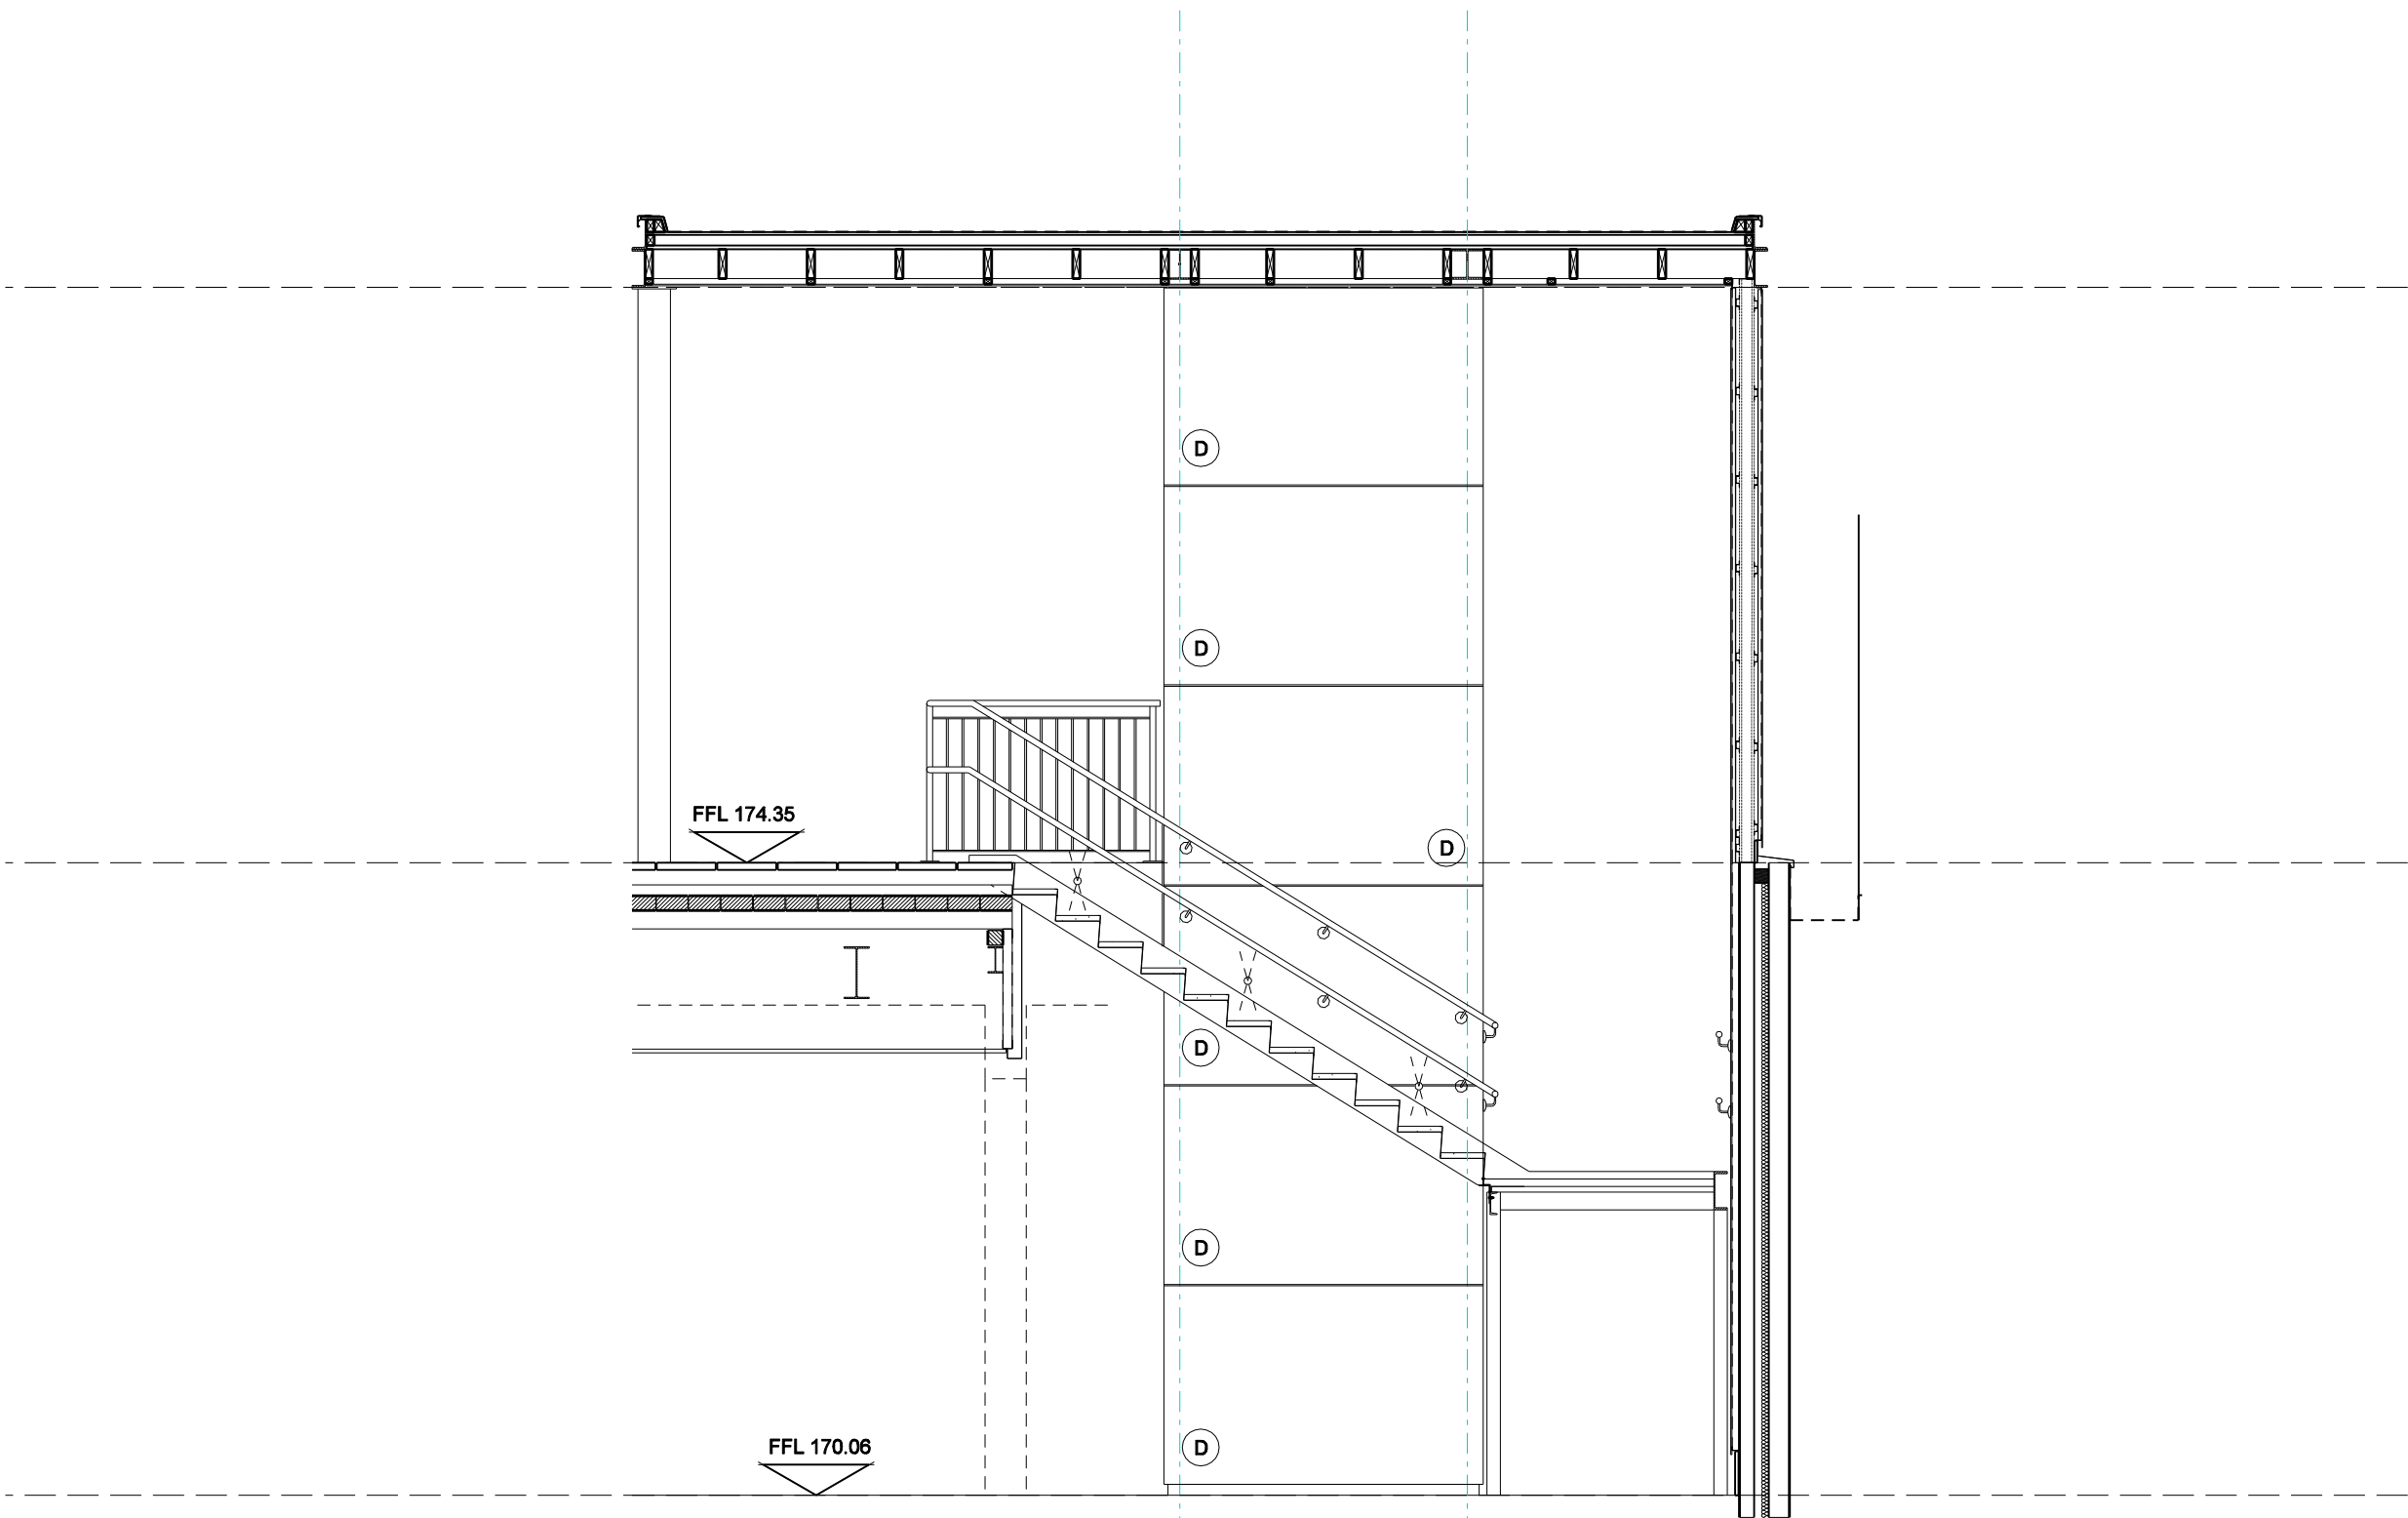

SECTION L9


FINISHES :-

CLADDING PANELS -


B TRESPA - A12.1.8 PASSION RED, SATIN FINISH

D TRESPA - A21.1.0 WINTER GREY, SATIN FINISH

RAIN SCREEN CLADDING ON ALUMINIUM SUPPORT FRAME,
DRAINED AND VENTILATED CAVITY WITH EXPOSED COLOUR
MATCHED RIVET FIXINGS.

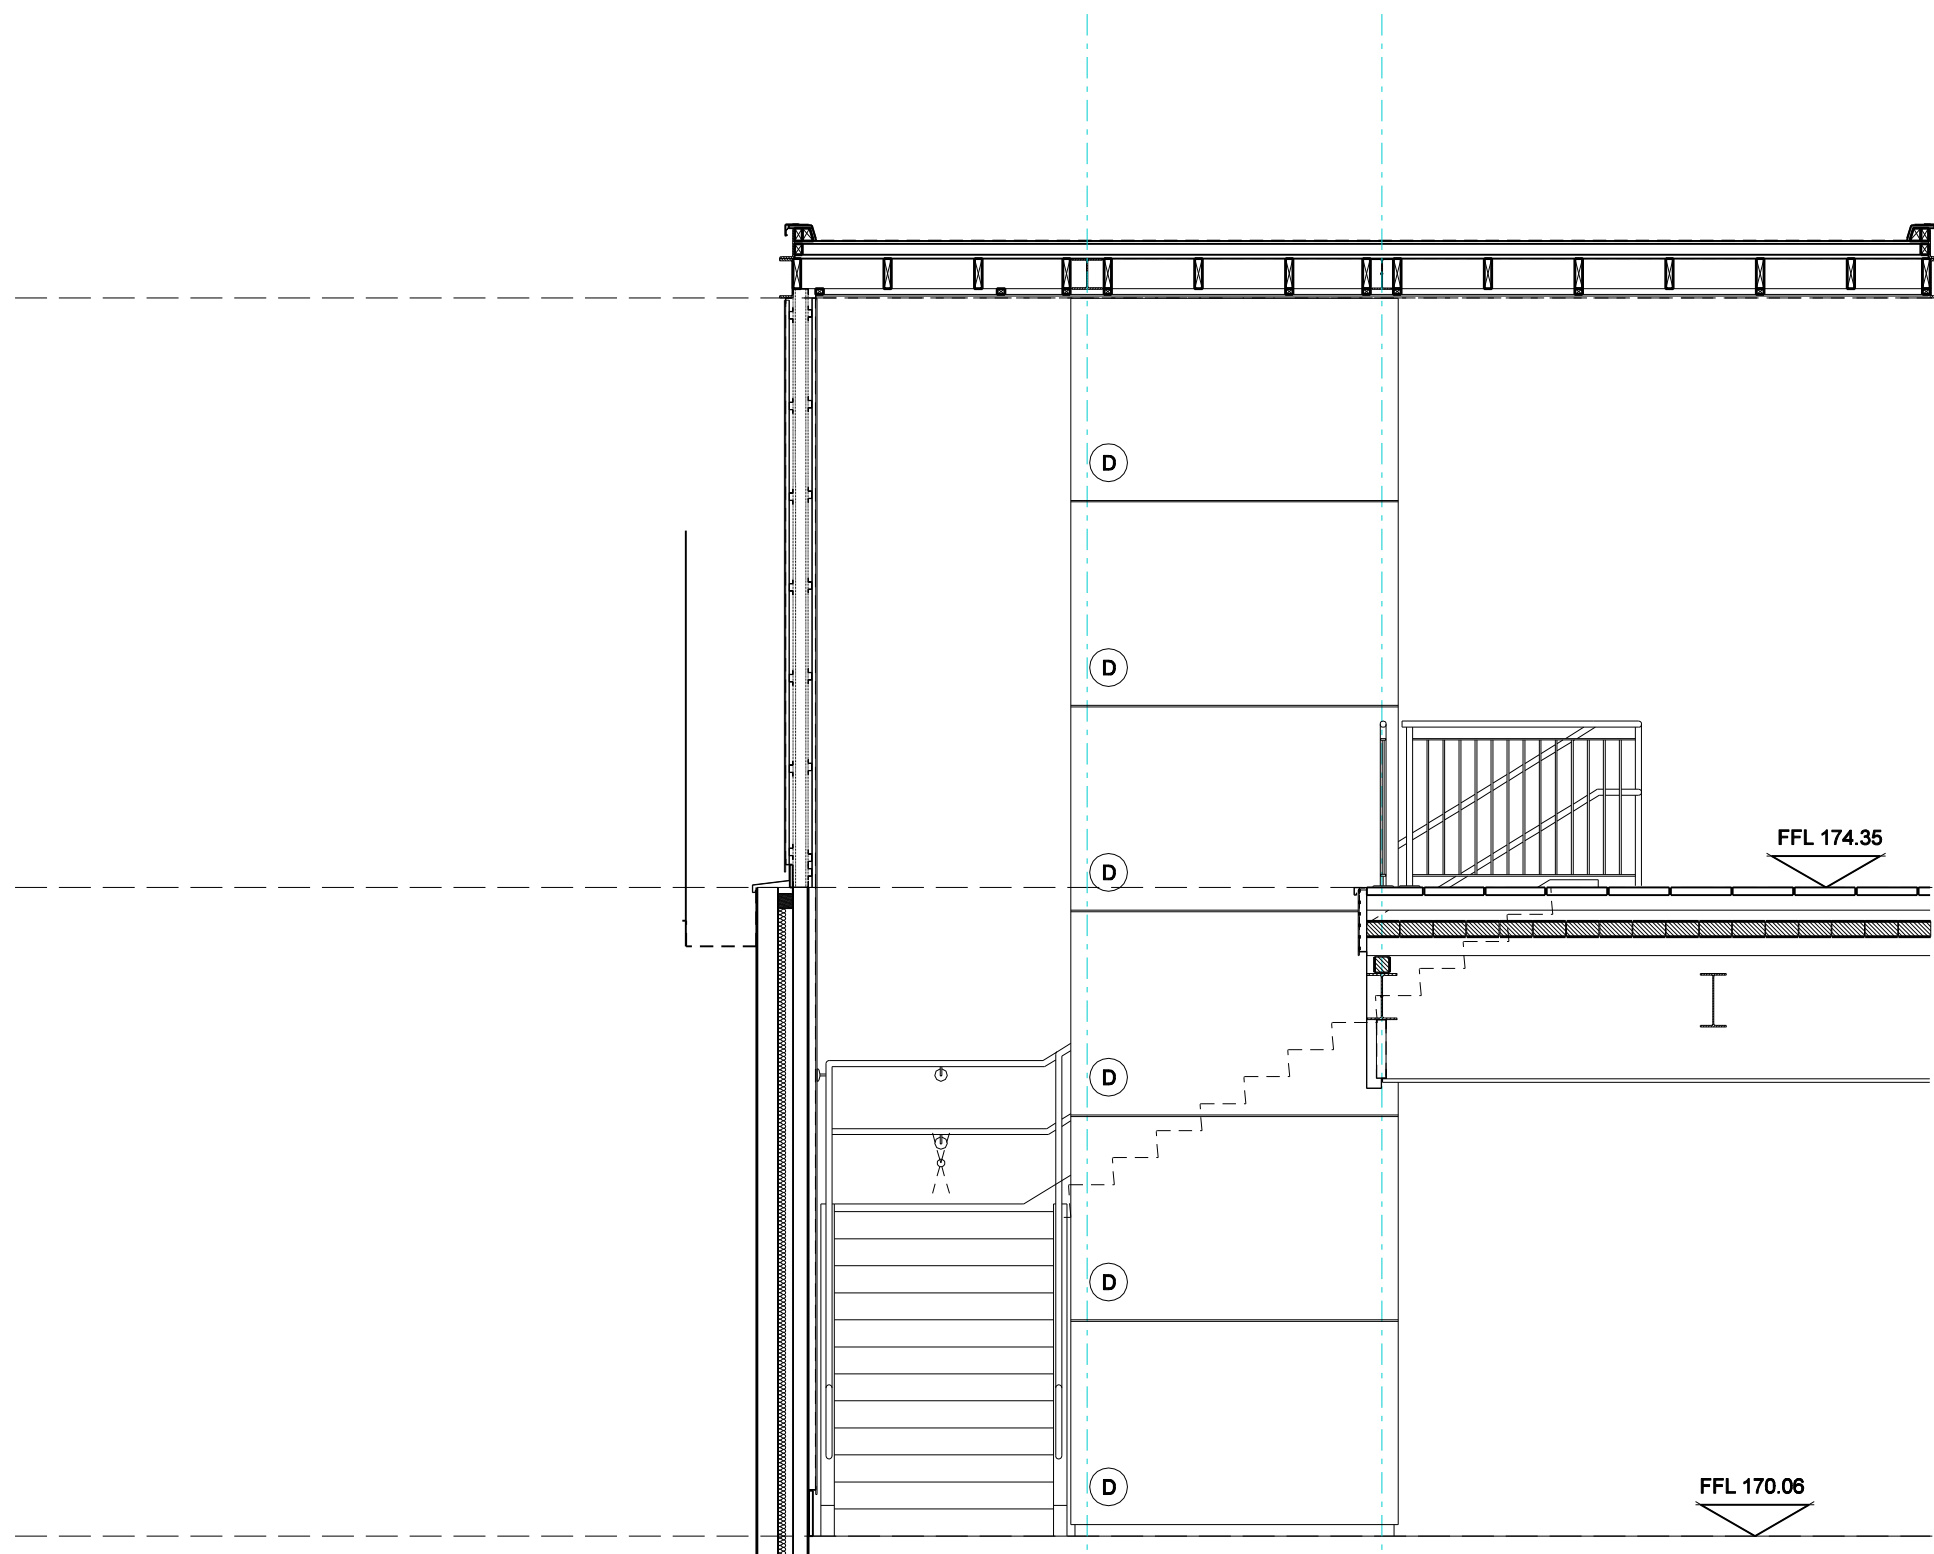

SECTION L11

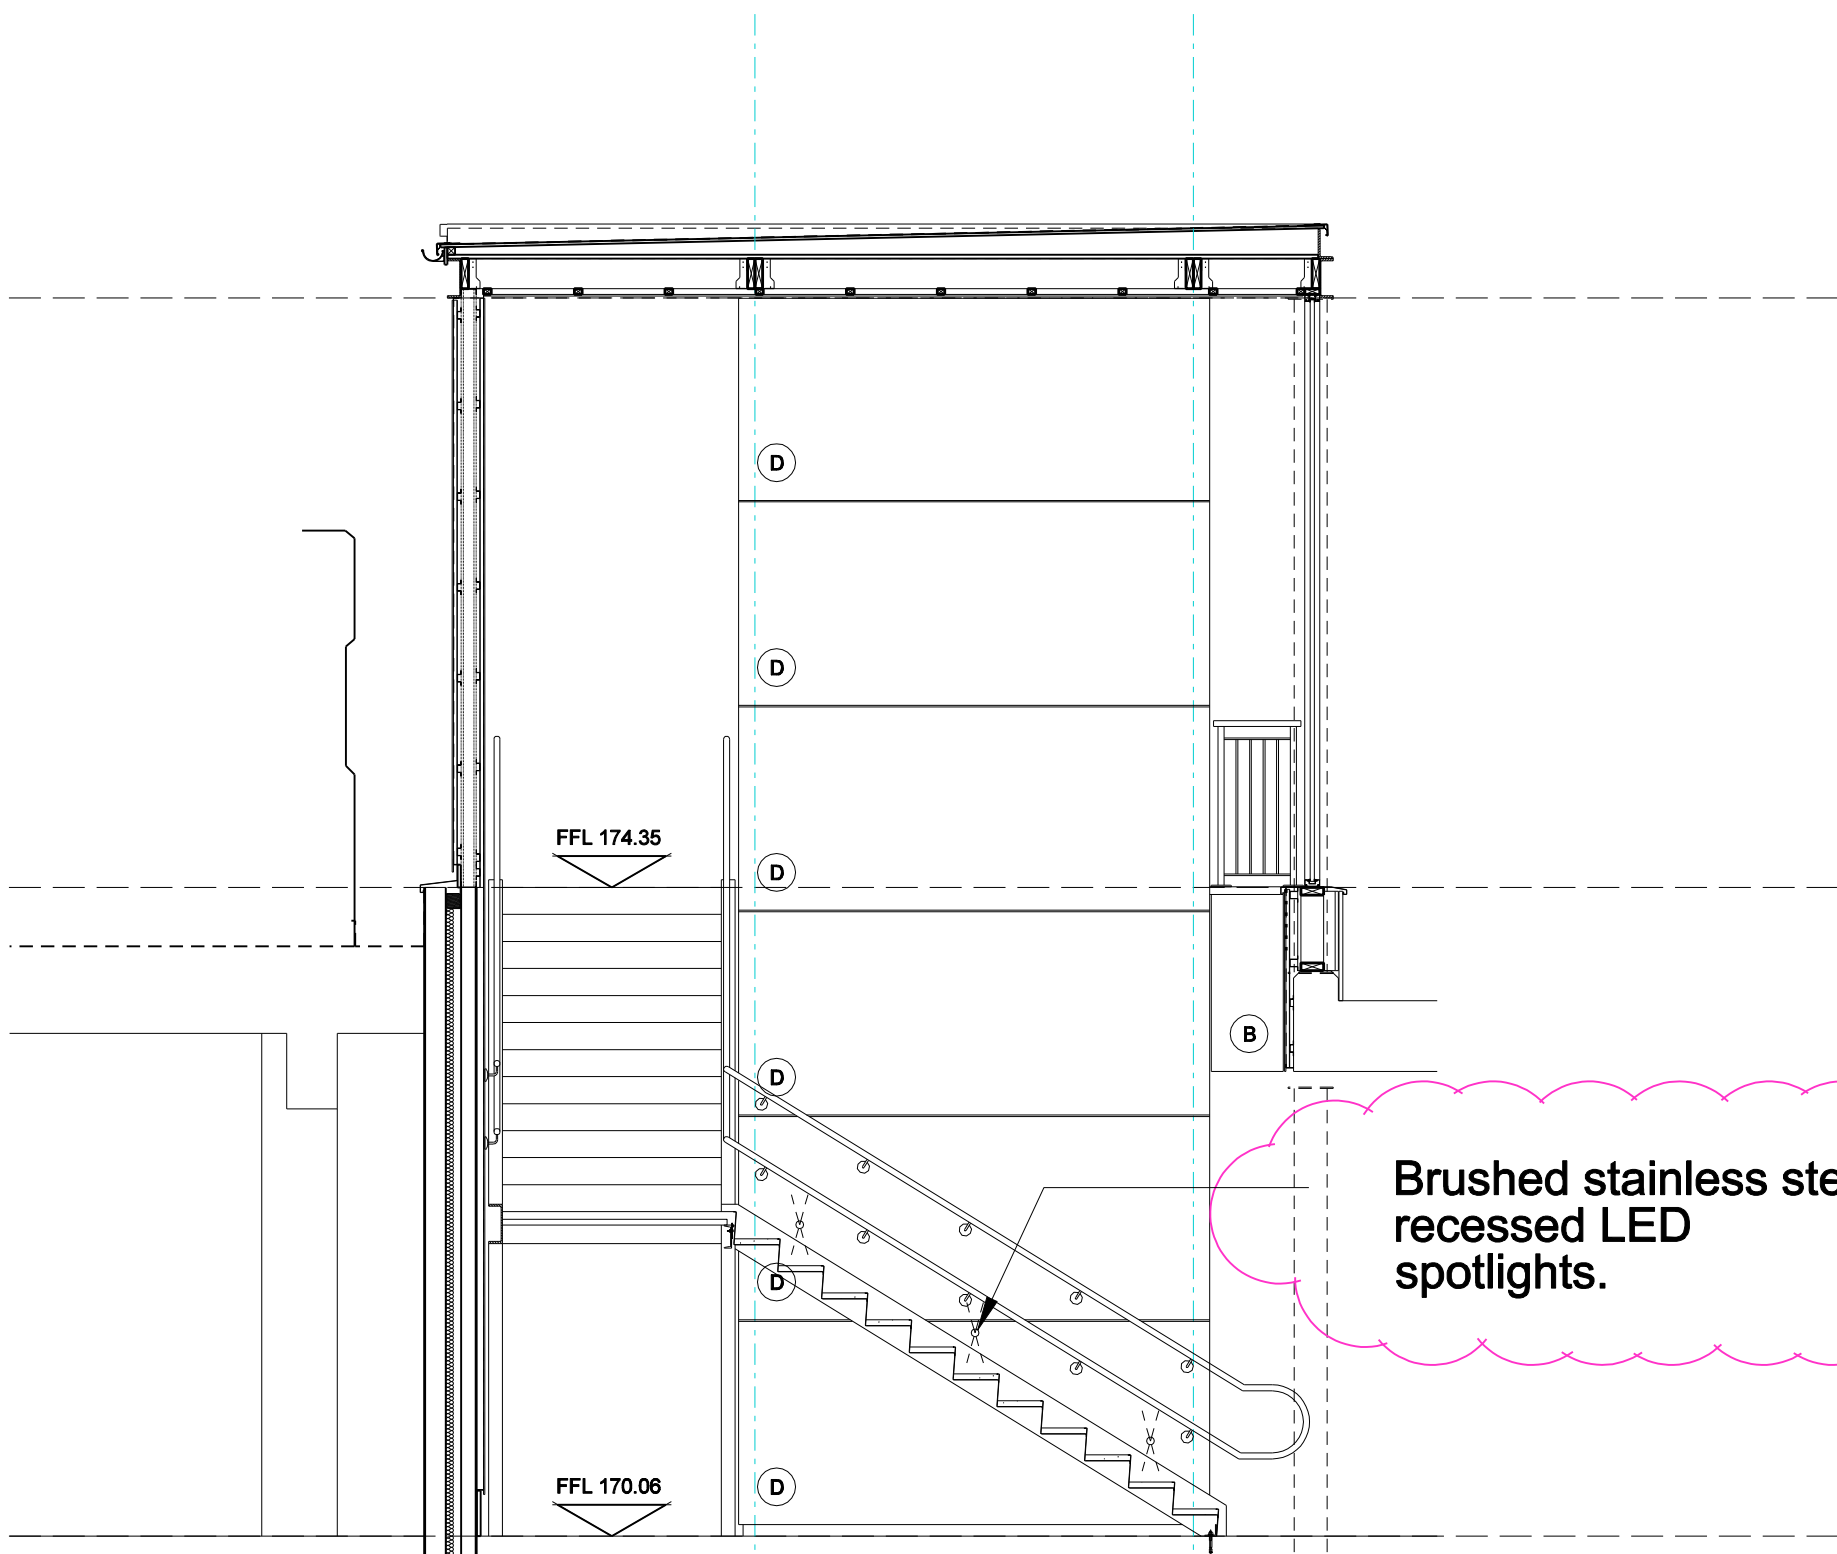

SECTION L12

pentan
architects

22 Cathedral Road
Cardiff CF11 9LJ
t: 029 2030 9010
info@pentan.co.uk

Project
ST TYDFIL SHOPPING CENTRE
Client
R & M WILLIAMS
Drawing Title
PROPOSED LIFT STAIRCASE
ENCLOSURE SECTIONS

NOTES. Do not scale. All dimensions are in millimetres unless stated otherwise

Date
MAR '19
Scale
1:50 @ A1
Drawing No.
3779_A_4502
Rev.
C