


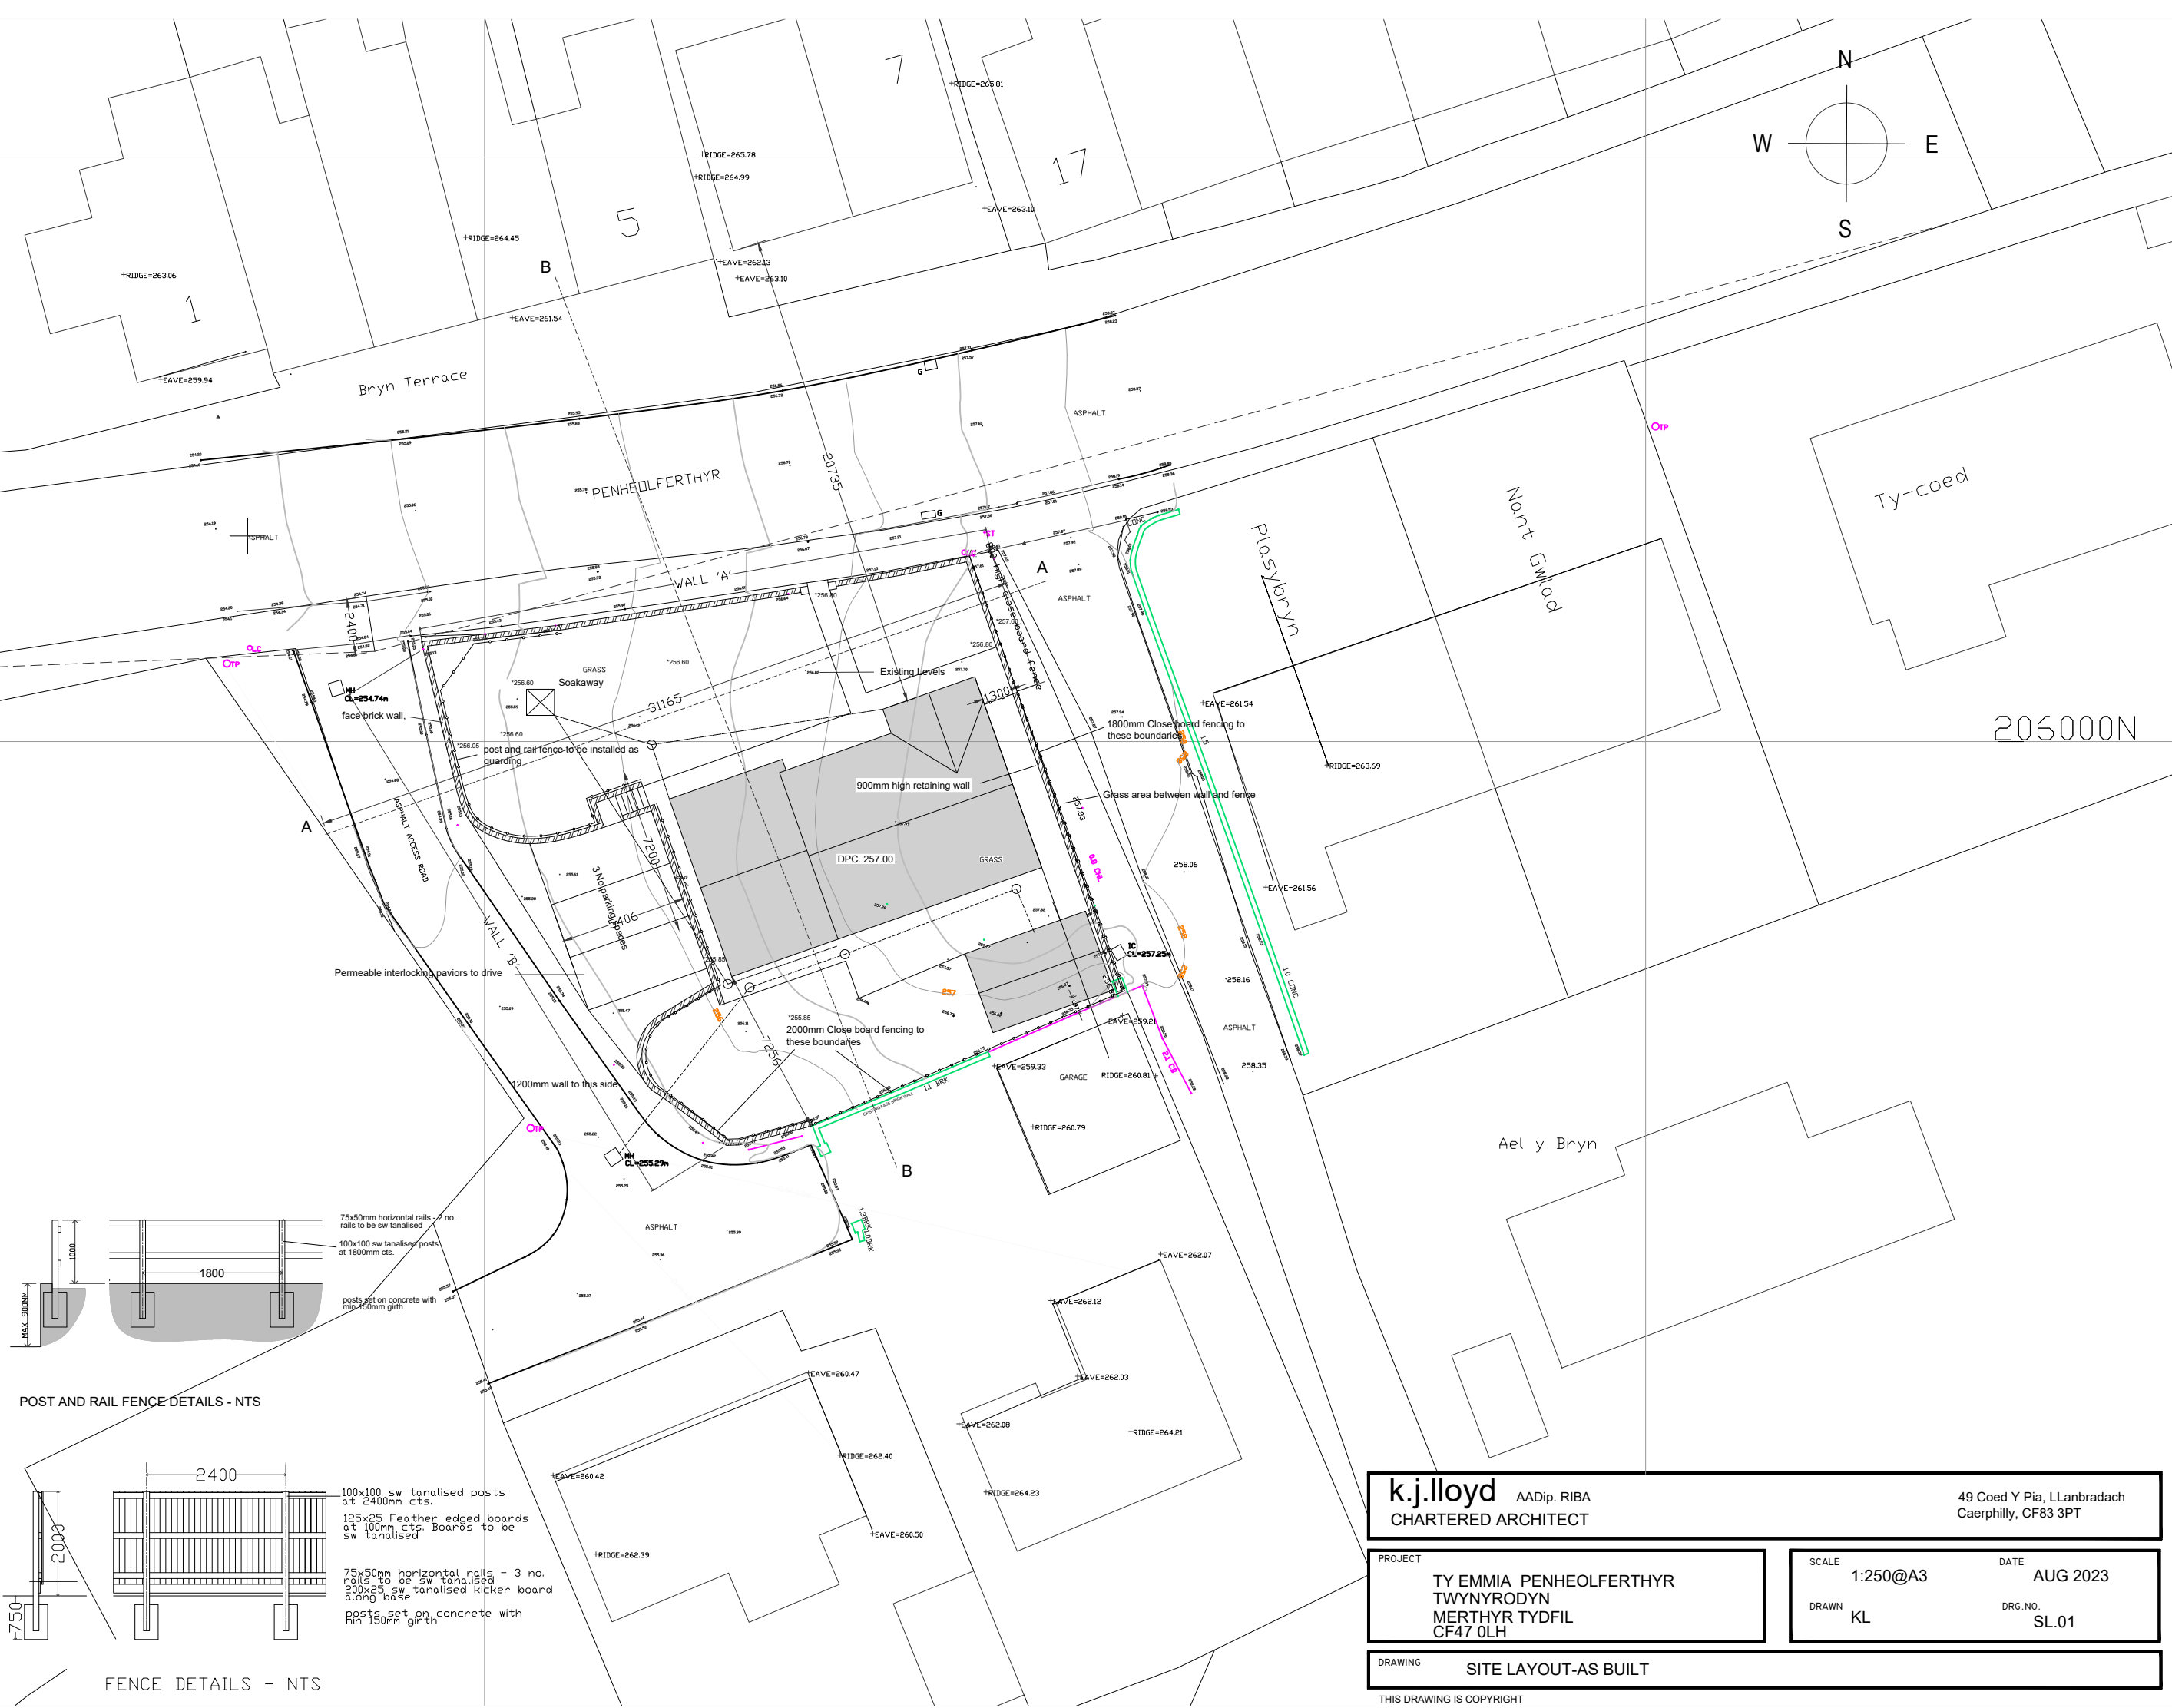

Technical drawing of a window frame showing dimensions: 2400 mm width and 2000 mm height.

k.j.lloyd AADip. RIBA CHARTERED ARCHITECT		49 Coed Y Pia, LLanbradach Caerphilly, CF83 3PT
PROJECT	TY EMMIA PENHEOLFERTHYR TWYNYRODYN MERTHYR TYDFIL CF47 0LH	SCALE 1:250@A3 DRAWN KL
		DATE AUG 2023 DRG. NO. SL.01
DRAWING SITE LAYOUT-AS BUILT		
THIS DRAWING IS COPYRIGHT		