
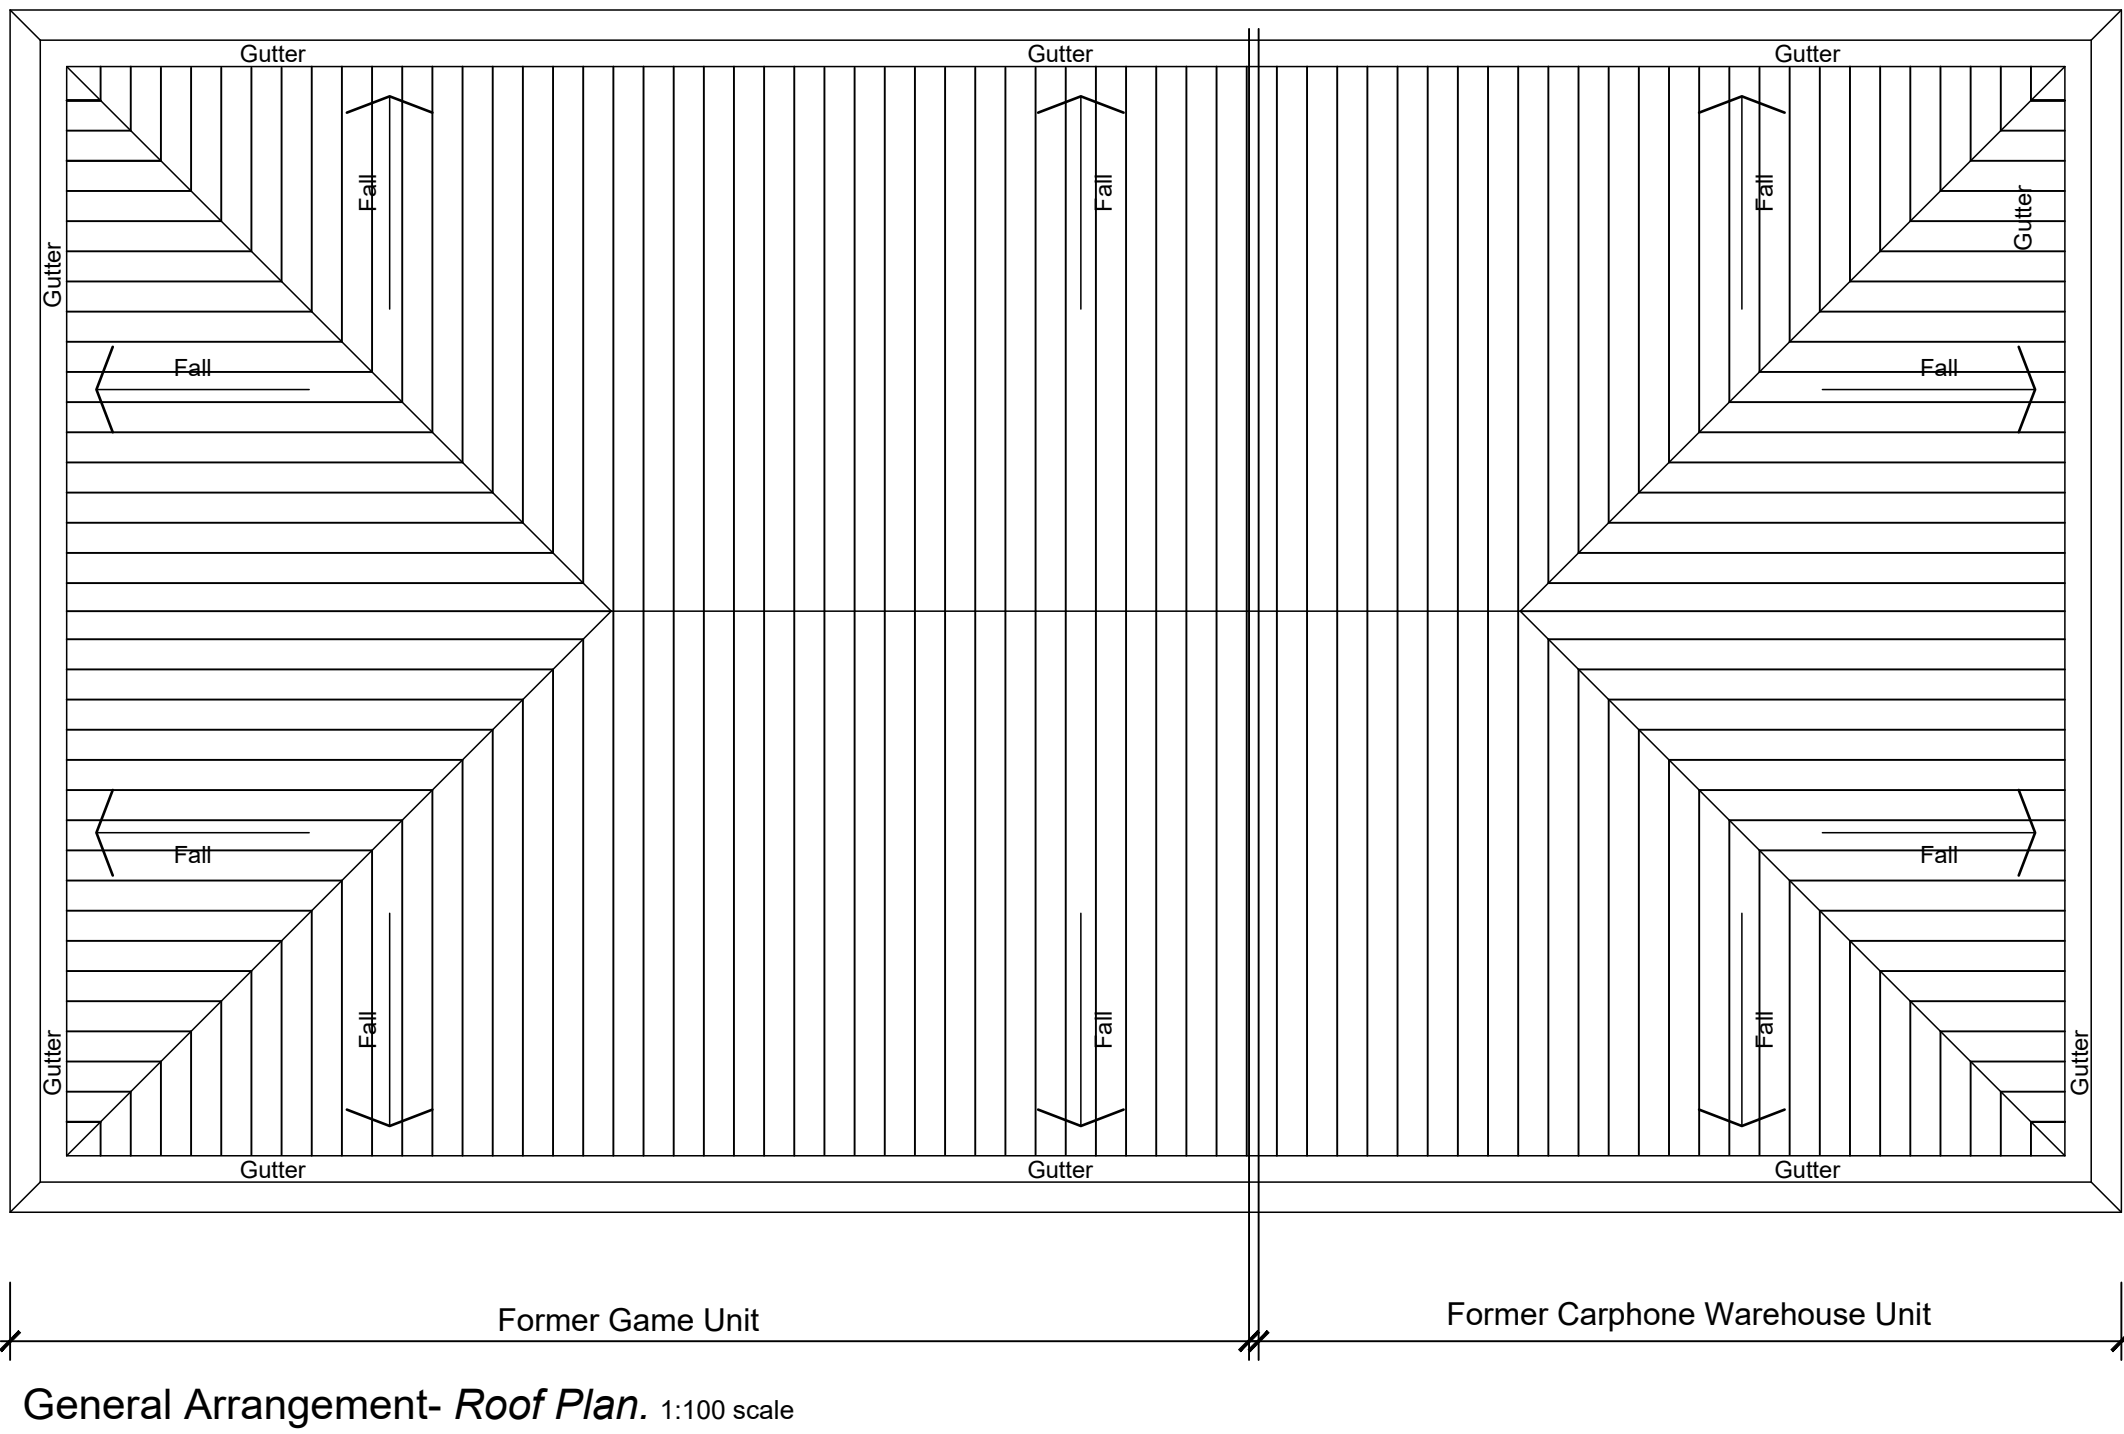


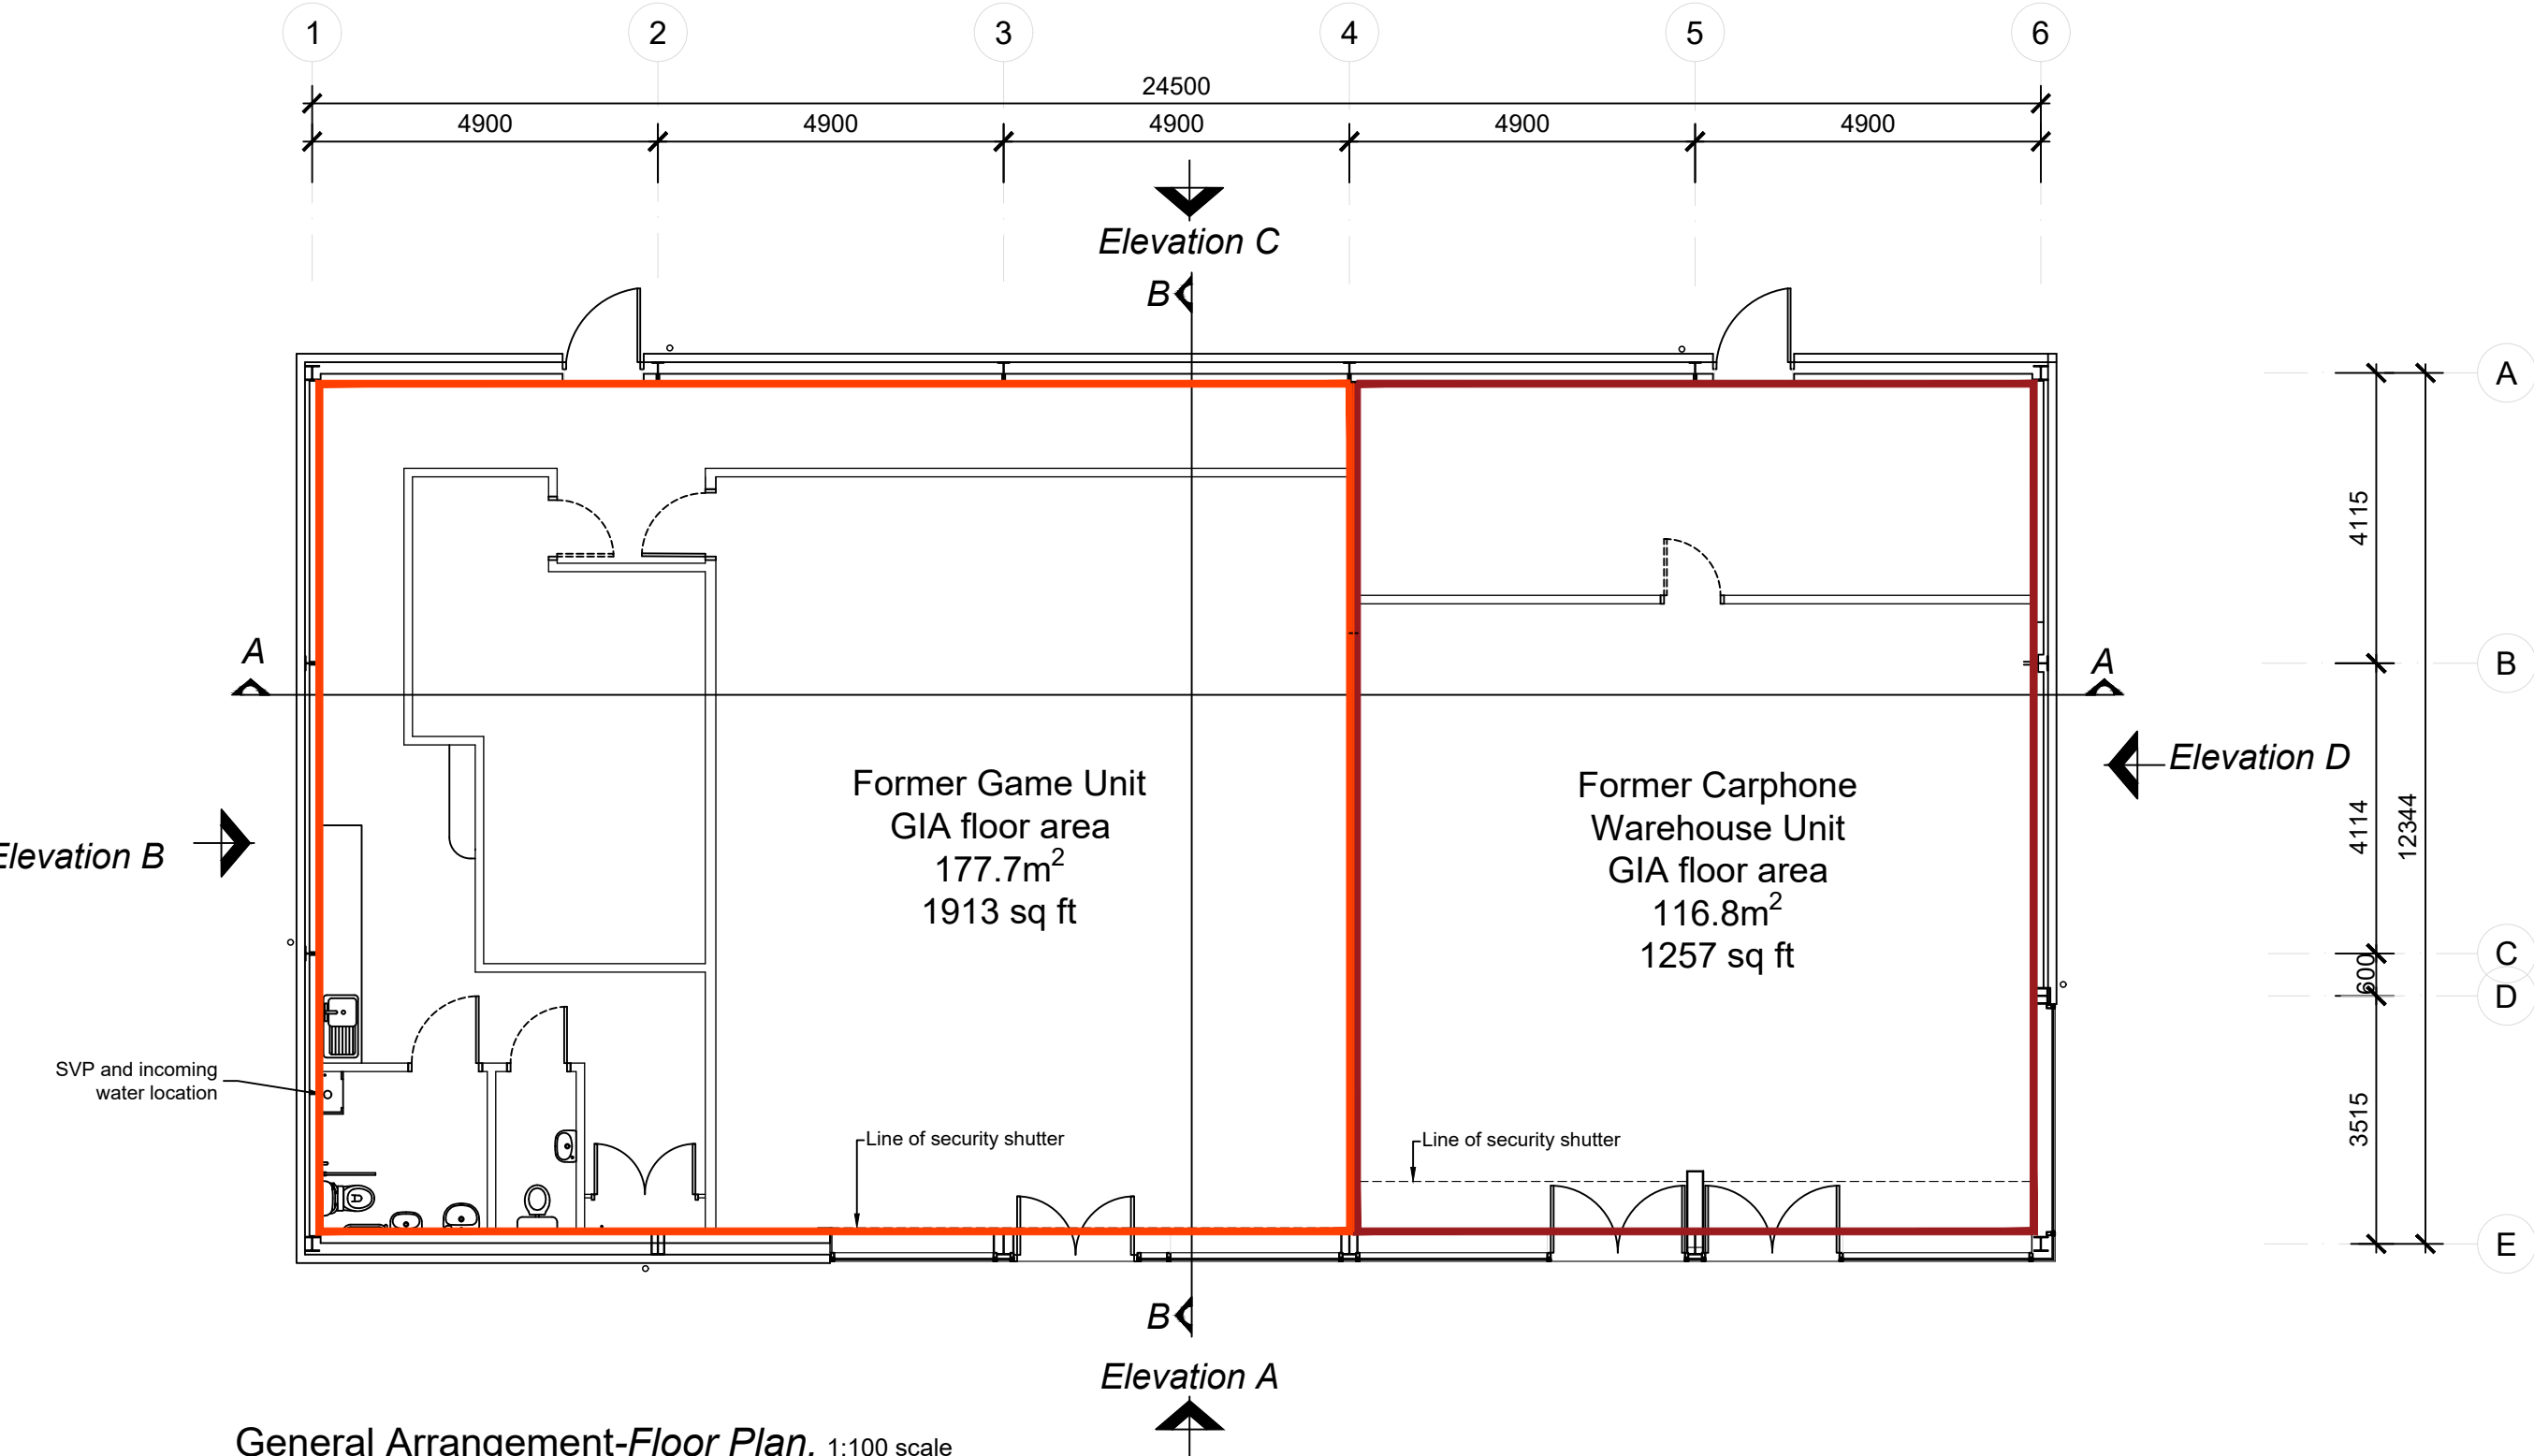

Note:
The linear dimensions shown on this drawing are those given to the contractor for construction purposes only and should not be used as confirmation of installed dimensions of the components on site.

Figured dimensions and levels to be used.
Any inaccuracies must be notified to the architect.
Detail drawings and large scale drawings take precedence over smaller drawings.







Rev:	
A	04/02/04....M.Robbins *Drawing status amended to Construction issue *Glazing mullion position amended (G/L 4-5) to suit cladding joint
B	25/03/04....M.Robbins *Orientation of plan on sheet amended
C	26/03/04....M.Robbins *External finishes notes amended.
D	19/04/04....M.Robbins *Grid references amended back to original - Building rotated 180deg on grid.
E	07.04.05...PG ISSUED AS RECORD DRAWING

Chk'd:	Rev:	
F	30/09/20...I Faulkner Unit subdivision shown, as surveyed 28.09.2020. Title name changed from Unit 10 to Former Carphone Warehouse and Game Unit	-

Chk'd:	Rev:	

RECORD DRAWING
This drawing represents the final version of information supplied by Powell Dobson Architects to the contractor, plus any site changes advised by the contractor.

PRELIMINARY	
PLANNING	
DESIGN	
TENDER	
CONSTRUCTION	

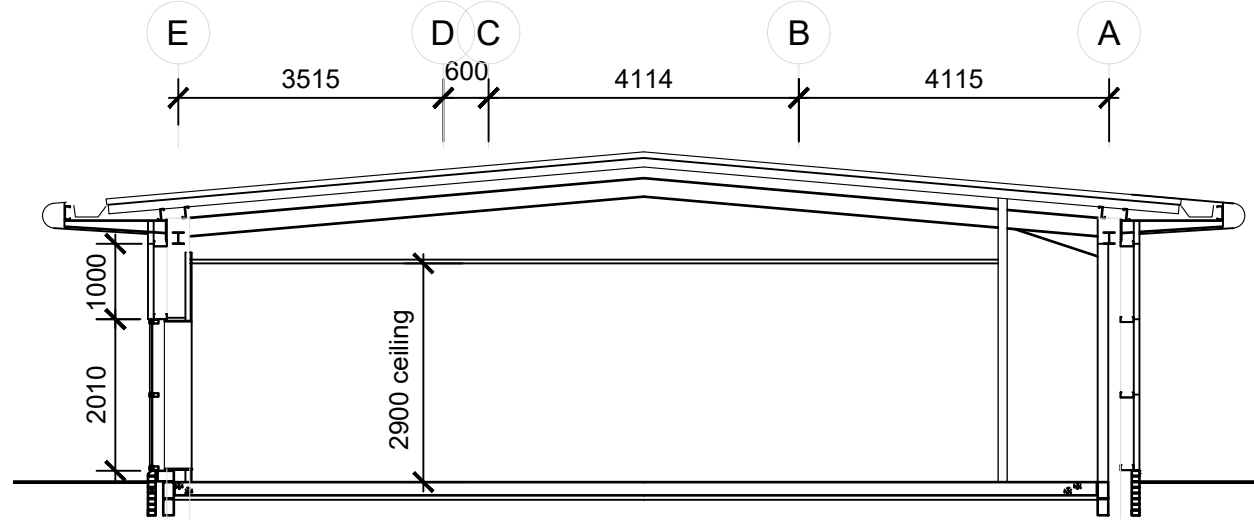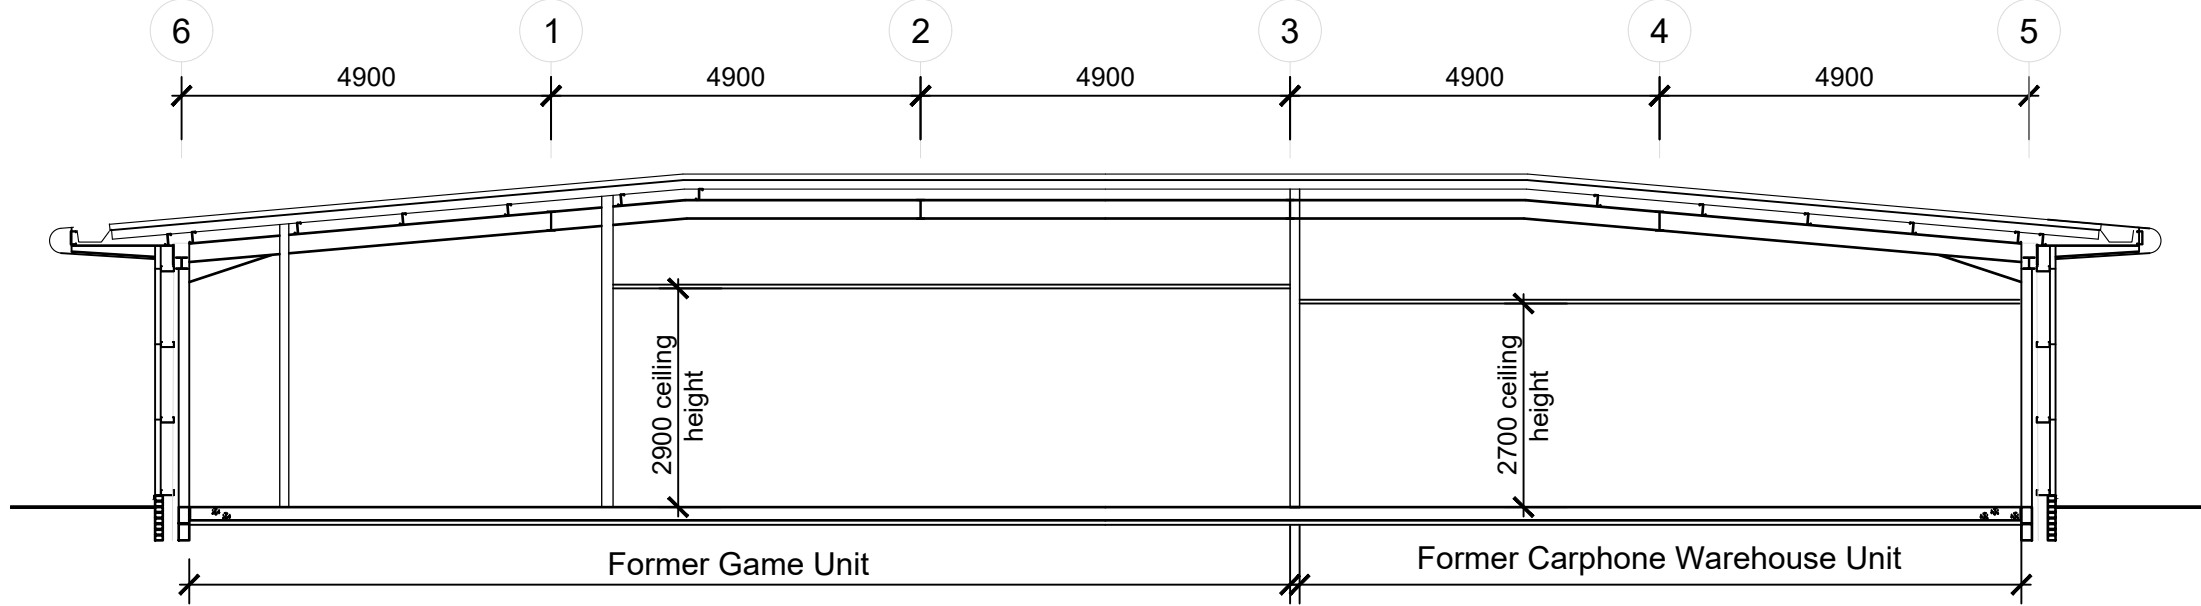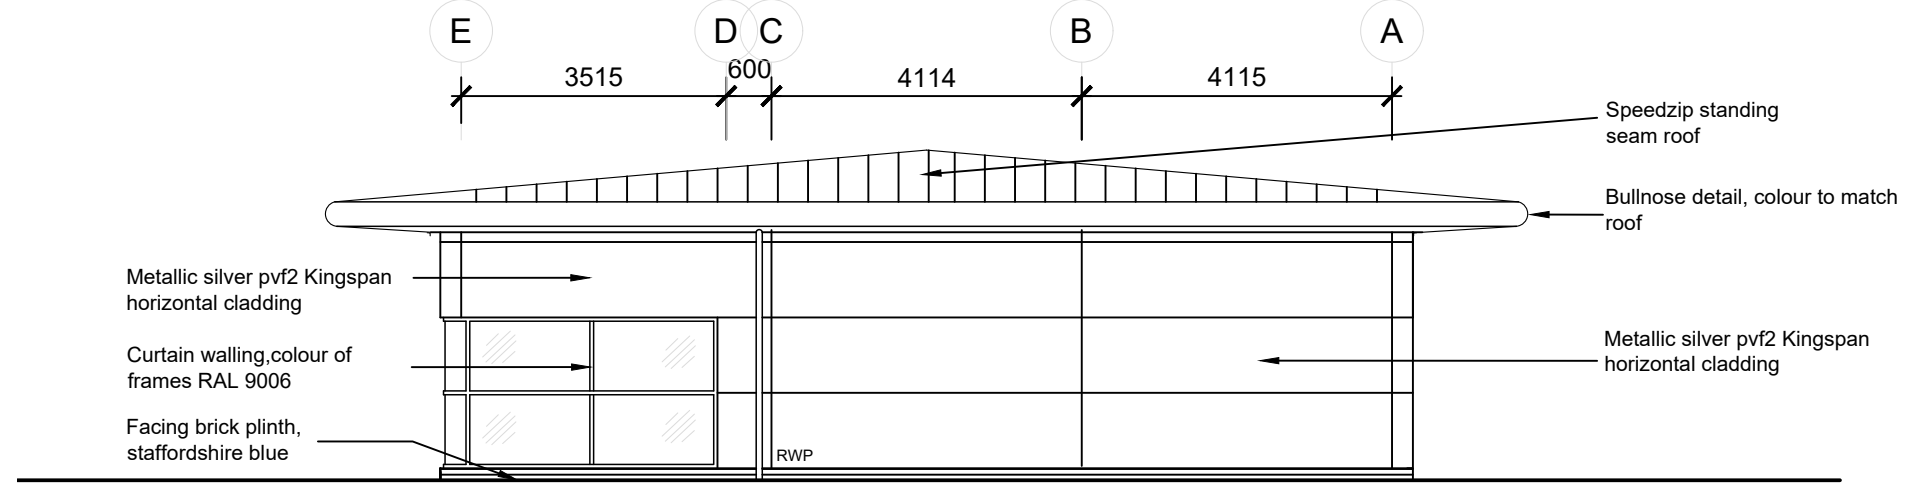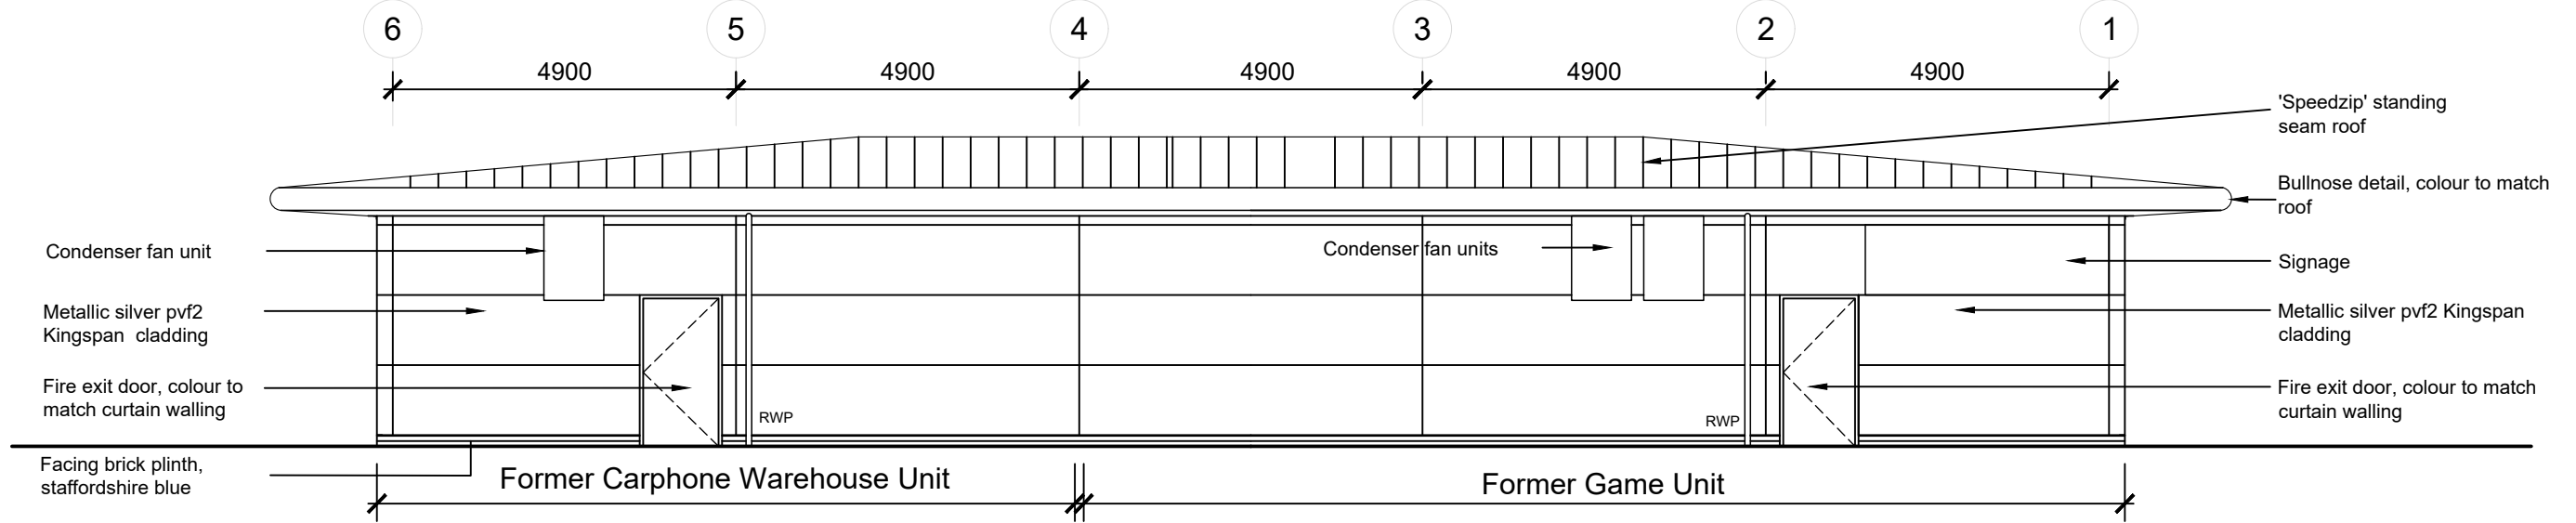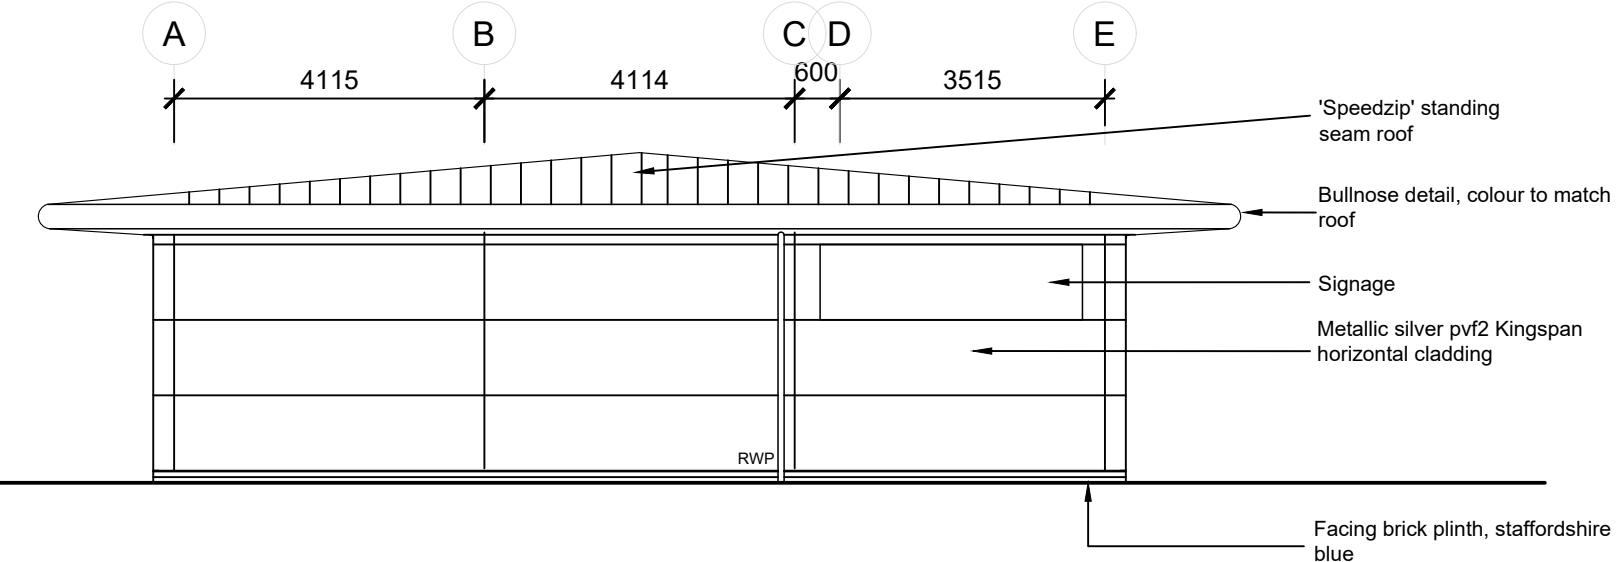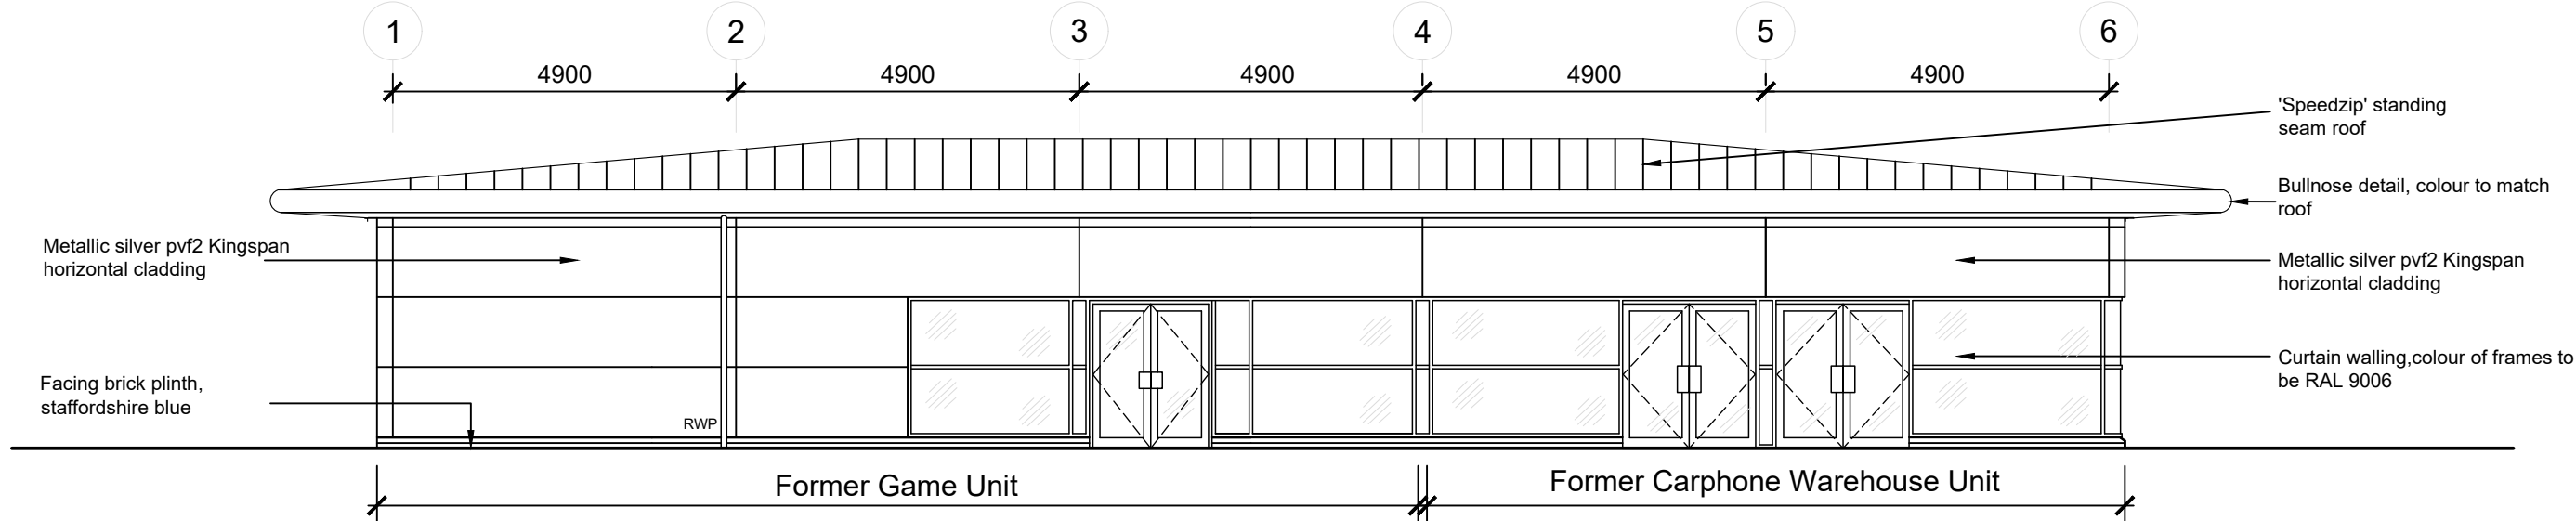

powelldobson
ARCHITECTS

Cardiff Office: Suite 1F, Building One, Eastern Business Park, Wern Fawr Lane, Old St Mellons, Cardiff CF3 5EA
Tel: +44 (0)33 33 201 001 www.powelldobson.com

Contract: Hammerson plc
Former Carphone Warehouse and Game Unit
Title: General Arrangement Plans, Sections, Elevations

Drawing No. G1843-(10)-(20)300 F
Rev. F
Scale: 1:100 @A1
Date: Jan 2004
Drawn: MR
Checked: GB