


1:100

Revisions		
A	Planning rev A	PC 06.09.18
B	Planning rev B	PC 25.10.18
C	Planning rev C	PC 15.02.19
D	Planning rev D	PC 16.01.20
E	As built information added	PC 12.04.23

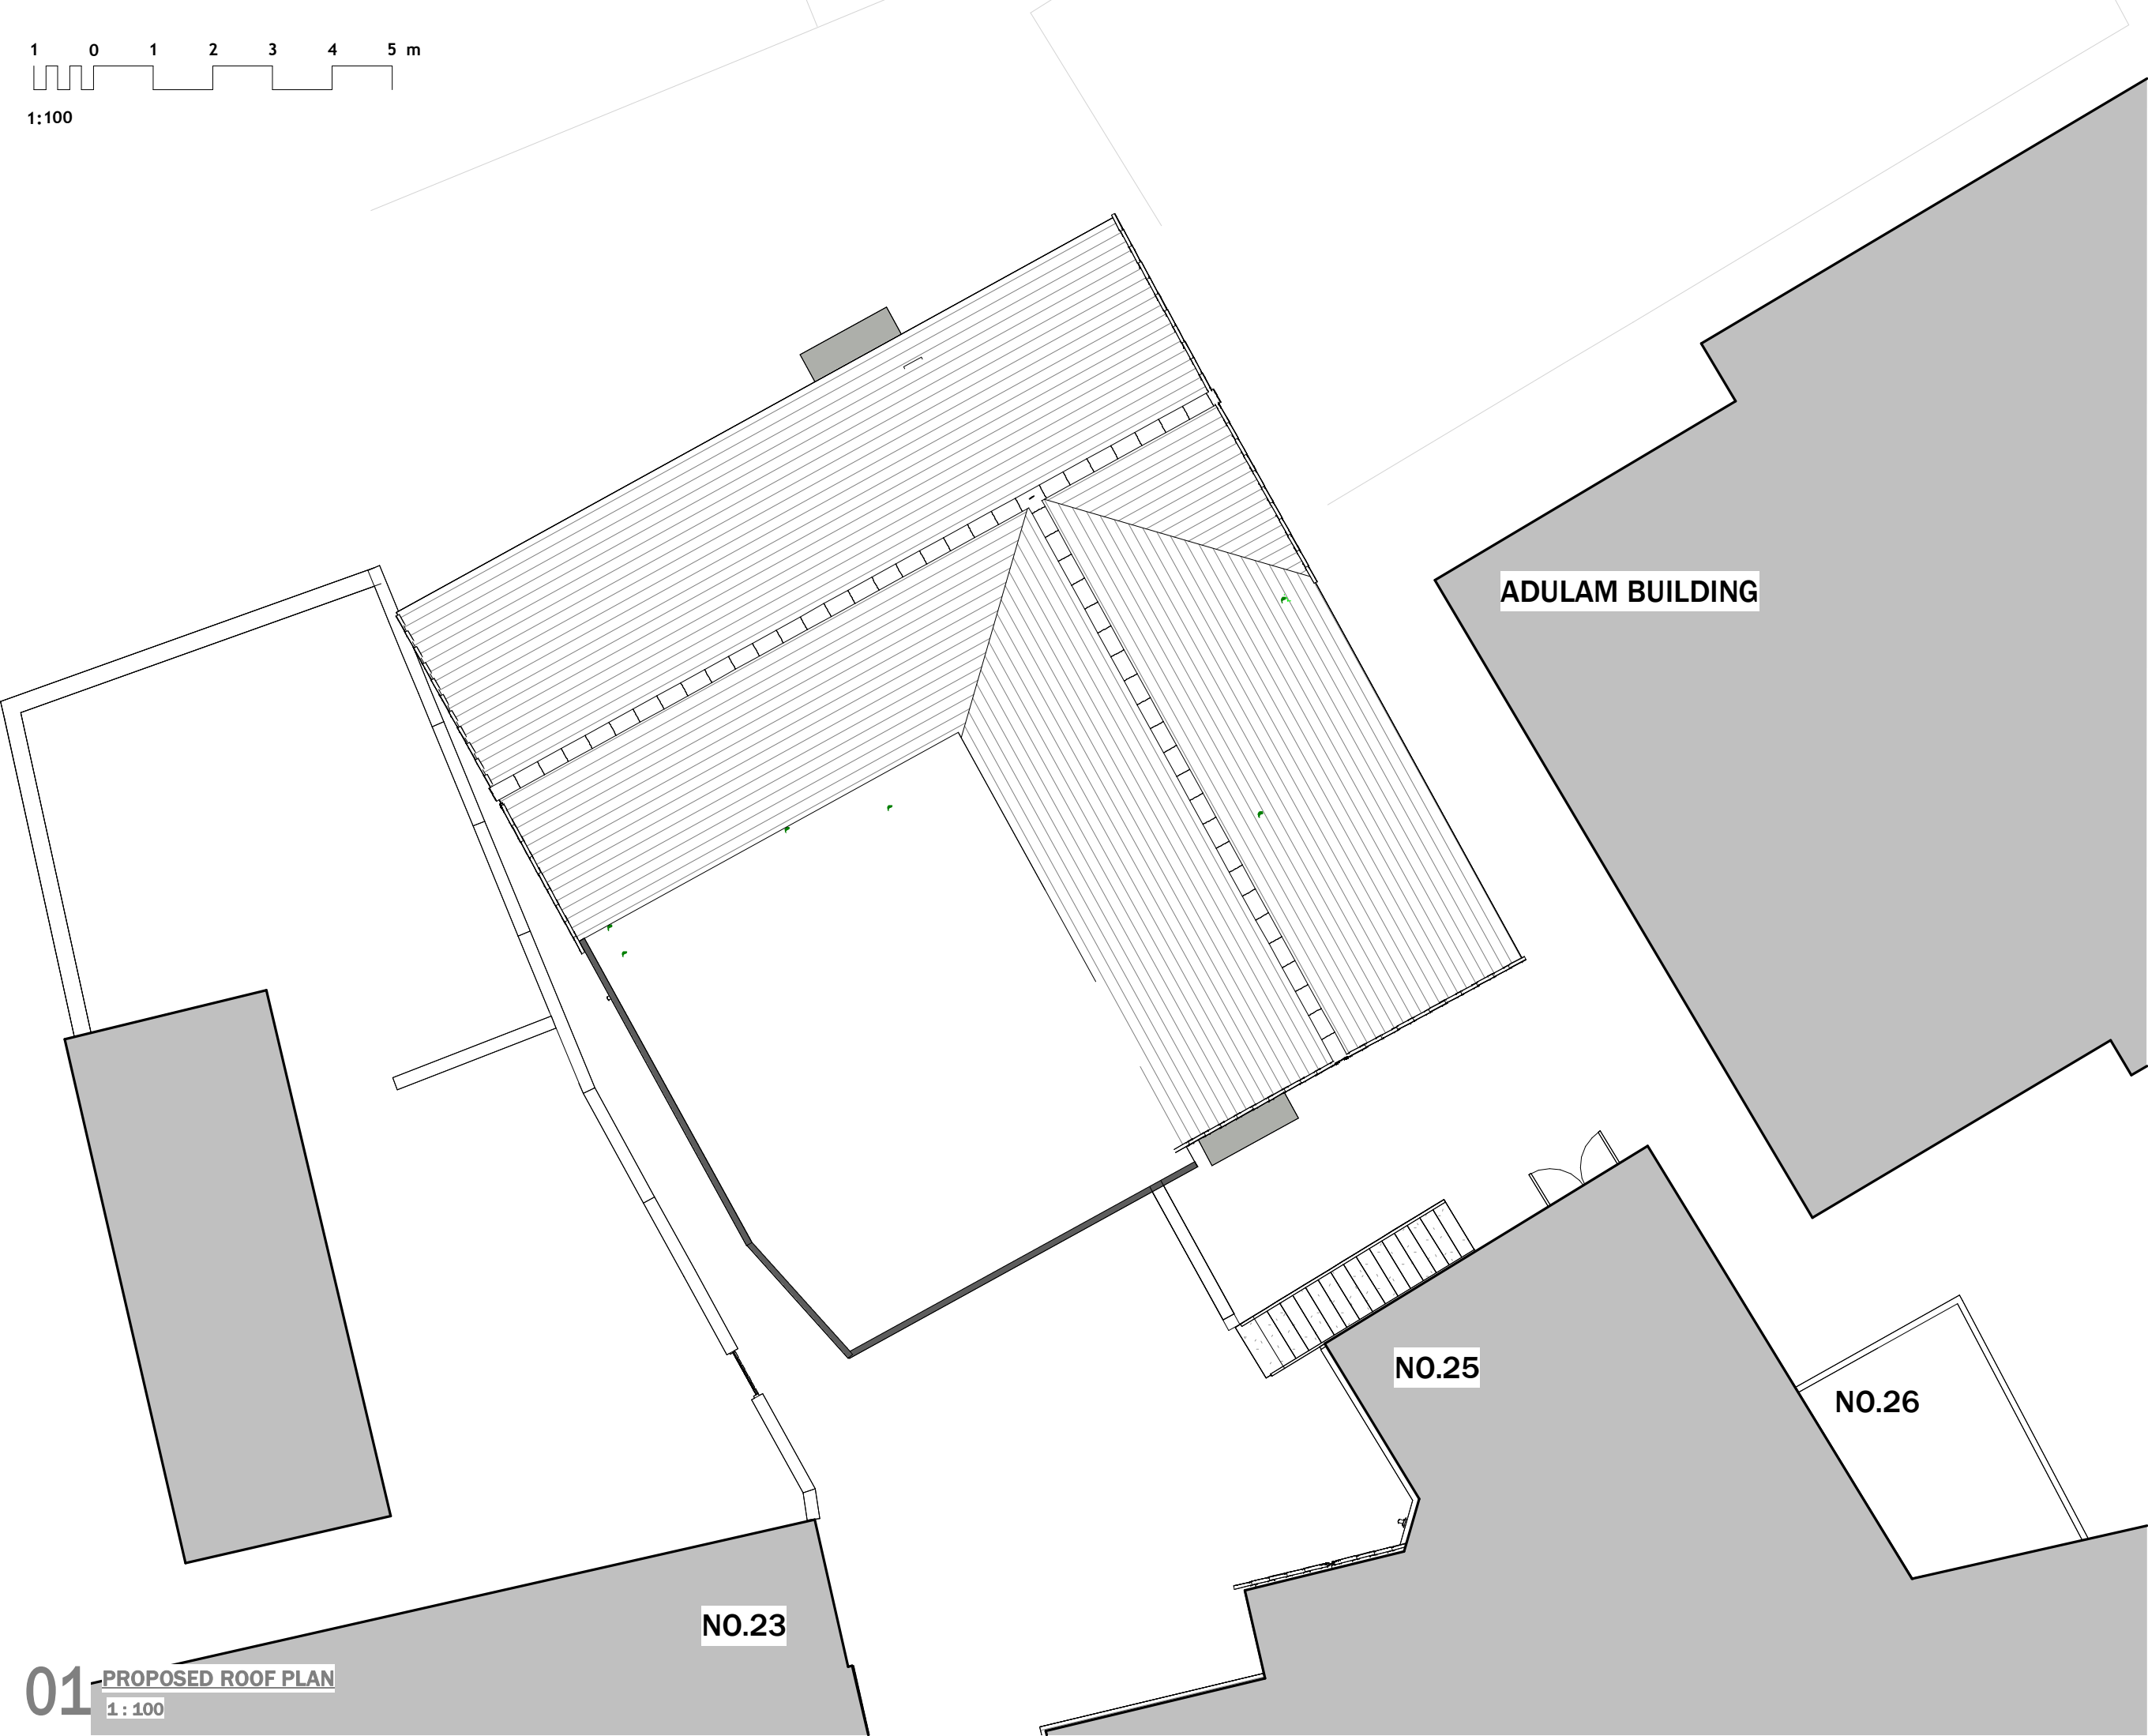

Notes

Do not scale from this drawing. Use figured dimensions only, which are displayed in millimeters unless stated otherwise. The contractor is requested to check all dimensions before work is put in hand. Any discrepancies within the drawing should be reported prior to commencement of works.

Copyright of this drawing belongs solely to CMKA Ltd. This drawing must only be used for the purpose for which it is supplied and its contents must not be reproduced for any purpose without written permission.

CHAMBERLAIN
MOSS
KING
architecture

97a Glebe Street | Penarth
Vale of Glamorgan | CF64 1EE
T. 02920 306400
chamberlainingmoss.co.uk

Project	FORMER CAB BUILDING, ADJACENT GARAGE BUILDING & 24-25 LOWER THOMAS STREET, MERTHYR TYDFIL
Project number	L779
Client	MTHA
Title	PROPOSED ROOF PLAN
Drawing number	A107
Scale	1 : 100 at A3
Revision	E
Status	PLANNING
Drawn	PC
Date	12.04.23