


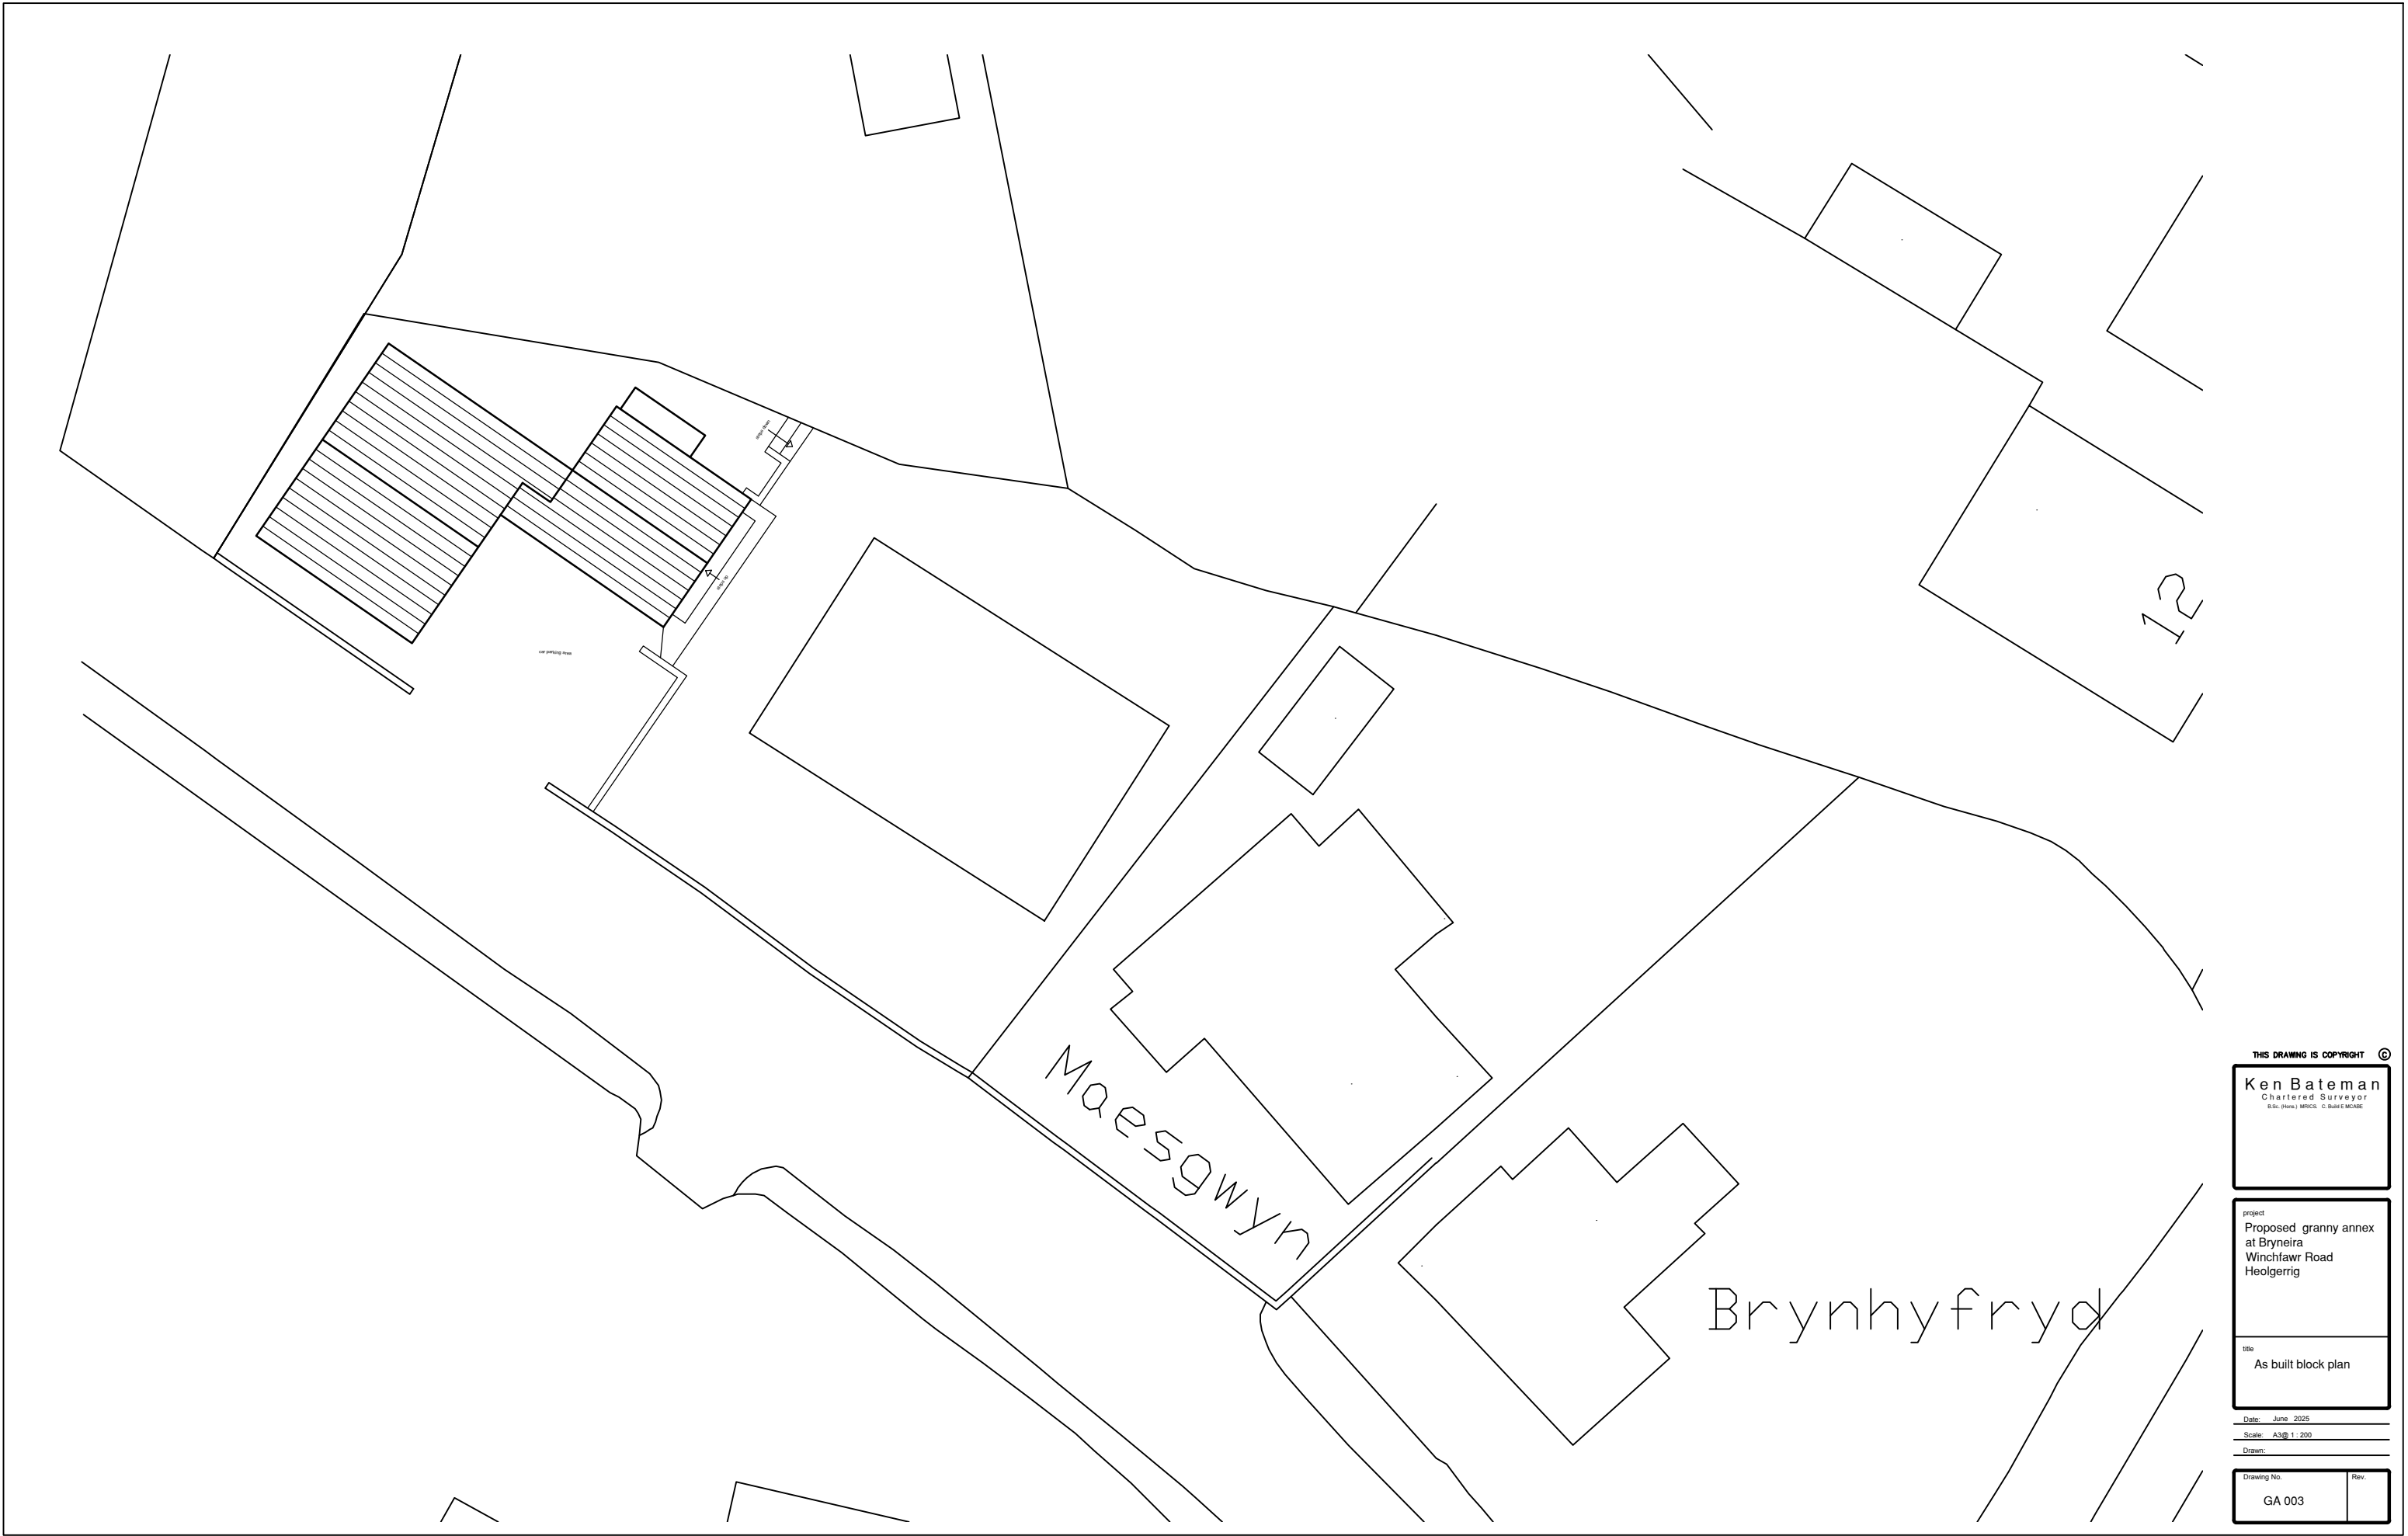

THIS DRAWING IS COPYRIGHT ©

Ken Bateman
Chartered Surveyor
R.S. (Pens.) M.RICS. C. Bulfinch M.A.

project
Proposed granny annex
at Bryneira
Winchfawr Road
Heolgerrig

site
As built block plan

Date: June 2025

Scale: A3 @ 1:200

Drawn:

Drawing No. Rev.

GA 003