



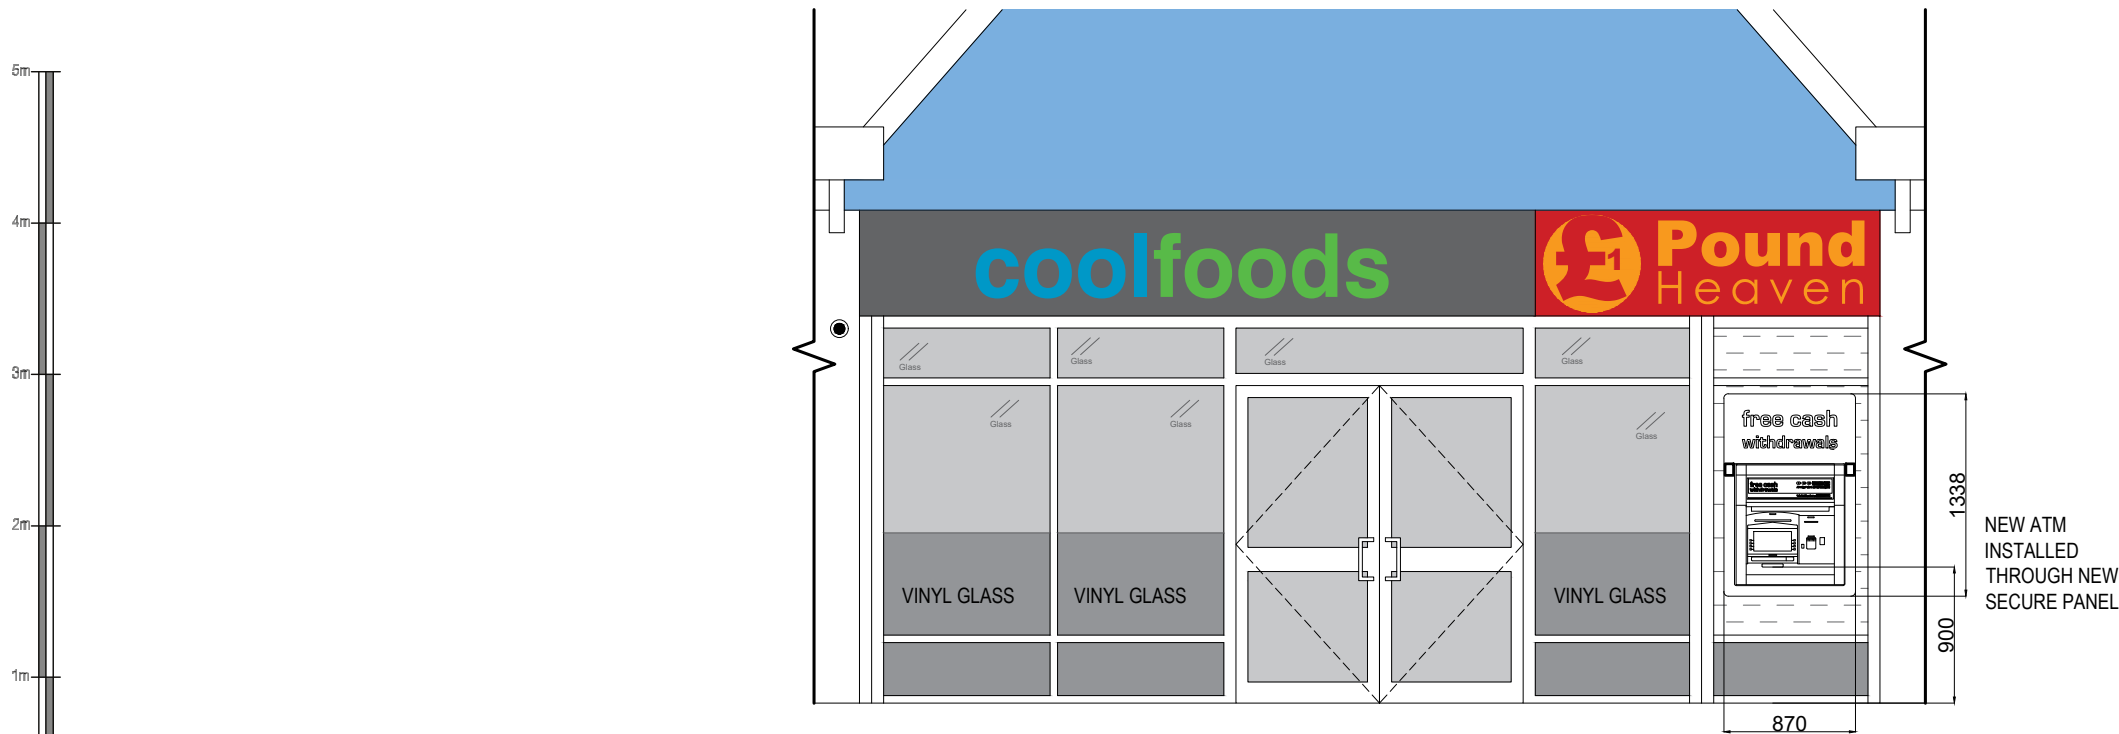

AS-INSTALLED FRONT ELEVATION

Scale 1:50

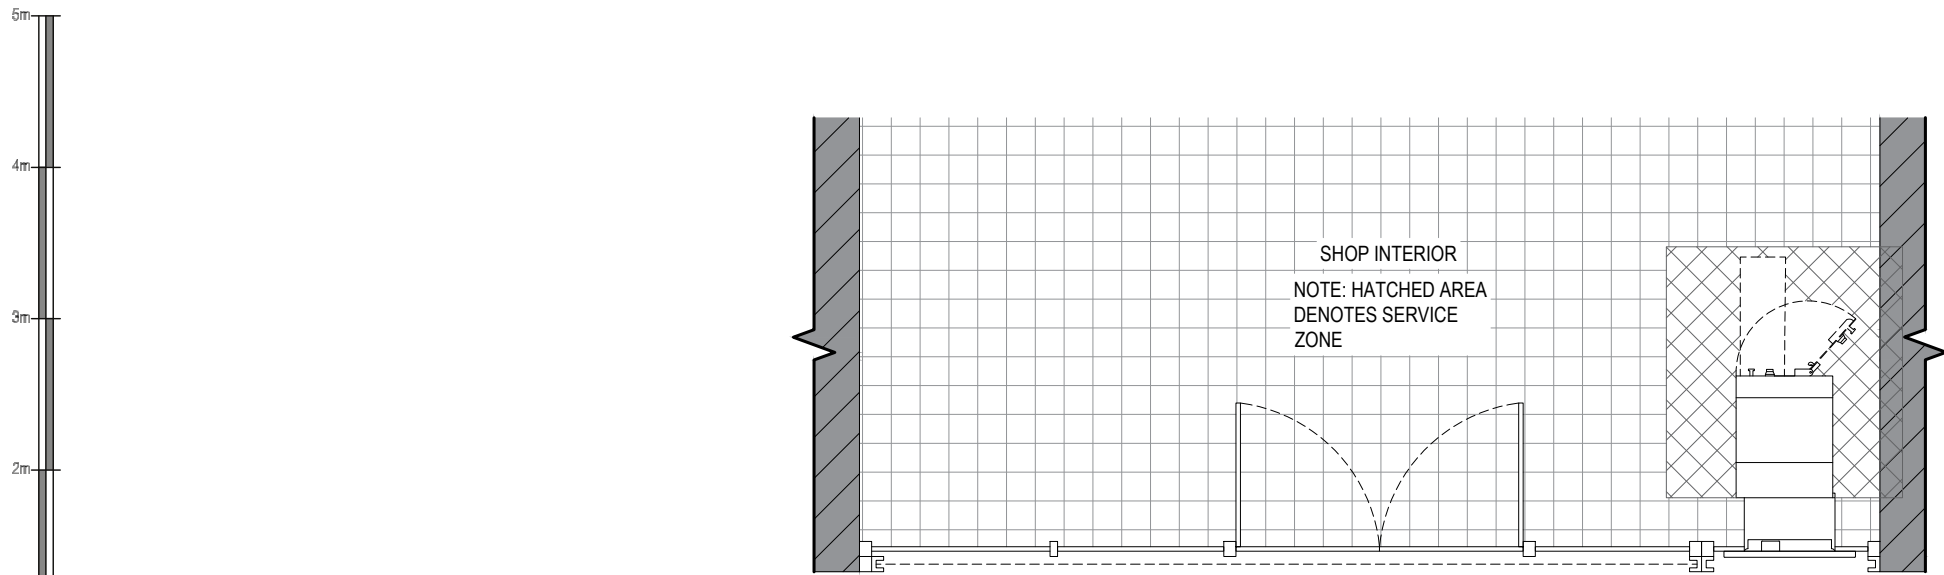

AS-INSTALLED PART PLAN

Scale 1:50

Date: Comments: By:

GENERAL NOTES:
1) All dimensions in millimeters unless otherwise stated.

Site:
Cool Foods,
9 Chestnut Way,
Merthyr Tydfil,
CF47 9SB

Drawing Title:
As-Installed Plan and Elevation

Ref: T019862_AI	Date: 08/04/2020	Rev:
Scale: 1:50	Paper: A3	Date Rev: