

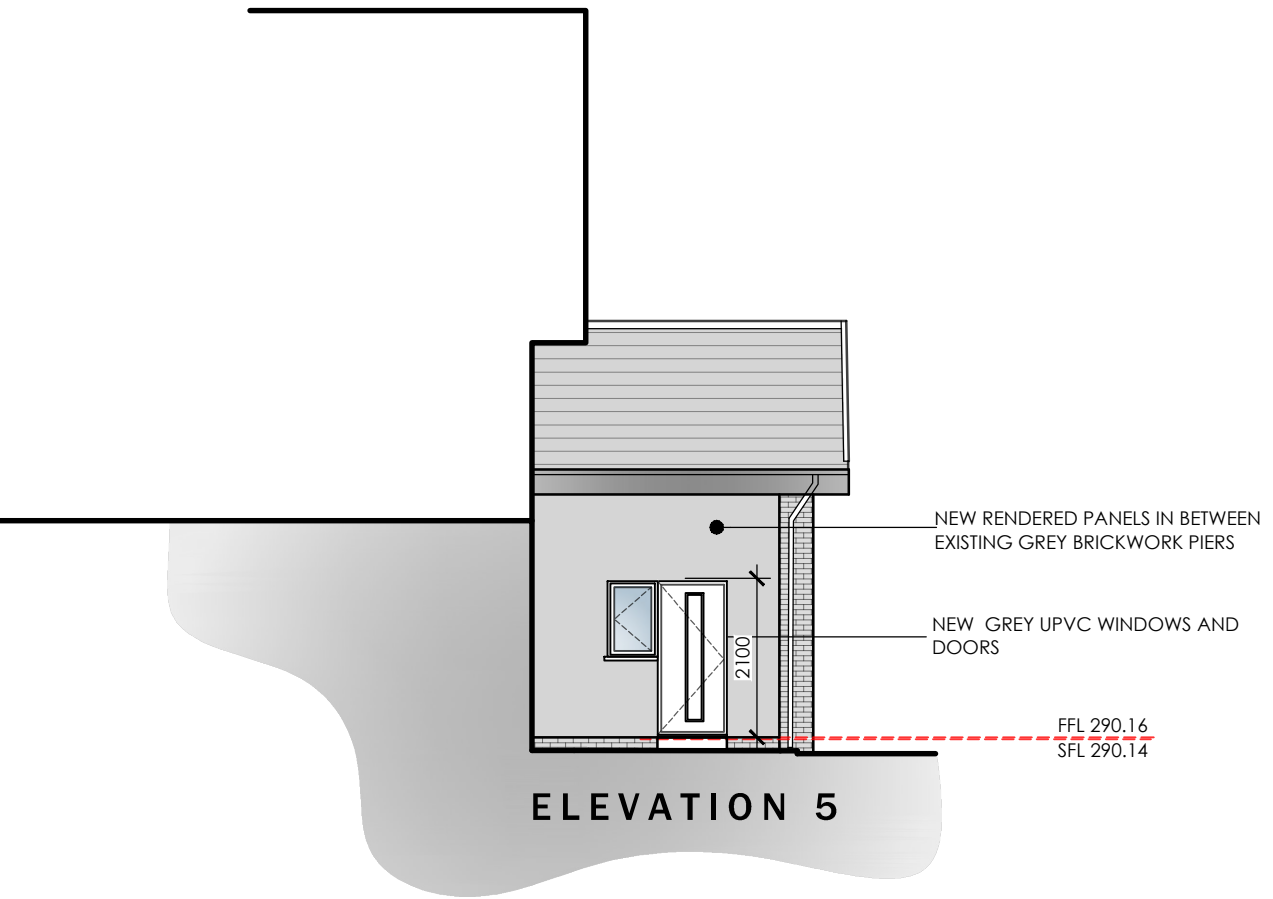
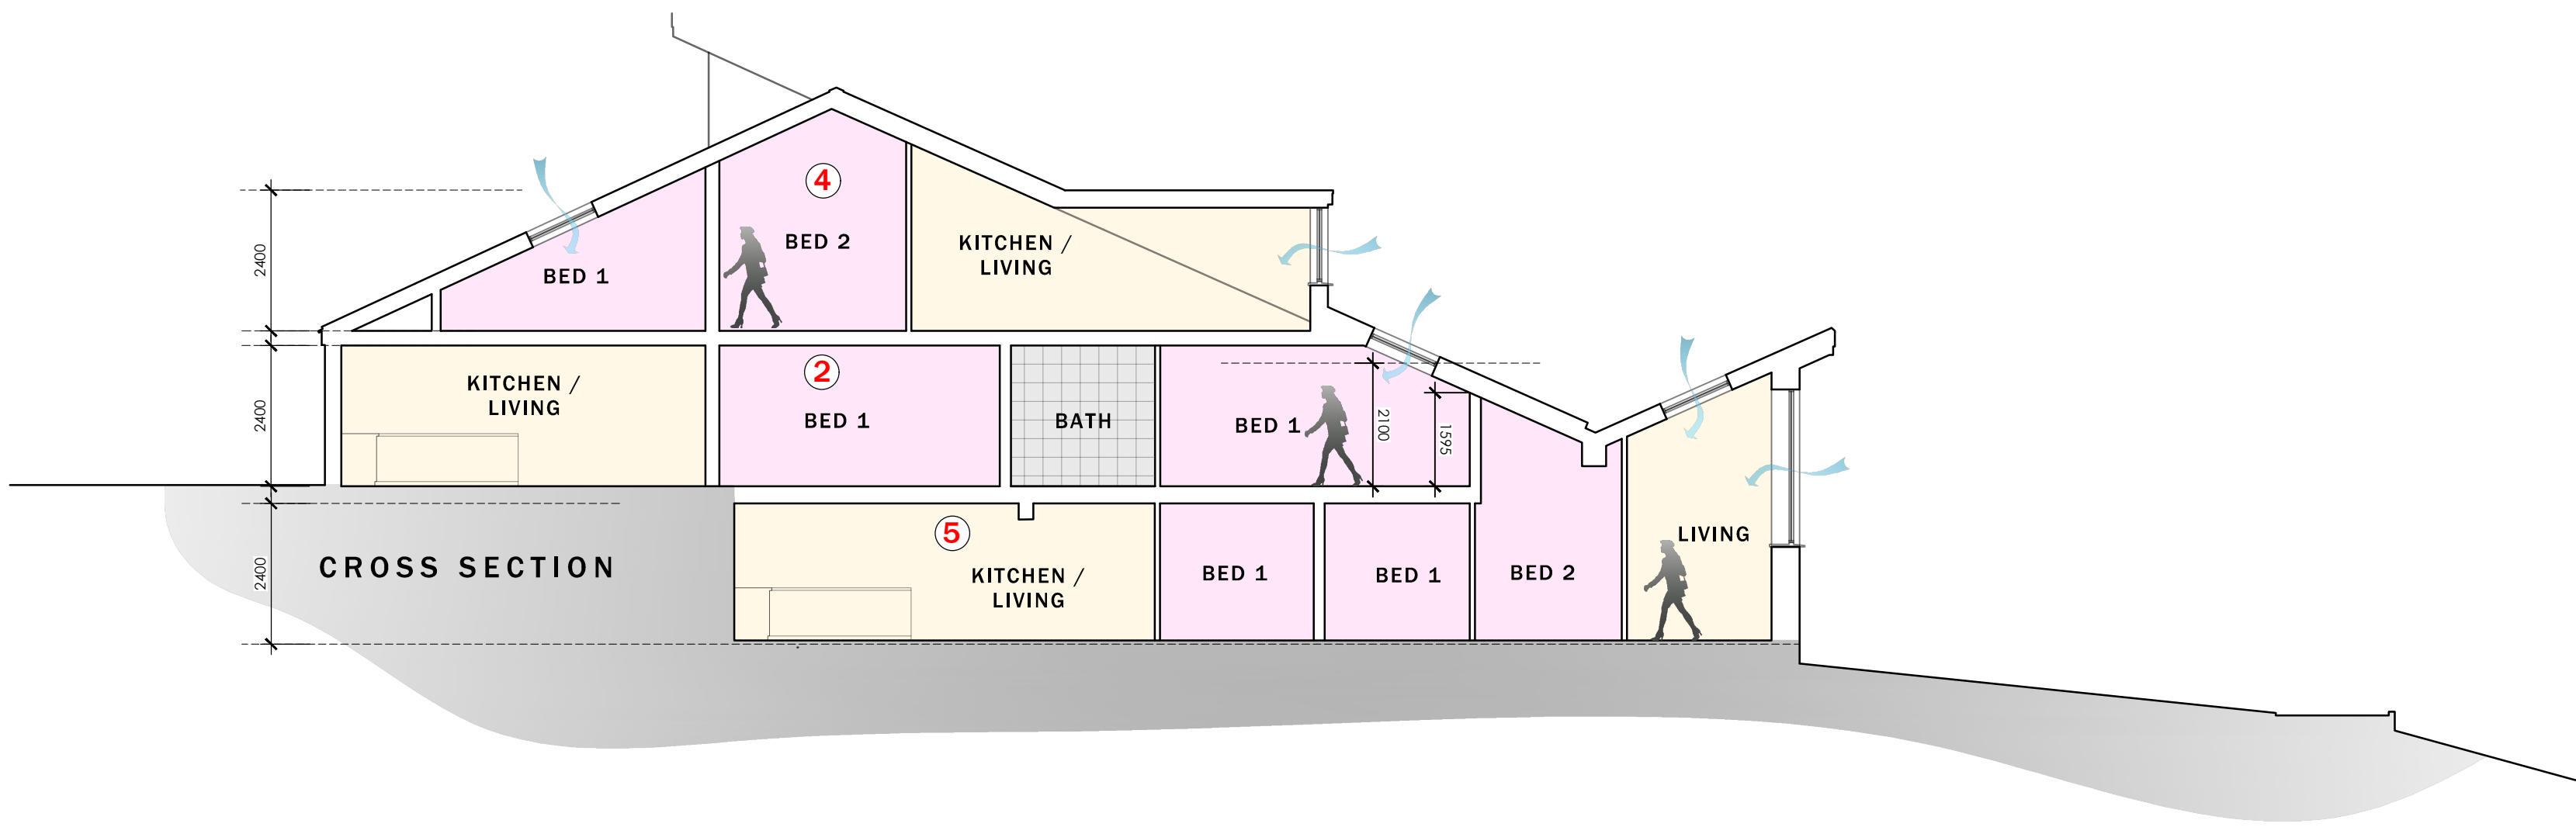
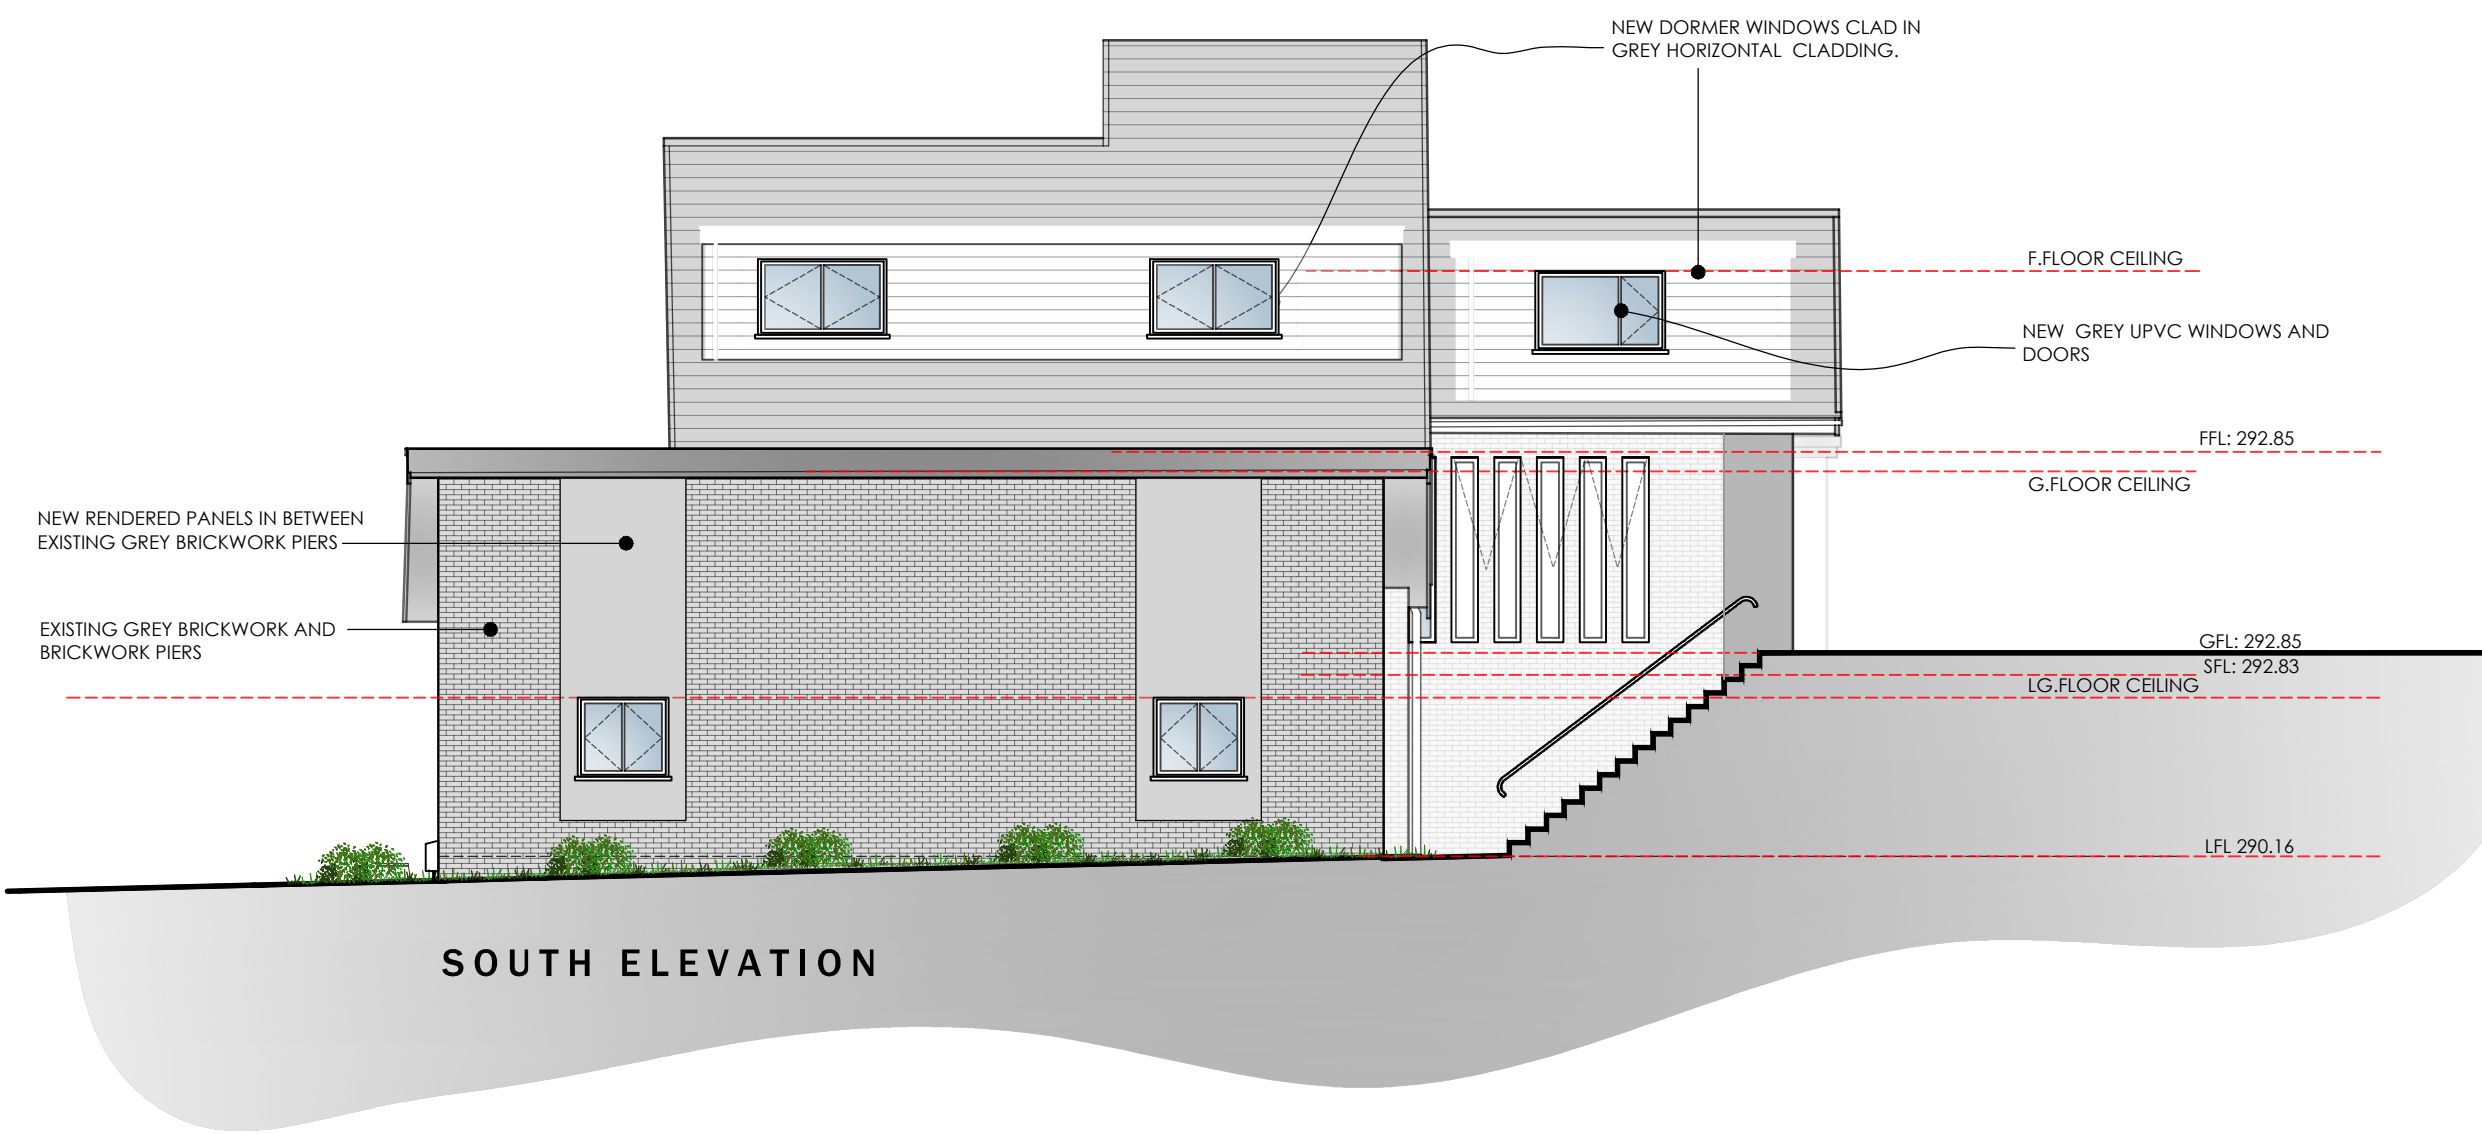
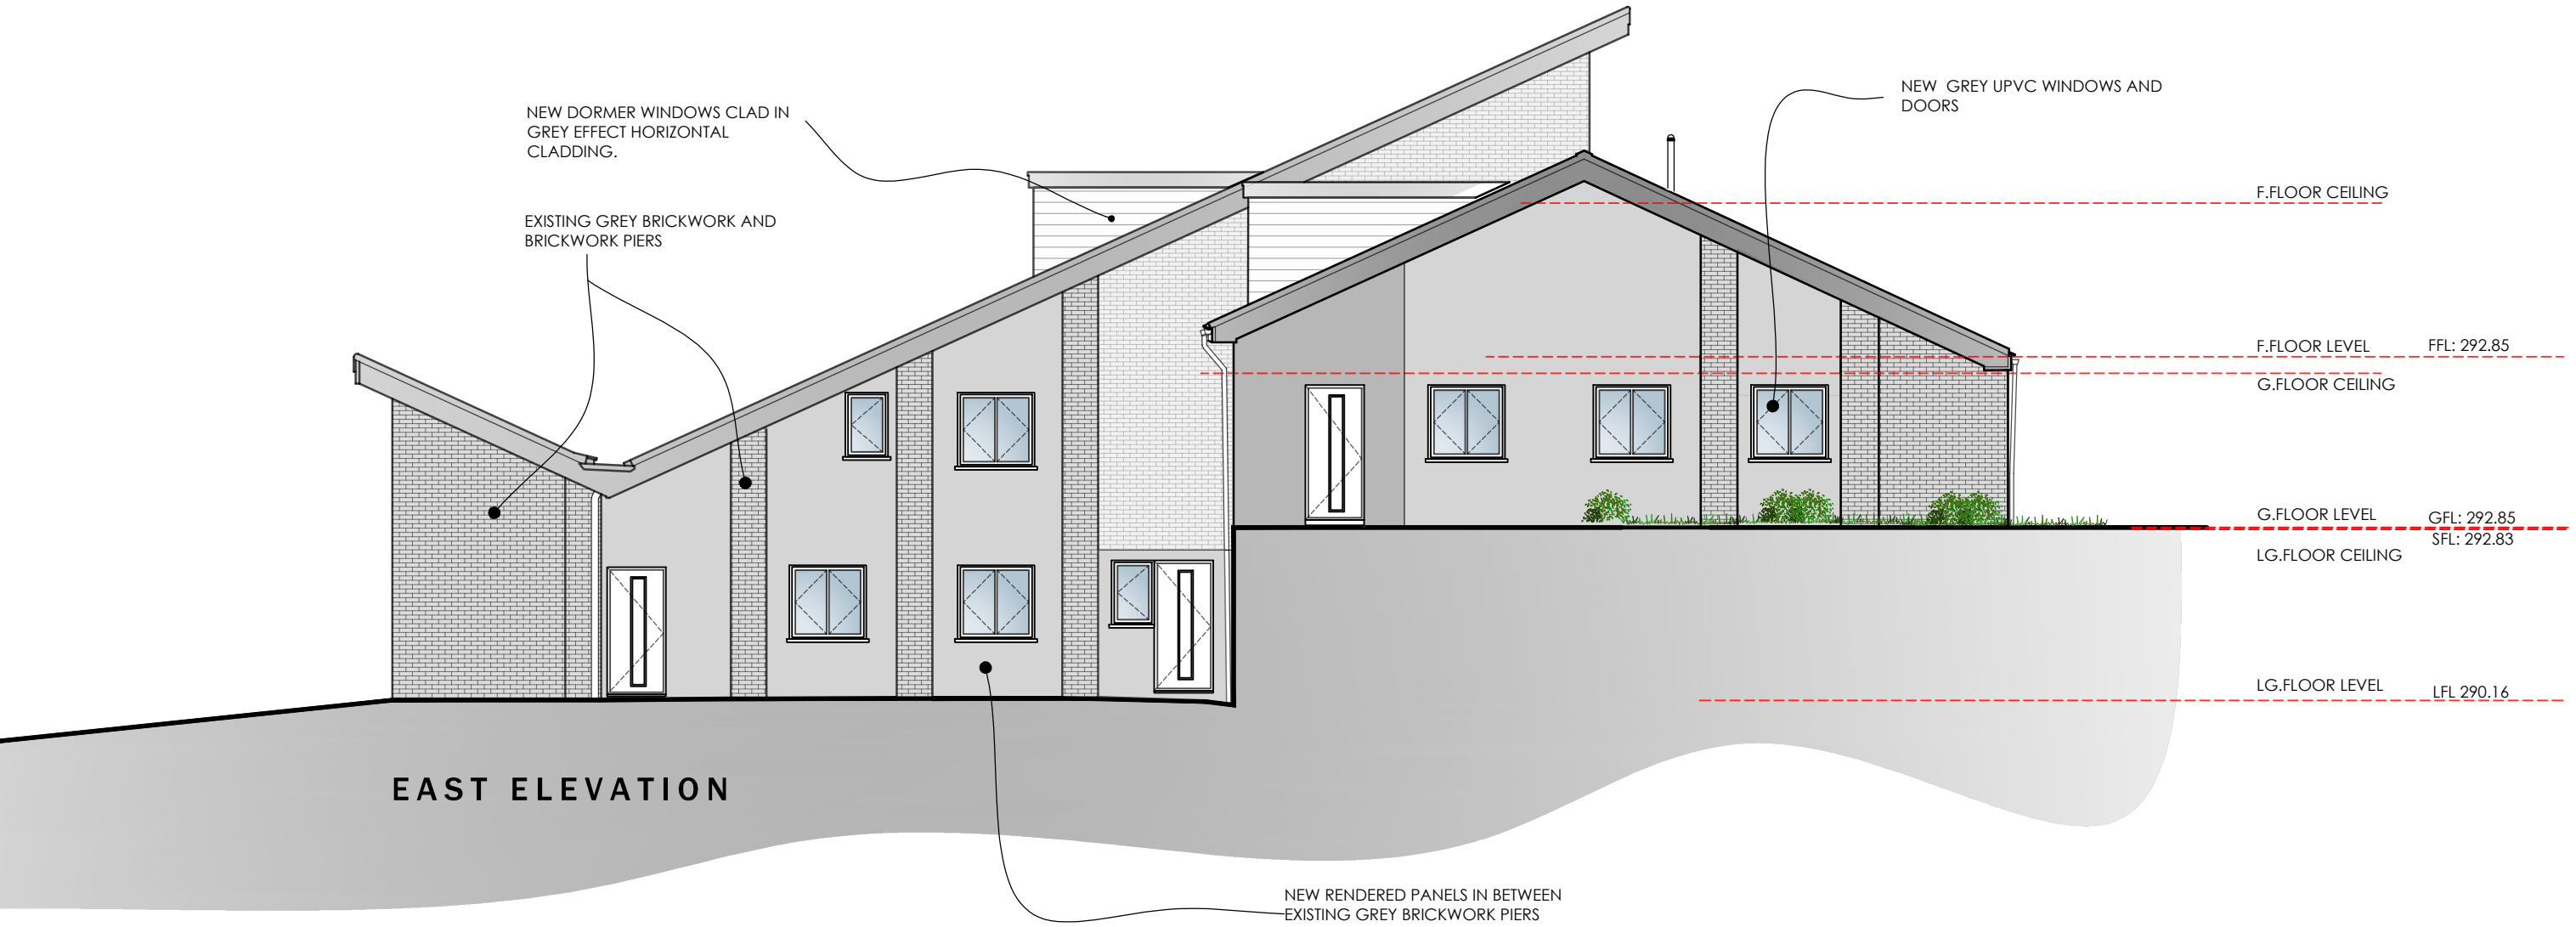
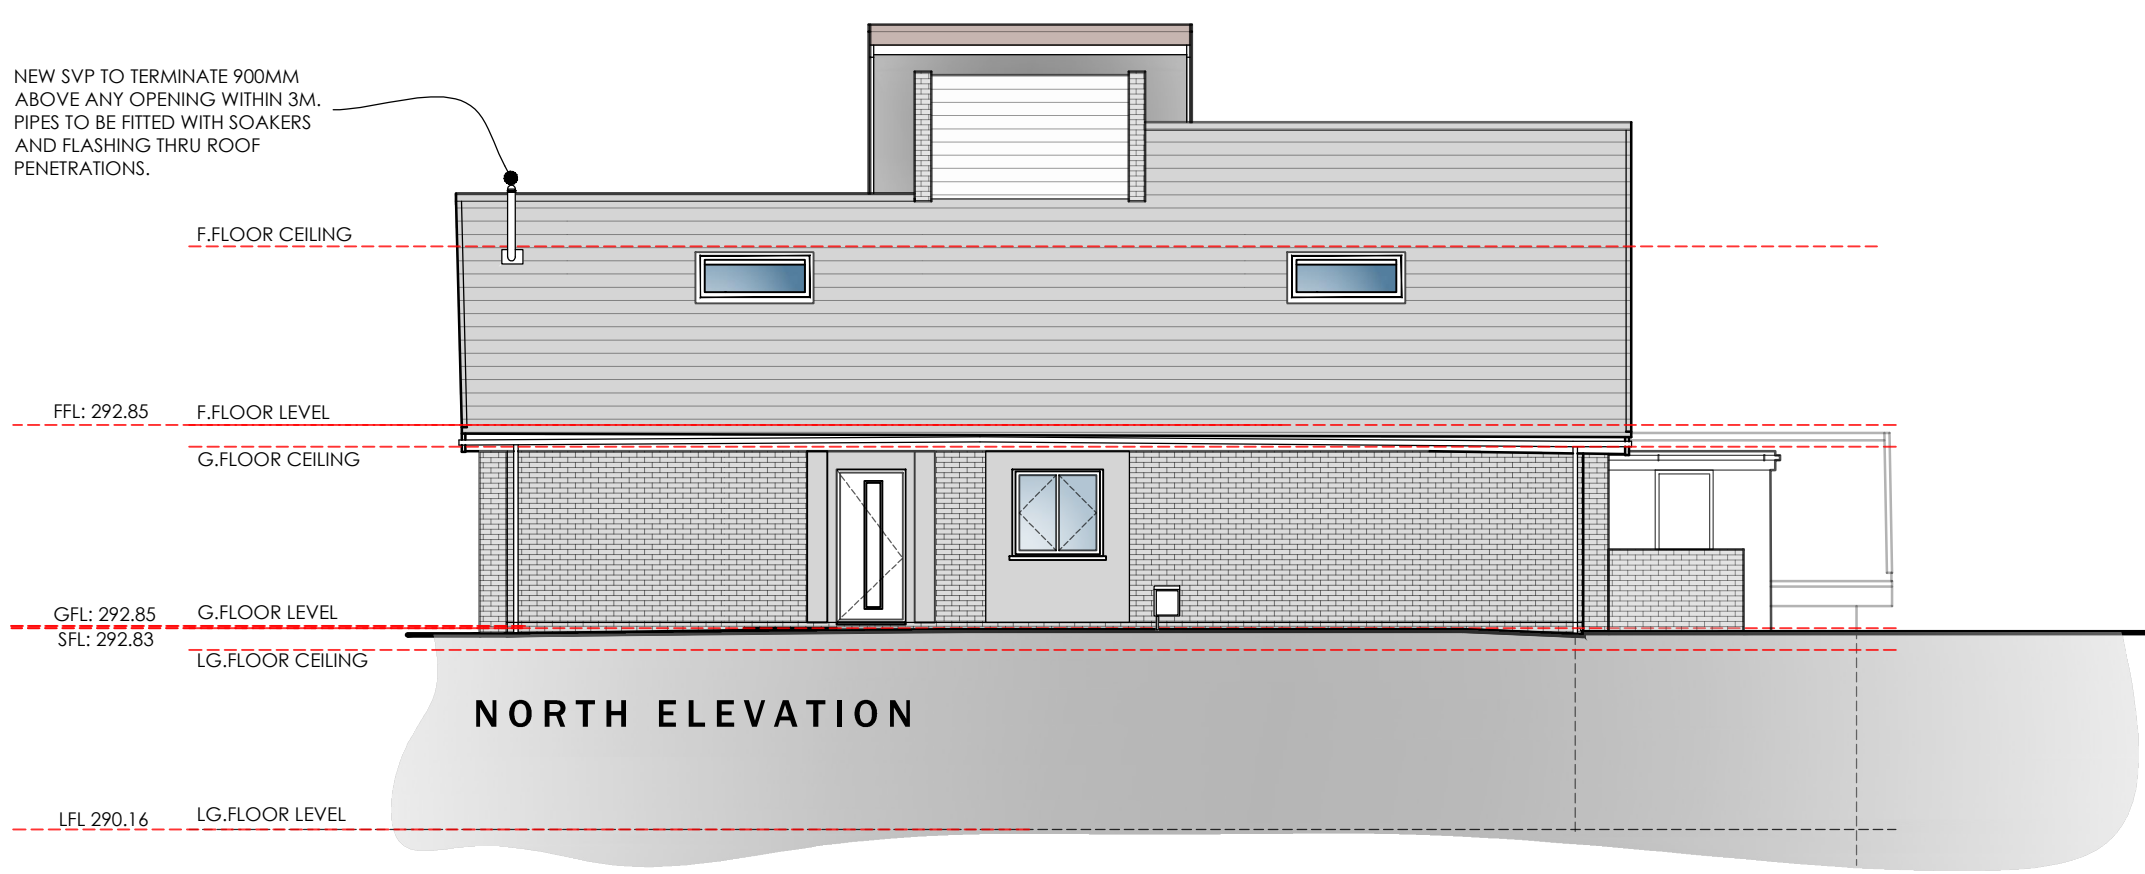


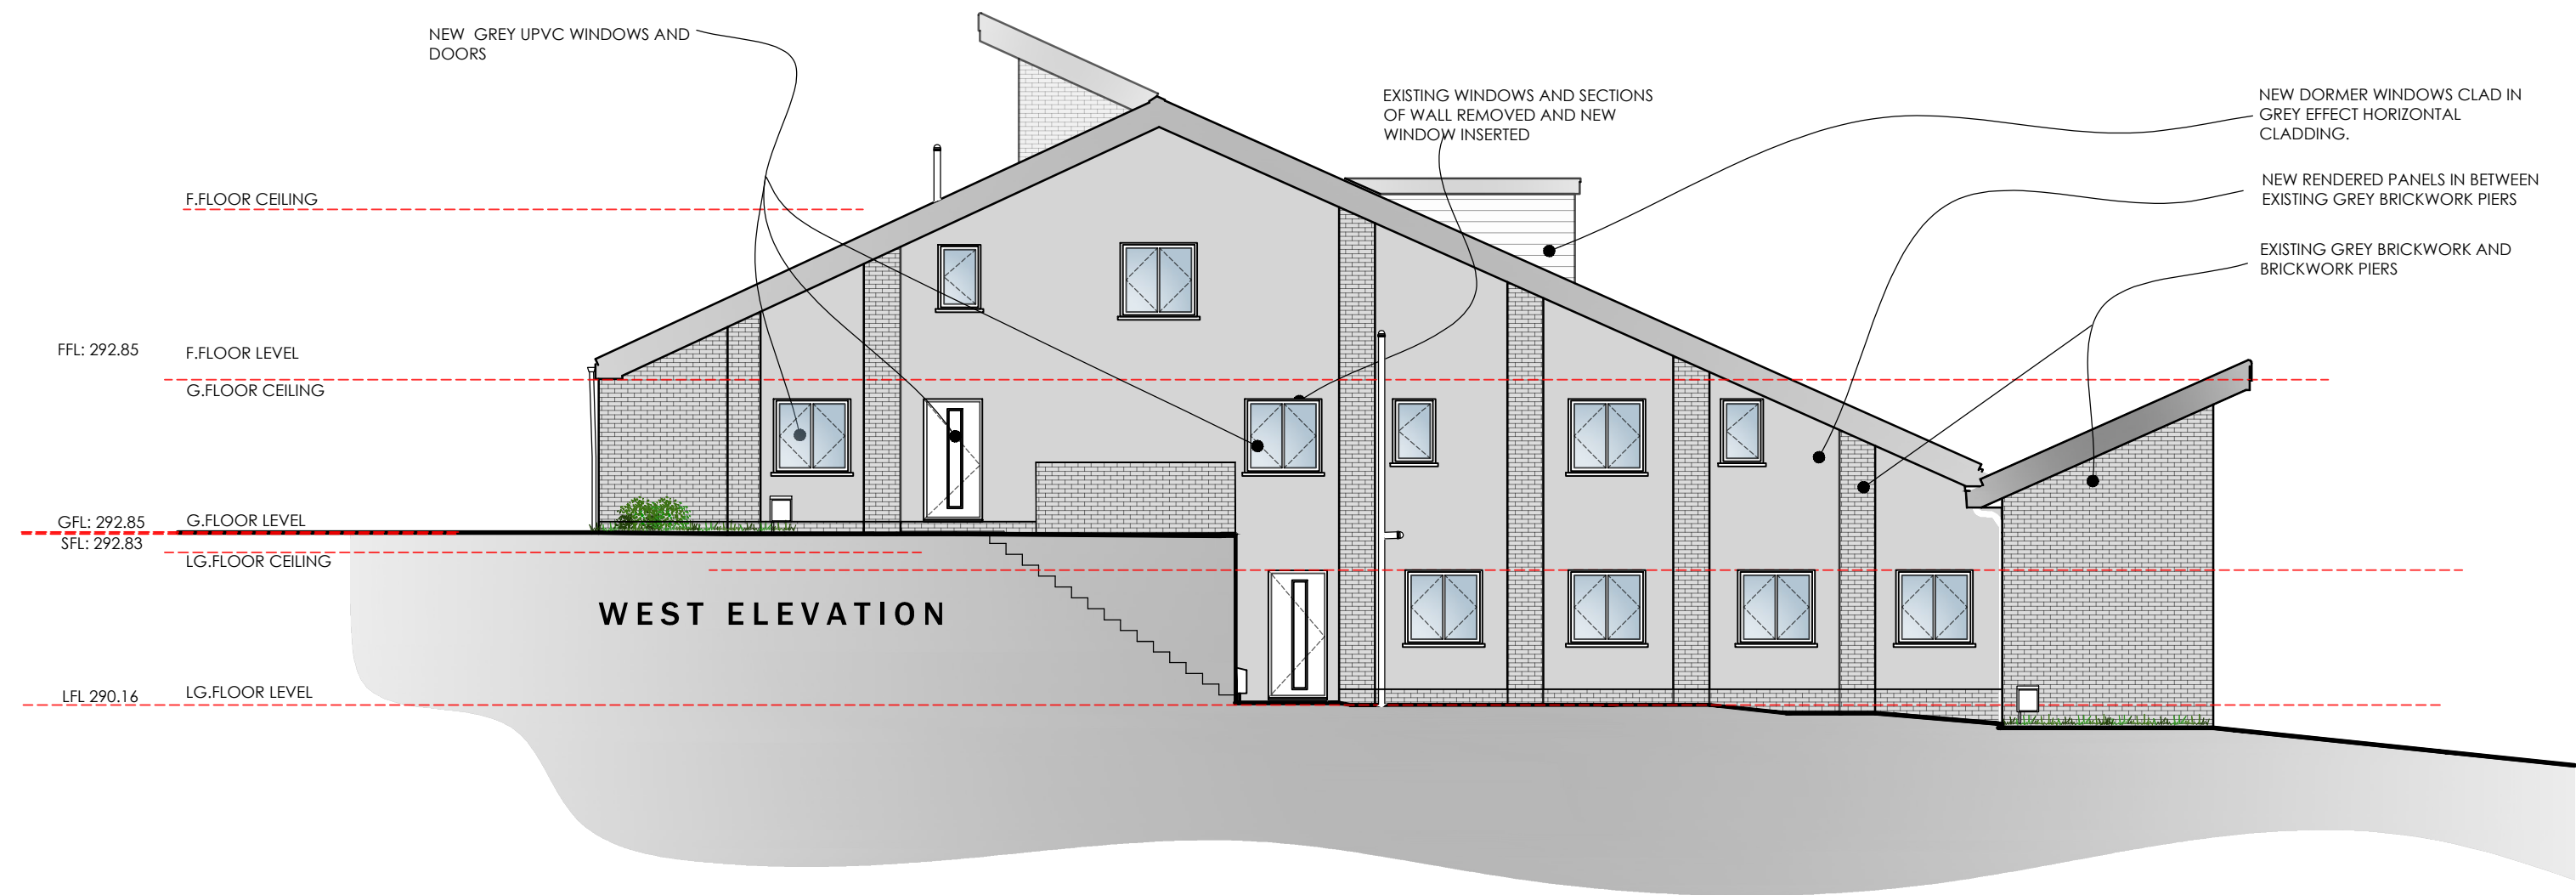

PROPOSED ELEVATIONS

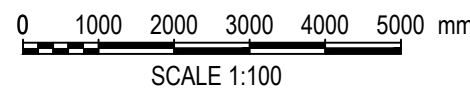

Do not scale from this drawing. The users of this drawing shall check all dimensions & report all errors and omissions to Letrucode Design.

REV G - OCT 22 FURTHER CHANGES TO BRD AND BAT BOX LOCATIONS
REV H - JUNE 24 DRAWING UPDATED TO SUIT AS BUILT SITUATION

REV D - JUNE 22 ADDITIONAL BRD BOXES ADDED AS PER BAT REPORT
REV E - JULY 22 BRD BOXES RELOCATED WALL LIGHTS ADDED
REV F - SEPT 22 WALL LIGHTS REMOVED.

Revisions
REV A - NOV 21 REVISIONS TO SUIT CLIENT COMMENTS
REV B - APR 22 REVISIONS TO SUIT PRE-PLANNING APPLICATION COMMENTS
REV C - APR 22 ELEVATION TITLE UPDATED TO INCLUDE COMPASS ANNOTATION

Drawing No	Scale	Revision
LT2116.04.02	1:100 @A1	H
Drawing Title	Date	Checked
Proposed Elevations	Oct 21	KWL
Client	Job Title	
Mr A Thomas	Wesley Chapel, Dowlais	

LeTrucode
ARCHITECTURE

Suite 7, 35 Stow Park Circle
Newport, NP20 4HF

Tel: 07710390800 / 07710390801
info@letrucode.co.uk
www.letrucode.co.uk