


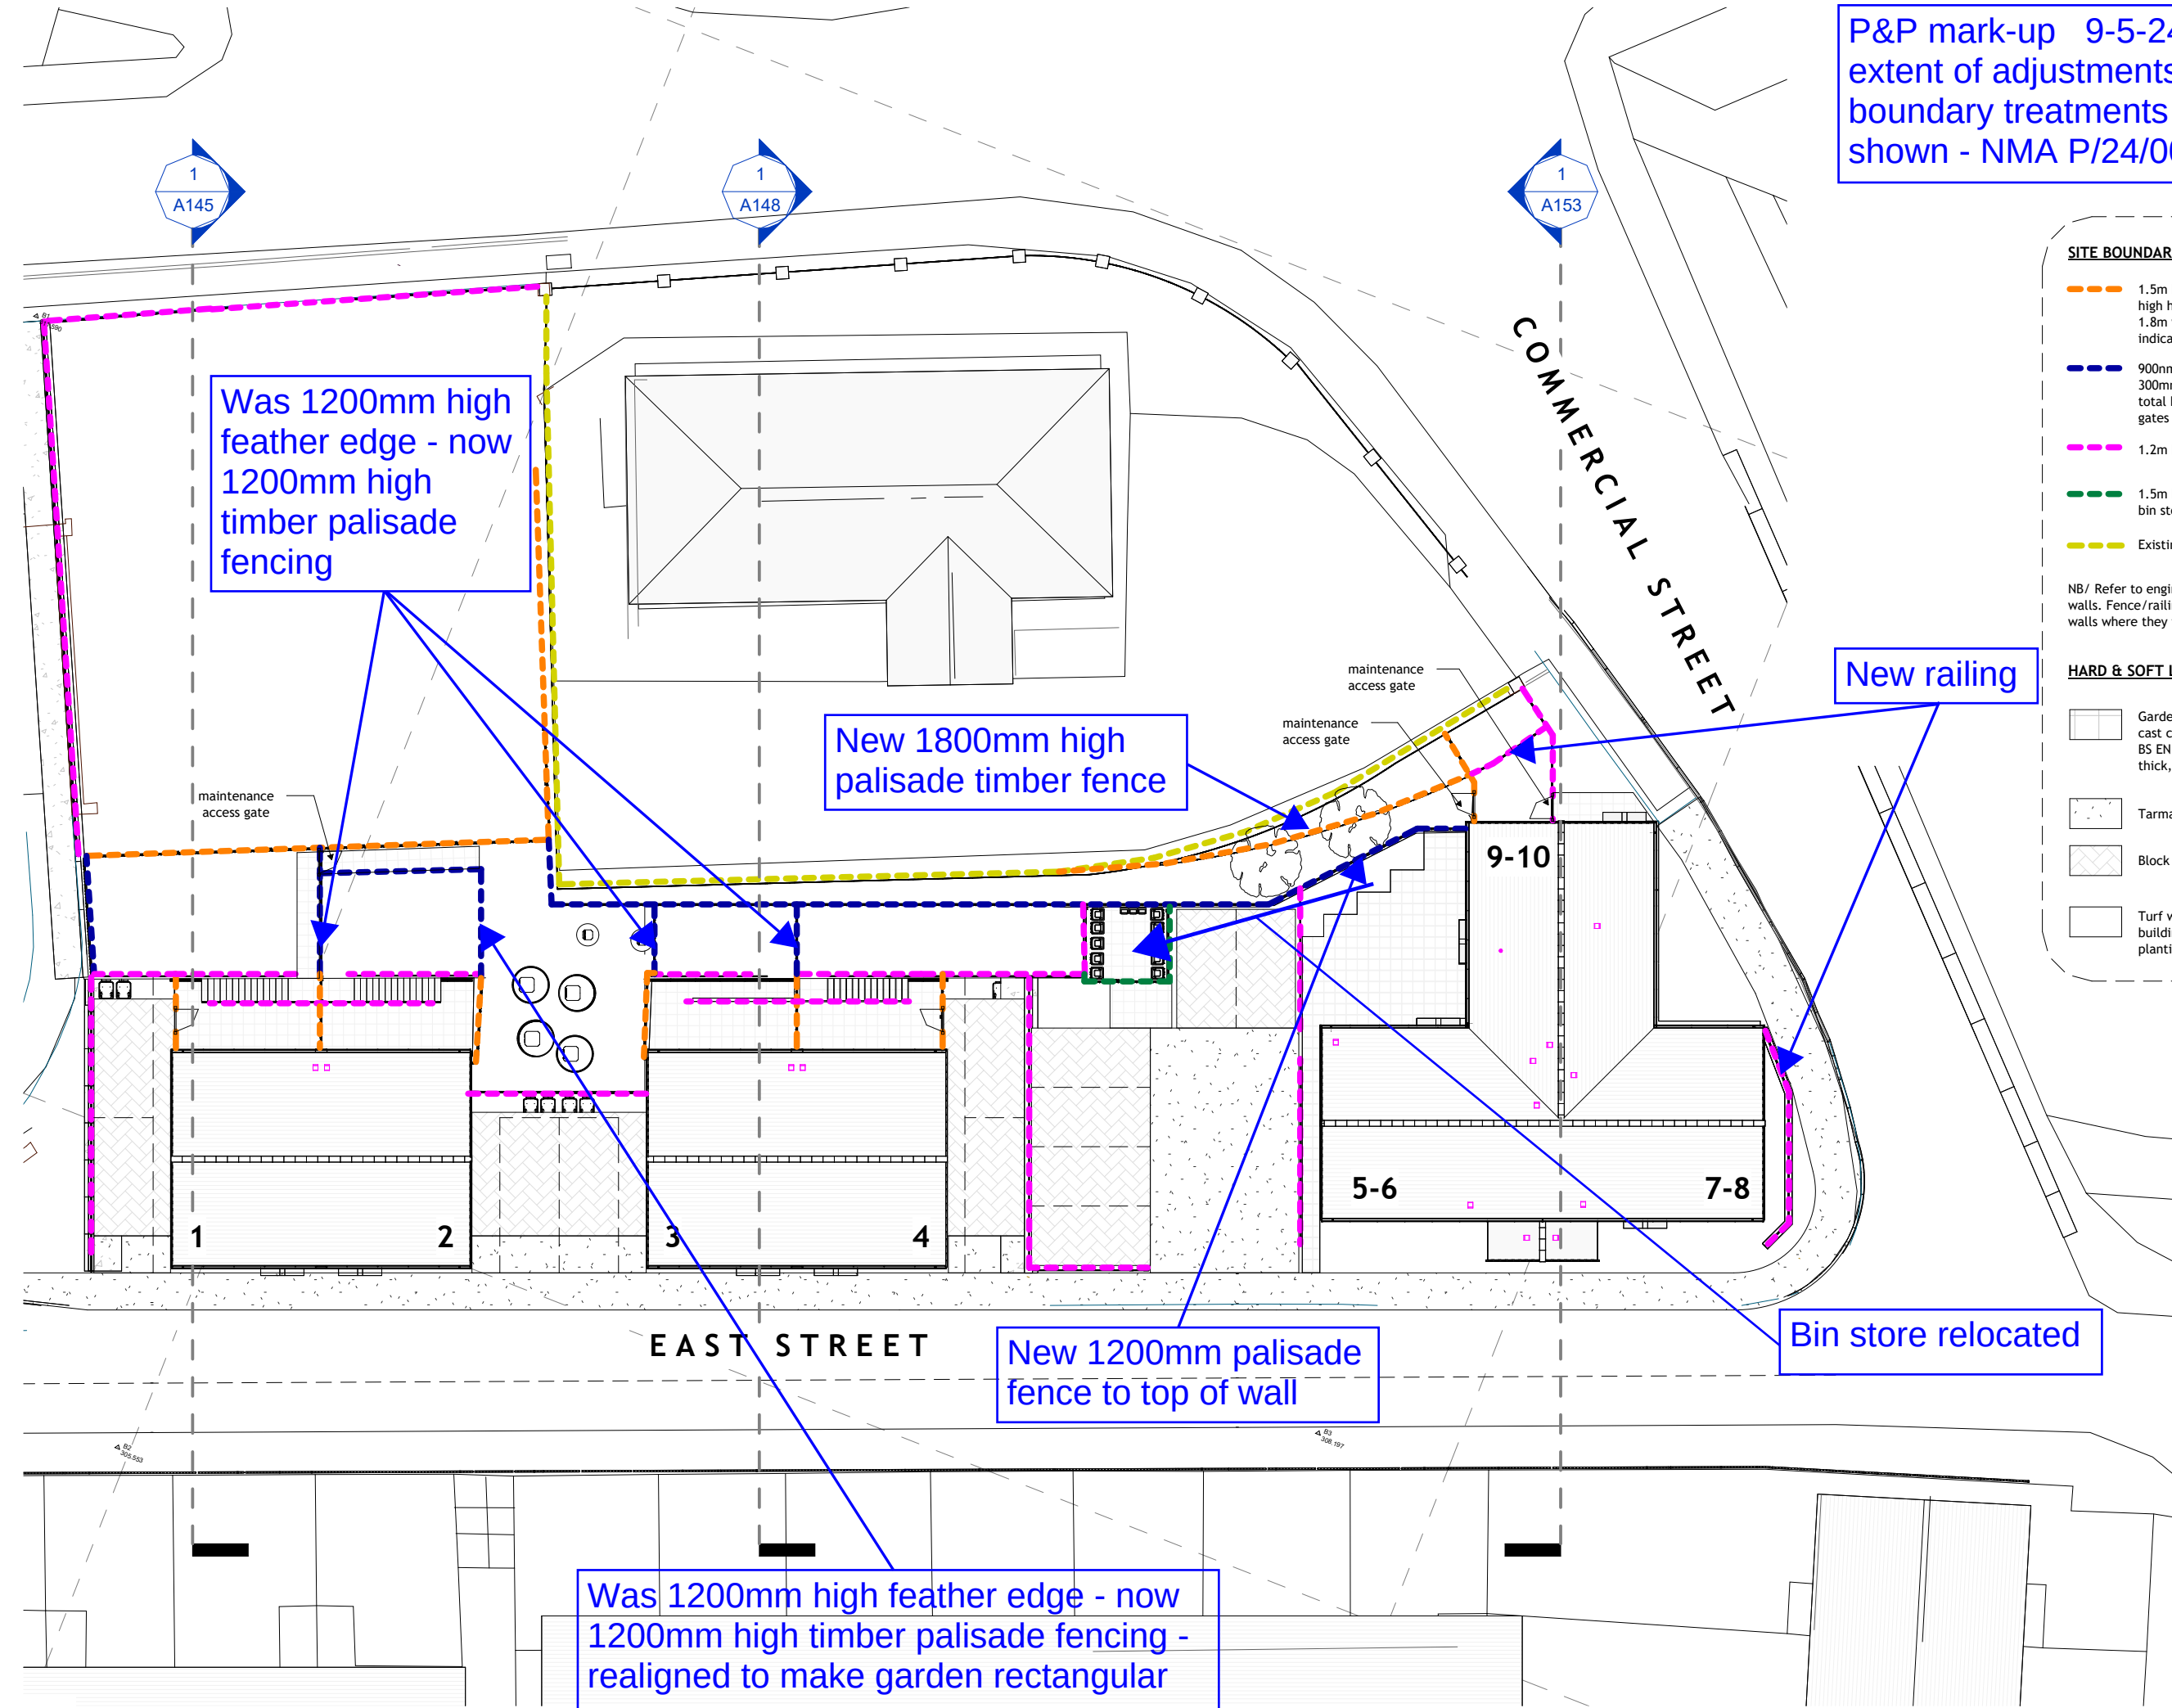

P&P mark-up 9-5-24
extent of adjustments to
boundary treatments
shown - NMA P/24/0064

Revisions	
A	Maintenance access gates added
B	Hit & Miss timber fence added
C	Title plan overlaid
D	Minor amendments
E	Bin Store relocated
F	Minor amendments
G	Minor amendments
H	Minor amendments to fence notes
I	Minor amendments
PC	07.04.20
PC	07.04.20
PC	21.01.21
PC	11.04.23
PC	04.03.24
PC	06.03.24
PC	24.04.24
PC	25.04.24
PC	01.05.24

SITE BOUNDARIES

- 1.5m high timber palisade fence with 300mm high horizontal timber kickboard - total height 1.8m with ledged and braced gates as indicated on drawings
- 900mm high timber palisade fence with 300mm high horizontal timber kickboard - total height 1.2m with ledged and braced gates as indicated on drawings
- 1.2m high painted ball top metal railings.
- 1.5m high feather lapped timber fence enclosure bin store with braced and legde gates
- Existing boundary fence/railings

NB/ Refer to engineers layout for locations of retaining walls. Fence/railings to sit on top of low level retaining walls where they form part of the boundary

HARD & SOFT LANDSCAPING KEY

- Garden Areas & paths around flats/houses - Pre-cast concrete slabs with defined texture finish to BS EN 1339:2003 - Colour Grey - 450 x450 x 40mm thick, Patio Area to garden - Min 9m²
- Tarmac
- Block Paving to Parking Spaces
- Turf with nominal mowing strip adjacent to buildings NB/ Imported topsoil to be good quality planting topsoil, allow for 200mm depth lawns.

Notes

Do not scale from this drawing. Use figured dimensions only, which are displayed in millimeters unless stated otherwise. The contractor is requested to check all dimensions before work is put in hand. Any discrepancies within the drawing should be reported prior to commencement of works.

Copyright of this drawing belongs solely to CMKA Ltd. This drawing must only be used for the purpose for which it is supplied and its contents must not be reproduced for any purpose without written permission.

CHAMBERLAIN
MOSS
KING
architecture

97a Glebe Street | Penarth
Vale of Glamorgan | CF64 1EE

T. 02920 306400
chamberlainkingmoss.co.uk

Project	LAND OFF EAST STREET, MERTHYR TYDFIL N223
Project number	
Client	MTHA
Title	SITE BOUNDARY LAYOUT
Drawing number	A130
Scale	1 : 250 at A3
Revision	I
Status	CONSTRUCTION
Drawn	PC
Date	01.05.24