

Revisions	
A	Materials updated
B	Bin Store relocated
C	Minor amendments
D	Minor amendments
PC	14.06.20
PC	04.03.24
PC	06.03.24
PC	01.05.24




MATERIALS

- CREAM COLOUR RENDER
- PENNANT STONE
- TIMBER CLAD RETAINING WALL
- GREY FIBRE CEMENT SLATE

01 BOUNDARY ELEVATION A
1 : 250

Bin store in new location

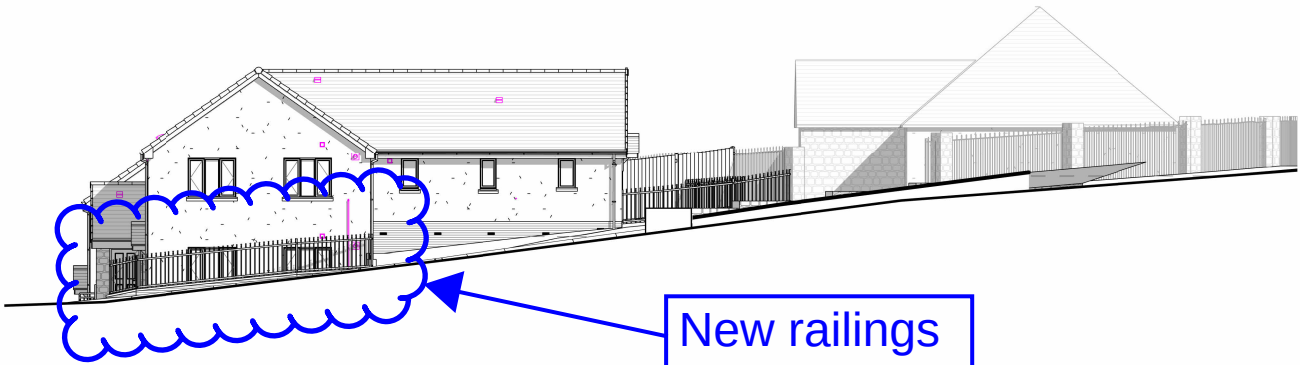


New railings

P&P mark-up 9-5-24 extent of adjustments to boundary treatments and bin store location shown shown - NMA P/24/0064

02 BOUNDARY ELEVATION B
1 : 250

Fence type amended

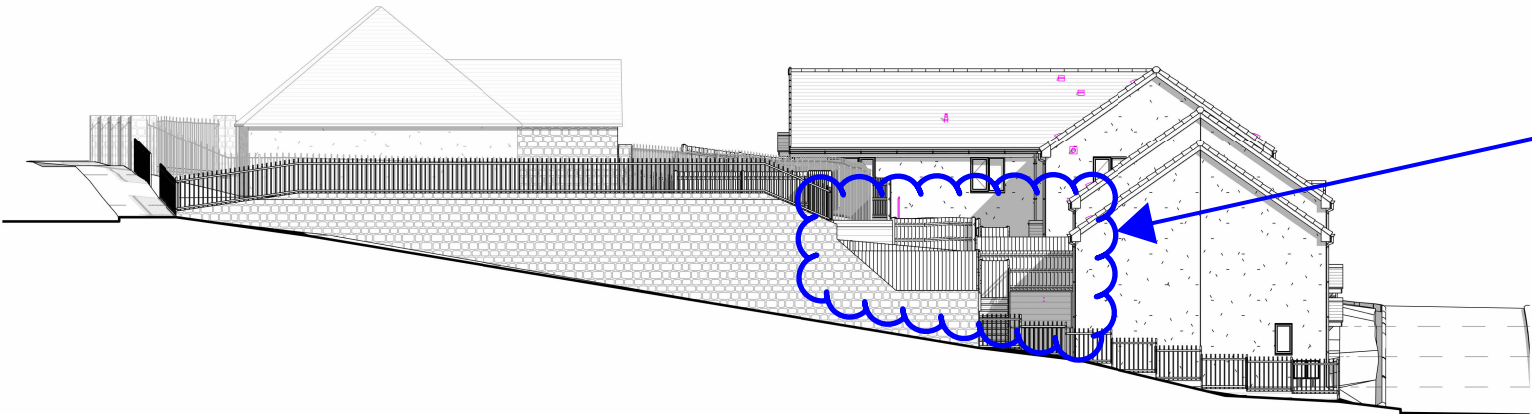

03 BOUNDARY ELEVATION C
1 : 250

Notes

Do not scale from this drawing. Use figured dimensions only, which are displayed in millimeters unless stated otherwise. The contractor is requested to check all dimensions before work is put in hand. Any discrepancies within the drawing should be reported prior to commencement of works.

Copyright of this drawing belongs solely to CMKA Ltd. This drawing must only be used for the purpose for which it is supplied and its contents must not be reproduced for any purpose without written permission.

CHAMBERLAIN
MOSS
KING
architecture

97a Glebe Street | Penarth
Vale of Glamorgan | CF64 1EE

T. 02920 306400
chamberlainkingmoss.co.uk

Project	LAND OFF EAST STREET, MERTHYR TYDFIL N223
Project number	
Client	MTHA
Title	BOUNDARY ELEVATIONS
Drawing number	A132
Scale	1 : 250 at A3
Revision	D
Status	CONSTRUCTION
Drawn	PC
Date	01.05.24