


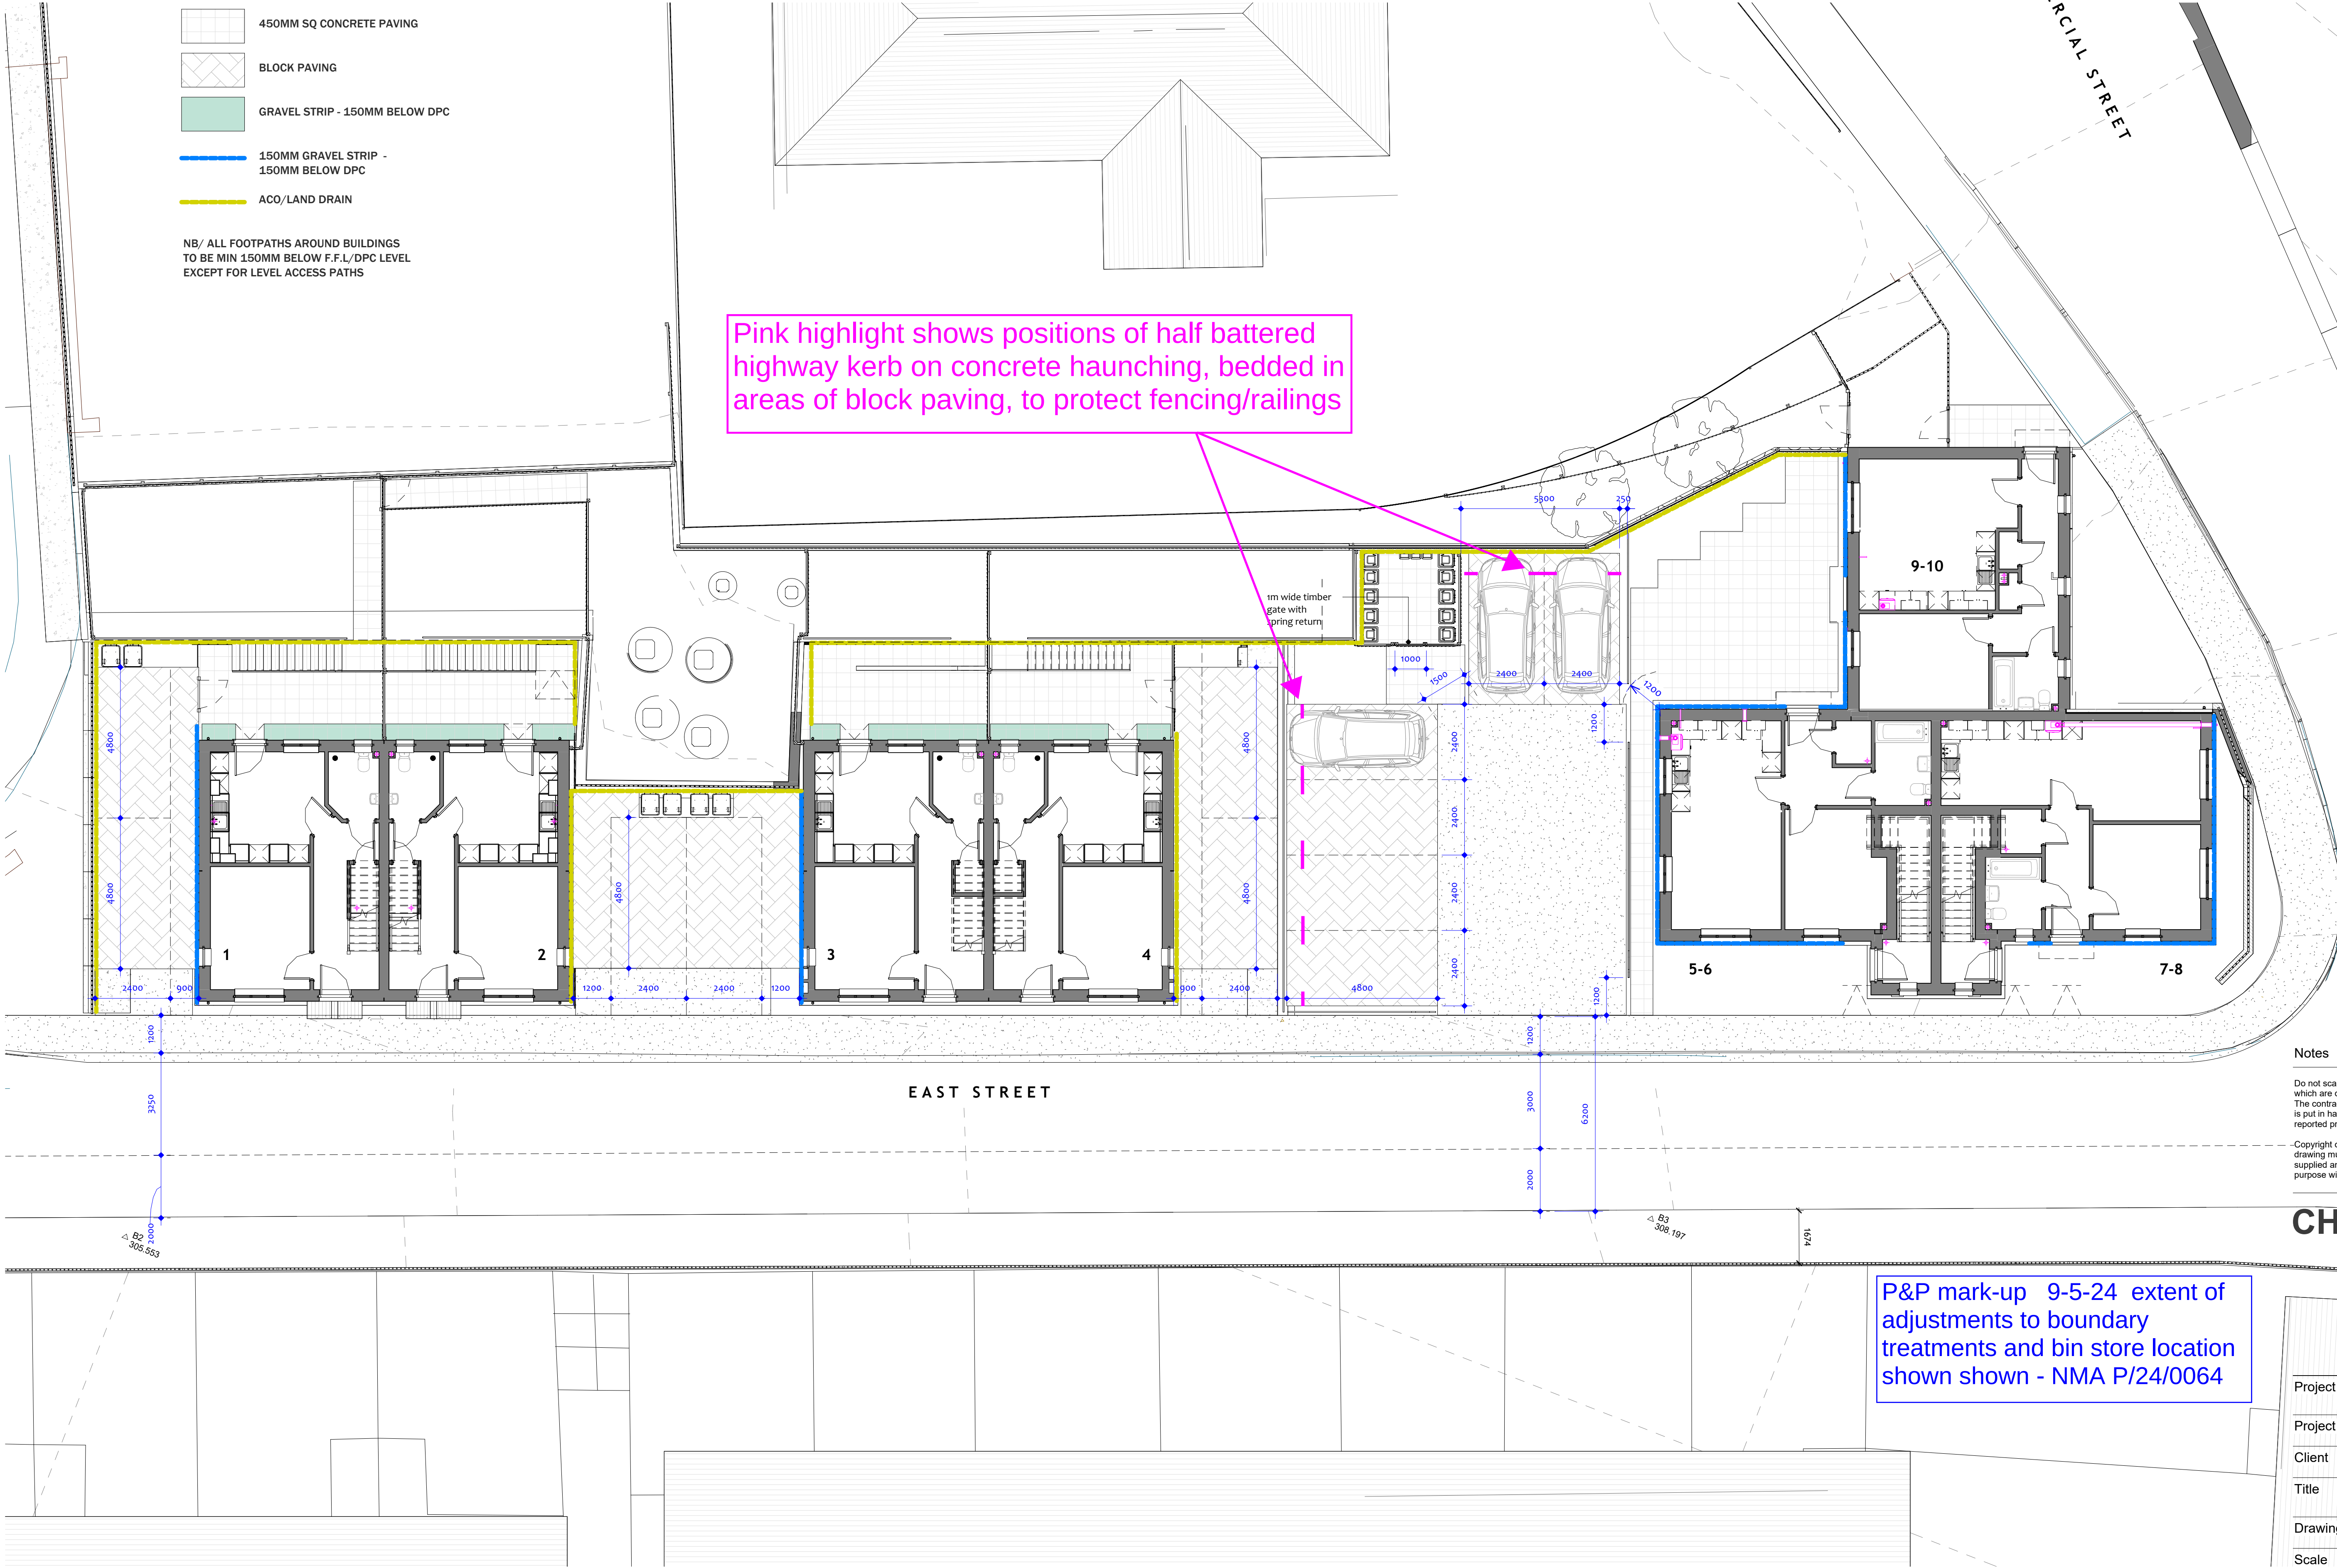

- 450MM SQ CONCRETE PAVING
- BLOCK PAVING
- GRAVEL STRIP - 150MM BELOW DPC
- 150MM GRAVEL STRIP - 150MM BELOW DPC
- ACO/LAND DRAIN

NB/ ALL FOOTPATHS AROUND BUILDINGS
TO BE MIN 150MM BELOW F.F.L/DPC LEVEL
EXCEPT FOR LEVEL ACCESS PATHS

Pink highlight shows positions of half battered
highway kerb on concrete haunching, bedded in
areas of block paving, to protect fencing/railings

1m wide timber
gate with
spring return

P&P mark-up 9-5-24 extent of
adjustments to boundary
treatments and bin store location
shown shown - NMA P/24/0064

Revisions		
A	02.08.22	Drainage channel positions amended
B	12.08.22	Minor amendments
C	25.01.25	Amendments following client discussions
D	04.03.24	Bin Store relocated
E	06.03.24	Minor amendments
F	21.03.24	Minor amendments
G	01.05.24	Minor amendments

Notes

Do not scale from this drawing. Use figured dimensions only, which are displayed in millimeters unless stated otherwise. The contractor is requested to check all dimensions before work is put in hand. Any discrepancies within the drawing should be reported prior to commencement of works.

Copyright of this drawing belongs solely to CMKA Ltd. This drawing must only be used for the purpose for which it is supplied and its contents must not be reproduced for any purpose without written permission.

**CHAMBERLAIN
MOSS
KING**
architecture

97a Glebe Street | Penarth
Vale of Glamorgan | CF64 1EE
T. 02920 306400
www.chamberlainmossking.co.uk

Project	LAND OFF EAST STREET, MERTHYR TYDFIL
Project number	N223
Client	MTHA
Title	EXTERNAL WORKS LAYOUT
Drawing number	A182
Scale	1 : 100 at A1
Revision	G
Status	CONSTRUCTION
Drawn	PC
Date	01.04.24