
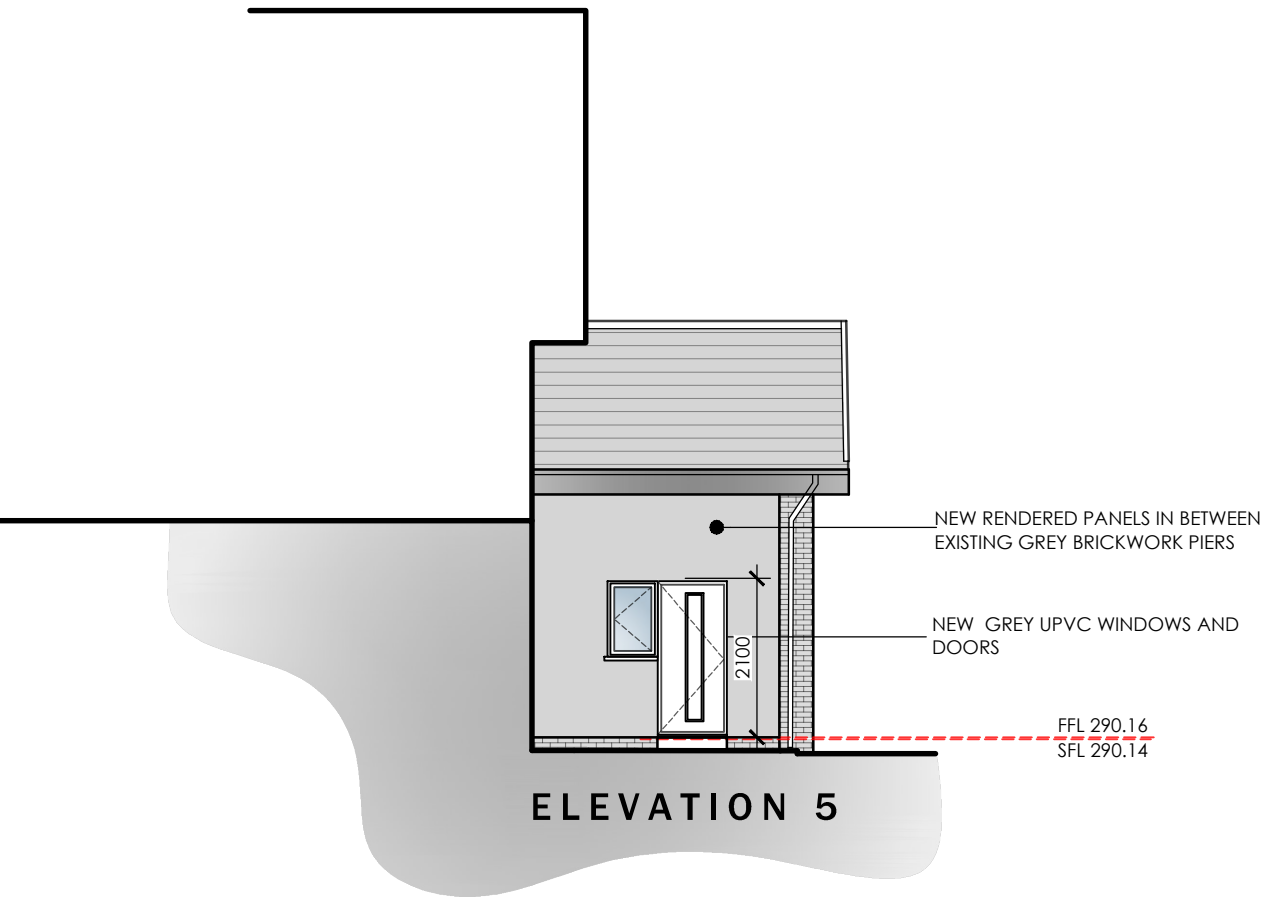
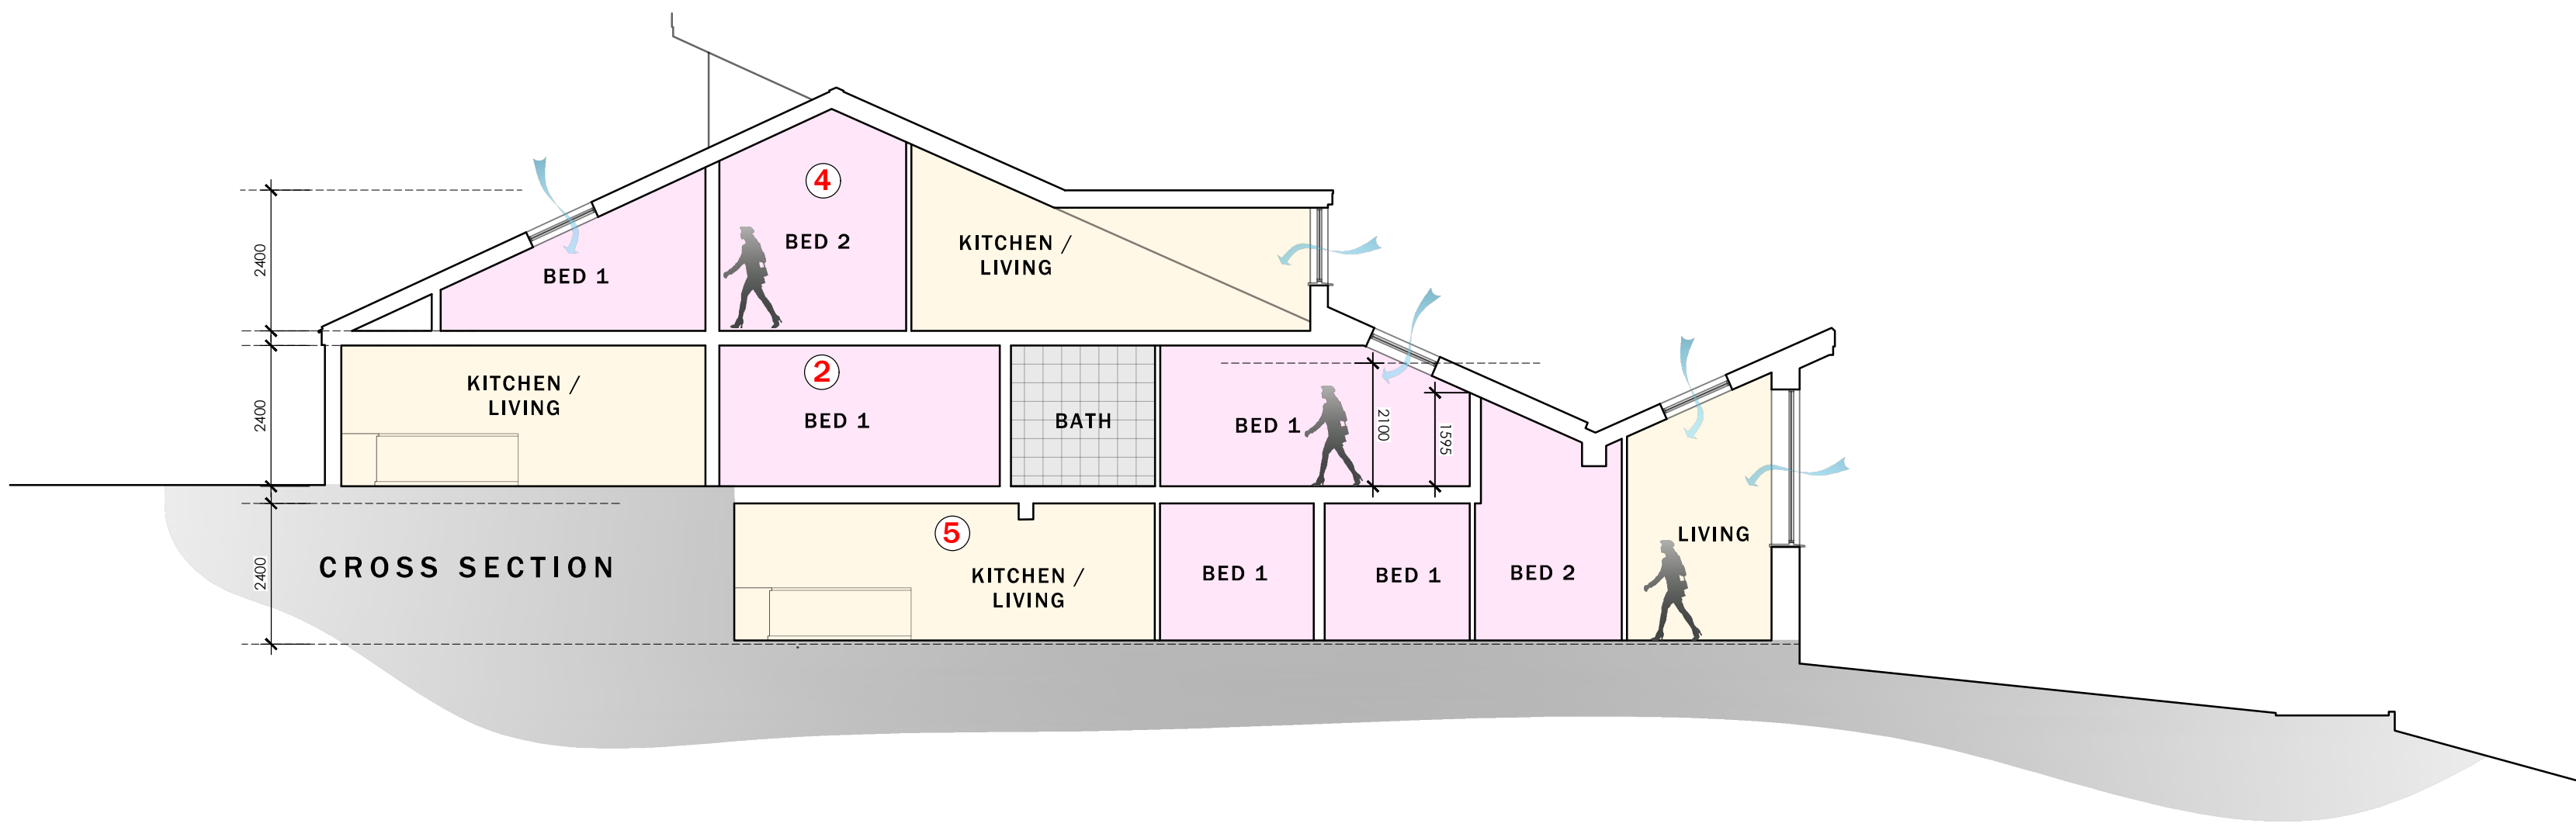
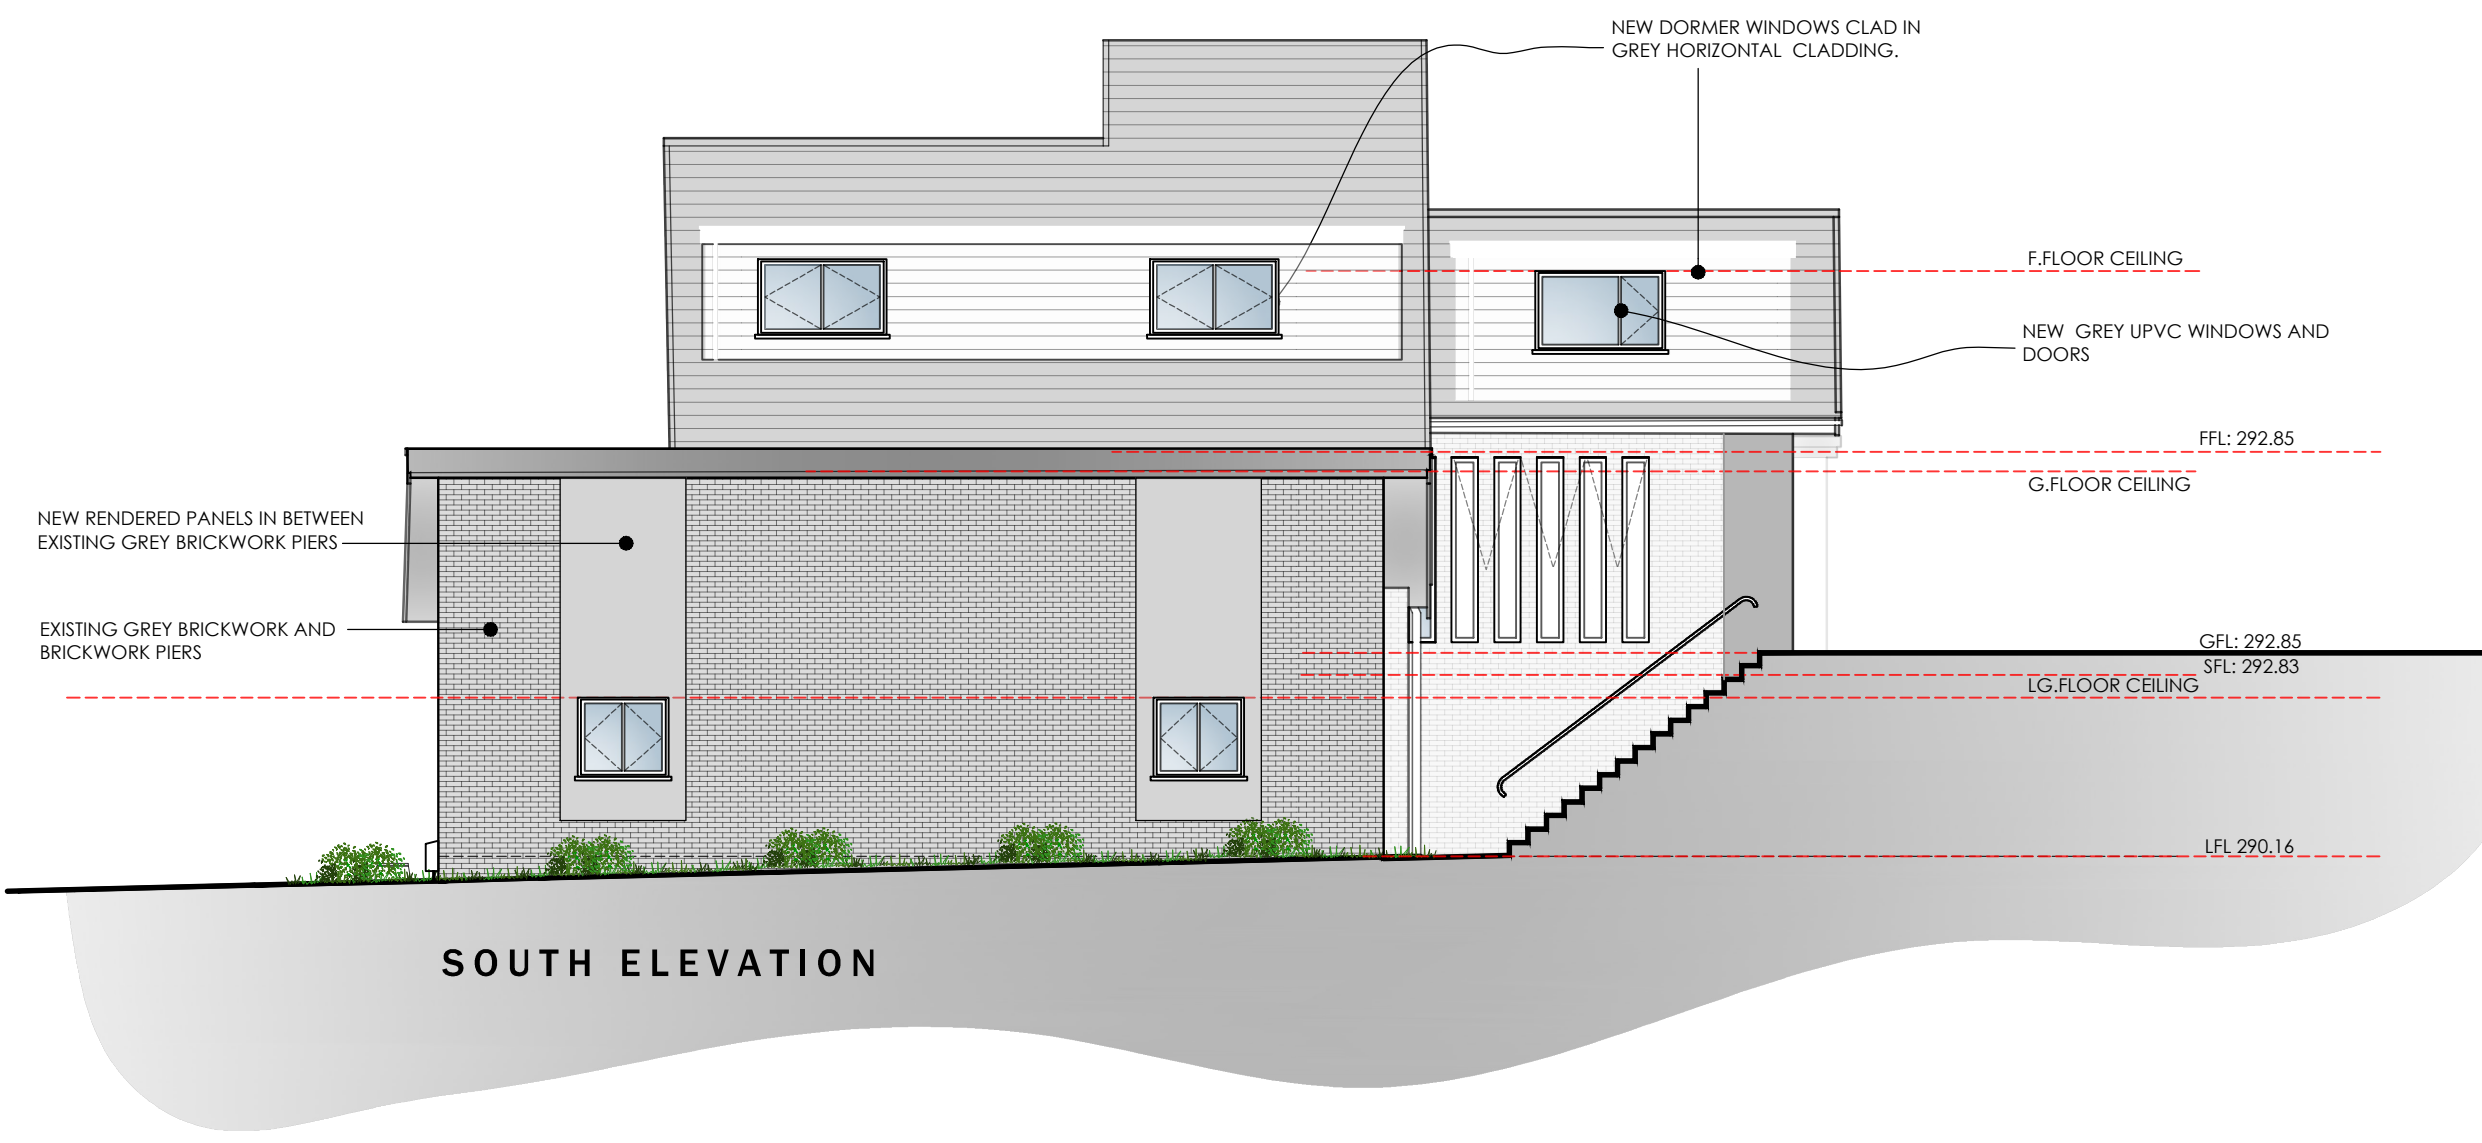
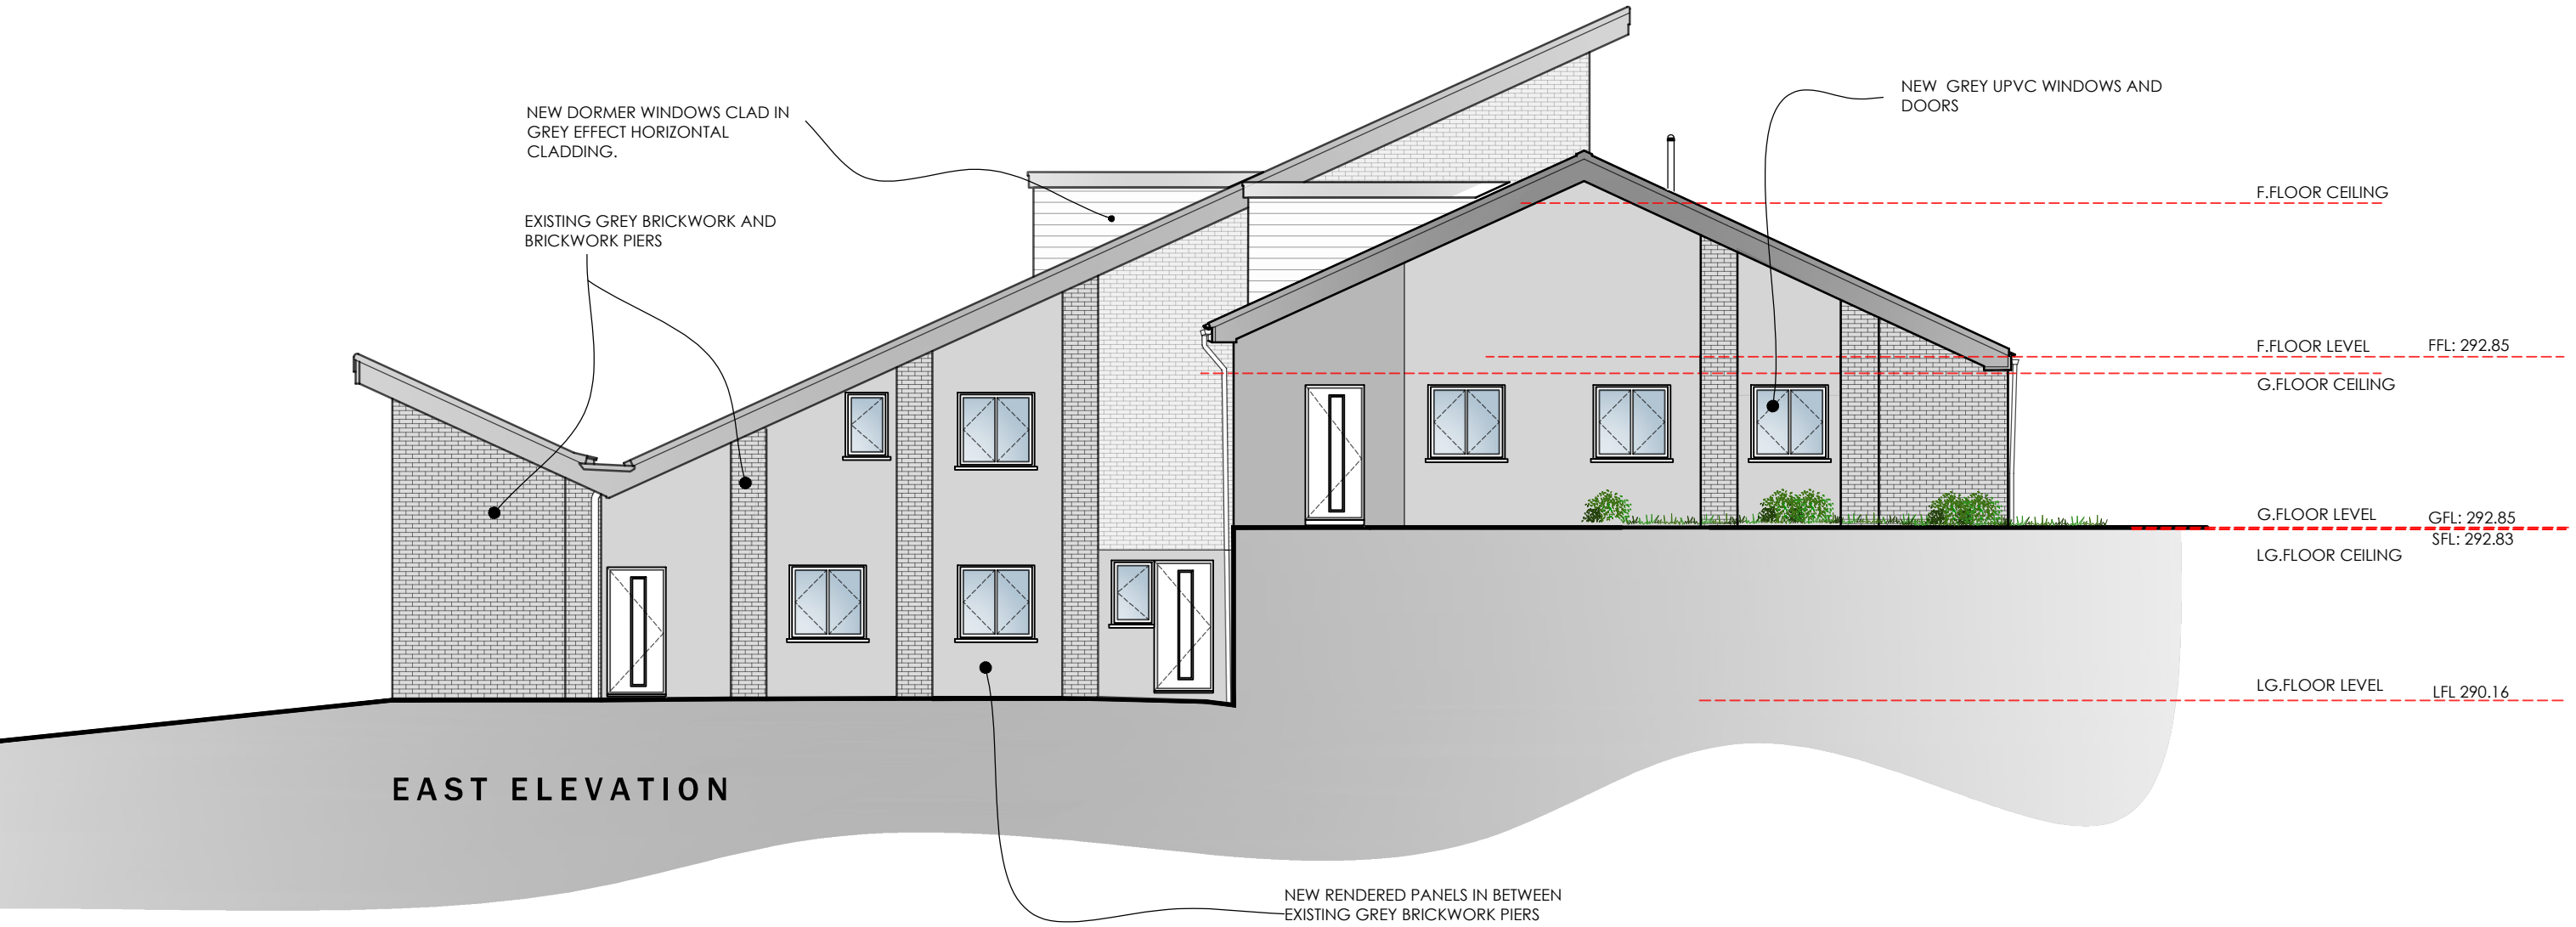
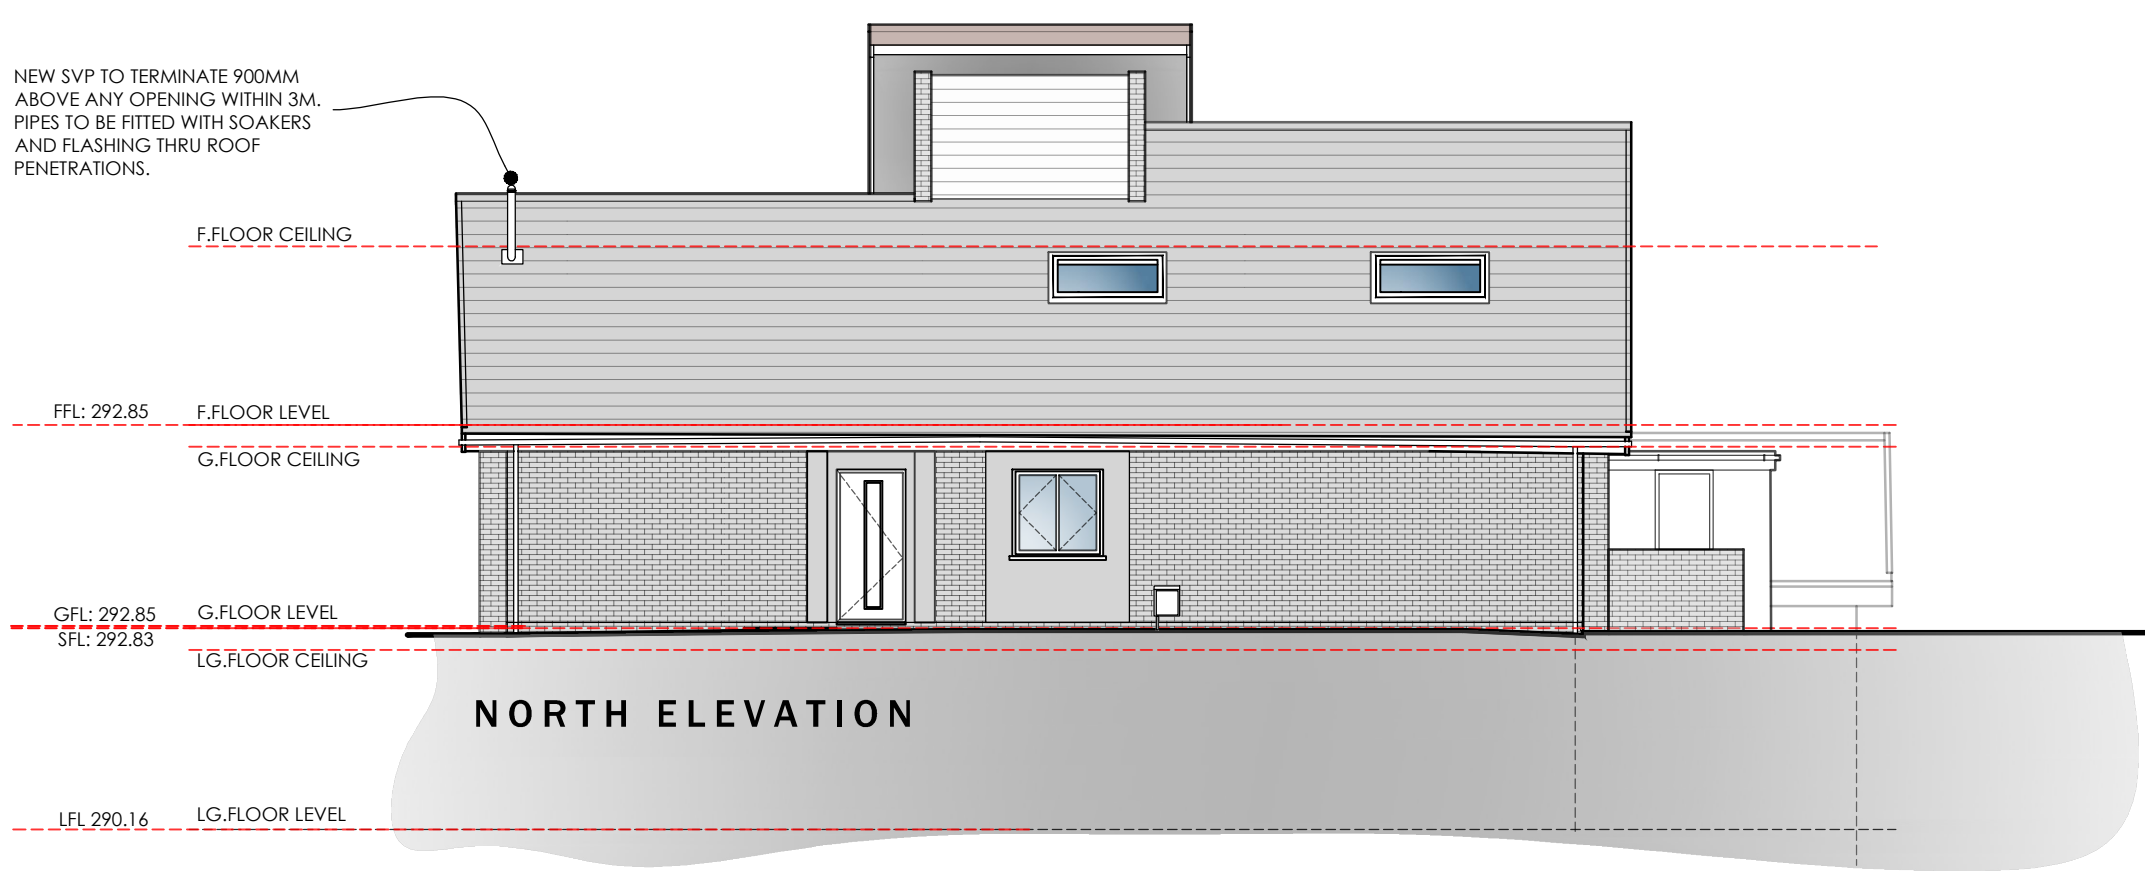


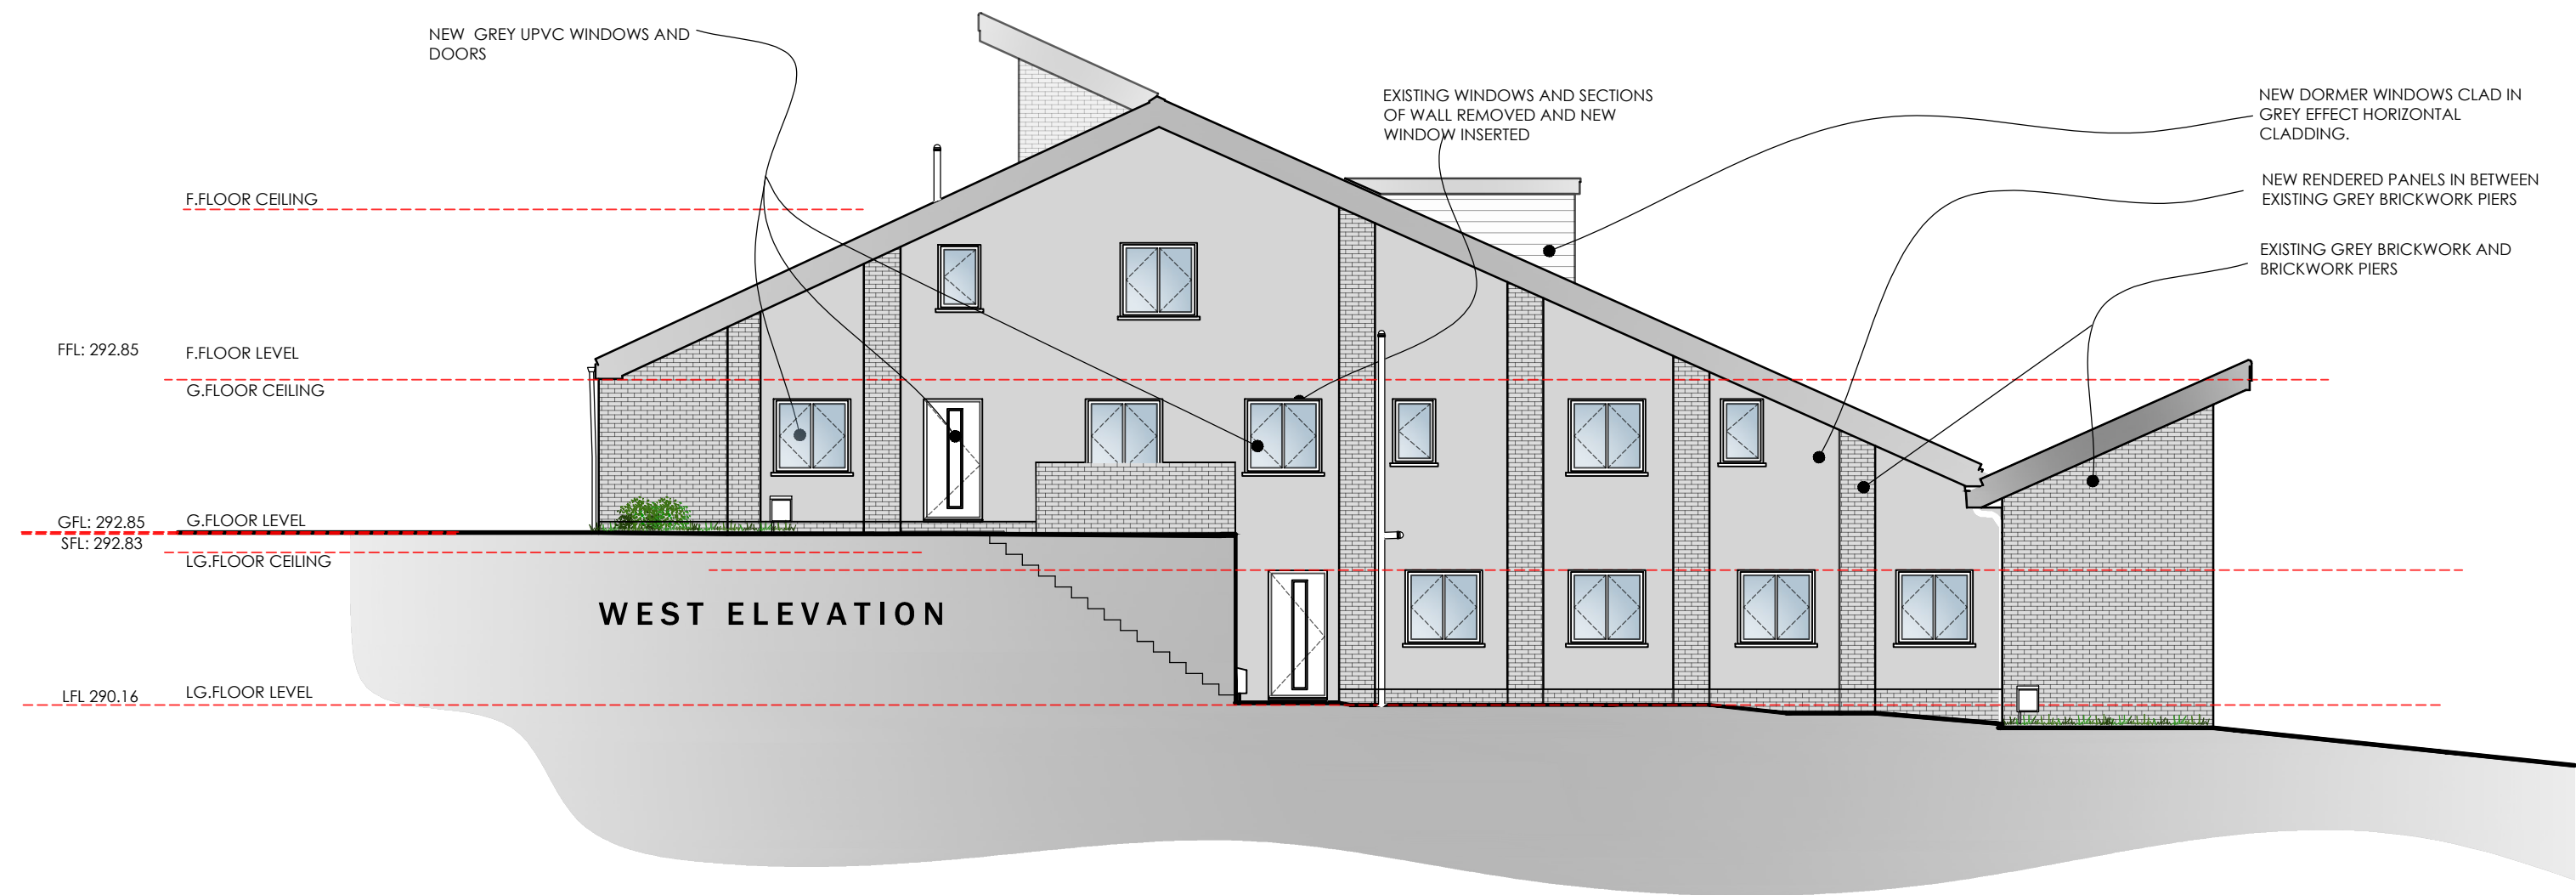

PROPOSED ELEVATIONS

0 1000 2000 3000 4000 5000 mm
SCALE 1:100

Do not scale from this drawing.
The users of this drawing shall check all dimensions & report all errors and omissions to Letrucode Design.
This drawing is copyright. It must not be copied, used or disclosed to third parties without prior permission of Letrucode Design.

REV G OCT 22 FURTHER CHANGES TO BRD AND BAT BOX LOCATIONS
REV H JUNE 24 DRAWING UPDATED TO SUIT AS BUILT SITUATION
REV J JULY 24 PLANS FURTHER REVISED TO SUIT AS BUILT

REV D JUNE 22 ADDITIONAL BRD BOXES ADDED AS PER BAT REPORT
REV E JULY 22 BRD BOXES RELOCATED WALL LIGHTS ADDED
REV F SEPT 22 WALL LIGHTS REMOVED.

Revisions
REV A NOV 21 REVISIONS TO SUIT CLIENT COMMENTS
REV B APR 22 REVISIONS TO SUIT PRE-PLANNING APPLICATION COMMENTS
REV C APR 22 ELEVATION TITLE UPDATED TO INCLUDE COMPASS ANNOTATION

Client	Drawing No	Scale	Revision
Mr A Thomas	LT2116.04.02	1:100 @A1	I
Job Title	Drawing Title	Date	Checked
Wesley Chapel, Dowlais	Proposed Elevations	Oct 21	KWL

LeTrucode
ARCHITECTURE

Suite 7, 35 Stow Park Circle
Newport, NP20 4HF

Tel: 07710390800 / 07710390801
info@letrucode.co.uk
www.letrucode.co.uk