


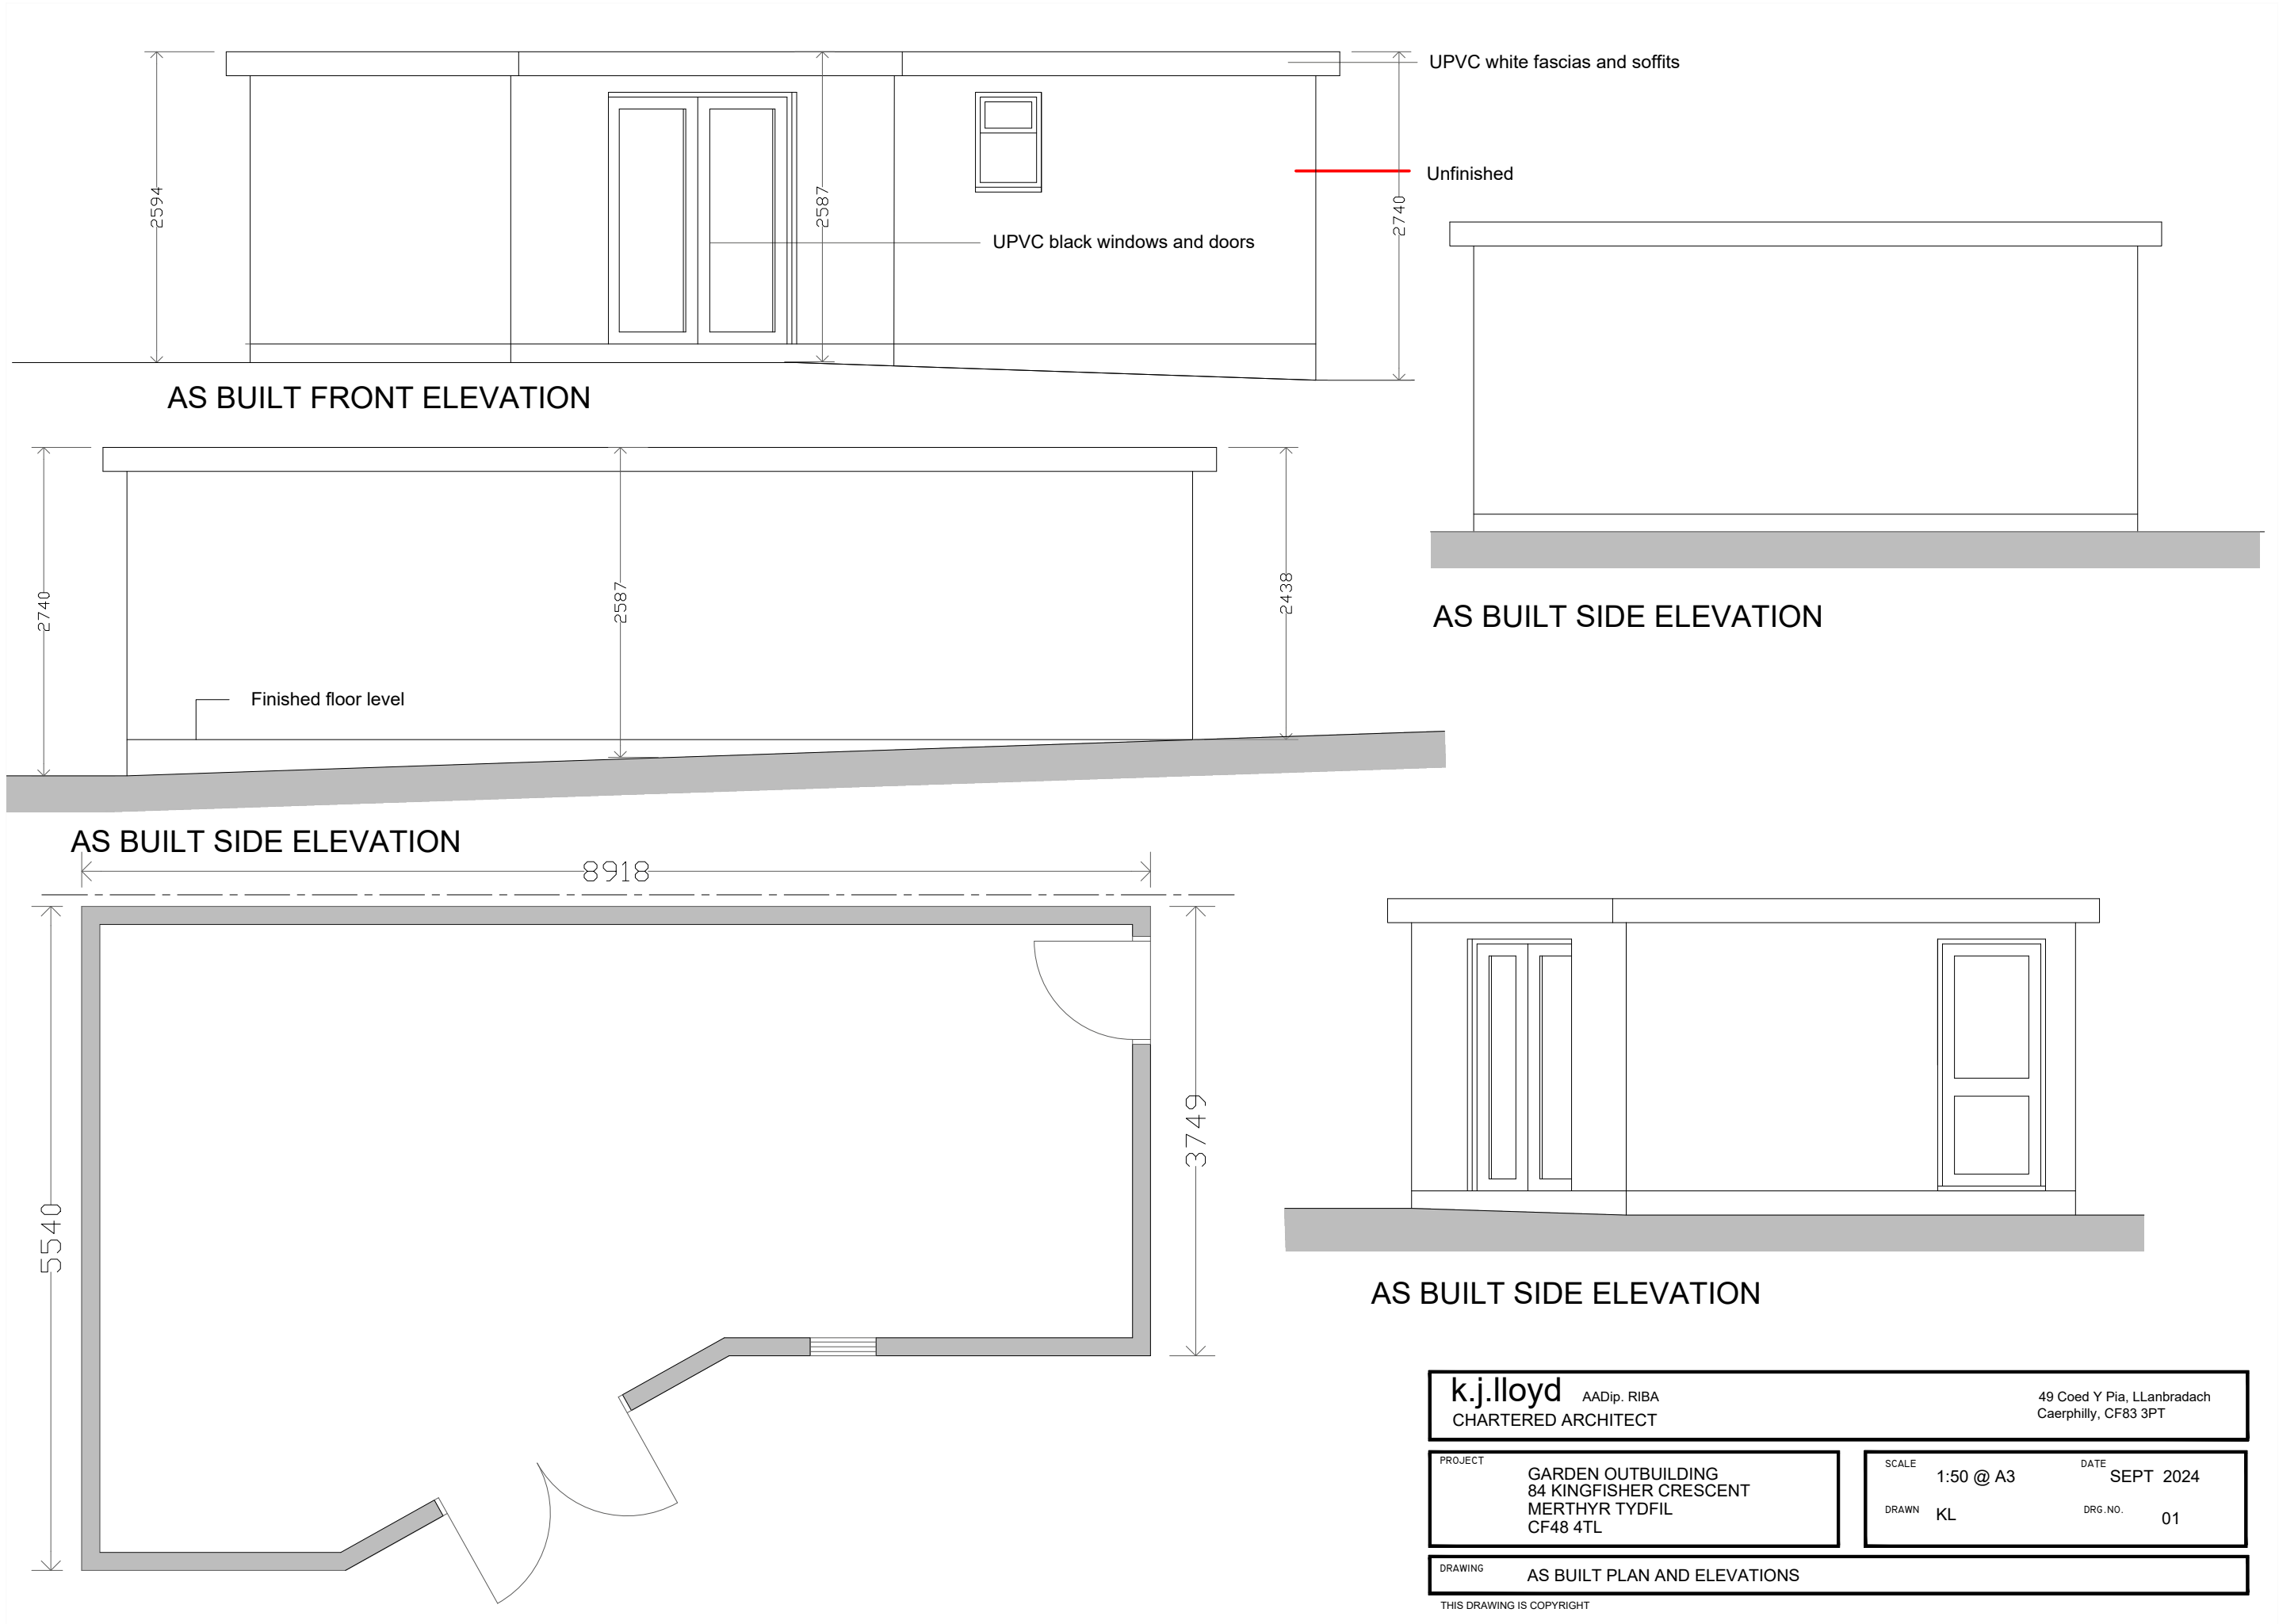

k.j.lloyd AADip. RIBA CHARTERED ARCHITECT		49 Coed Y Pia, LLanbradach Caerphilly, CF83 3PT	
PROJECT	GARDEN OUTBUILDING 84 KINGFISHER CRESCENT MERTHYR TYDFIL CF48 4TL	SCALE	1:50 @ A3
		DATE	SEPT 2024
DRAWING	AS BUILT PLAN AND ELEVATIONS	DRAWN	KL
		DRG. NO.	01

THIS DRAWING IS COPYRIGHT