




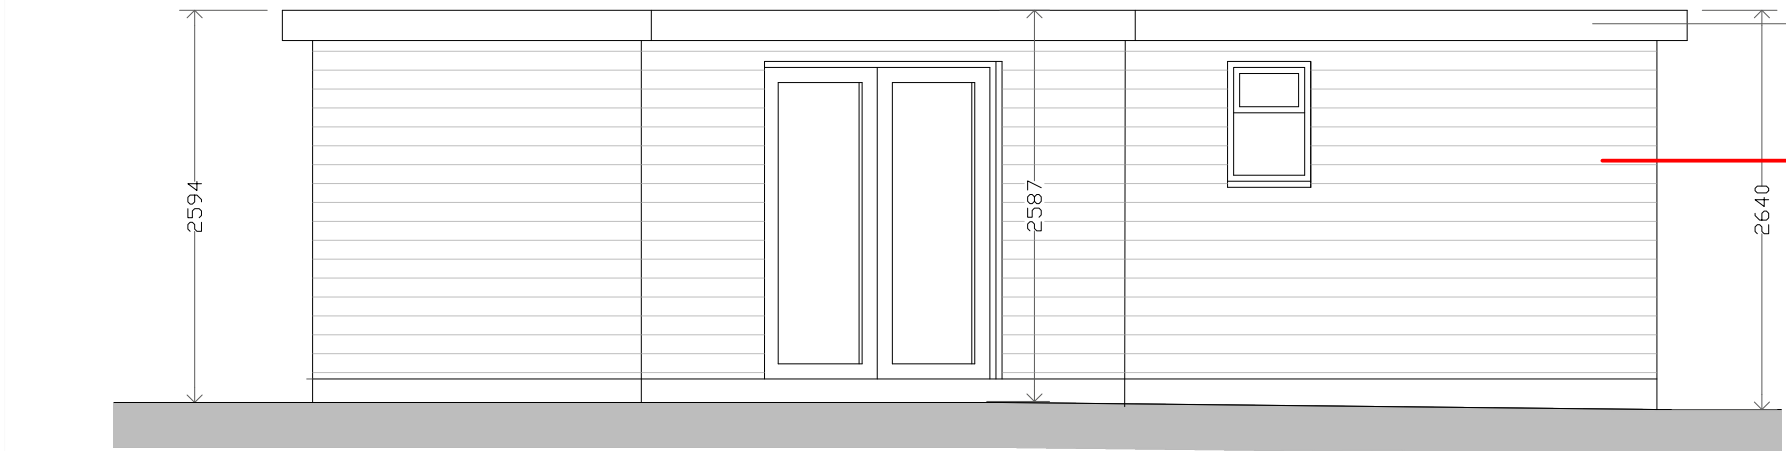


PROPOSED FRONT ELEVATION

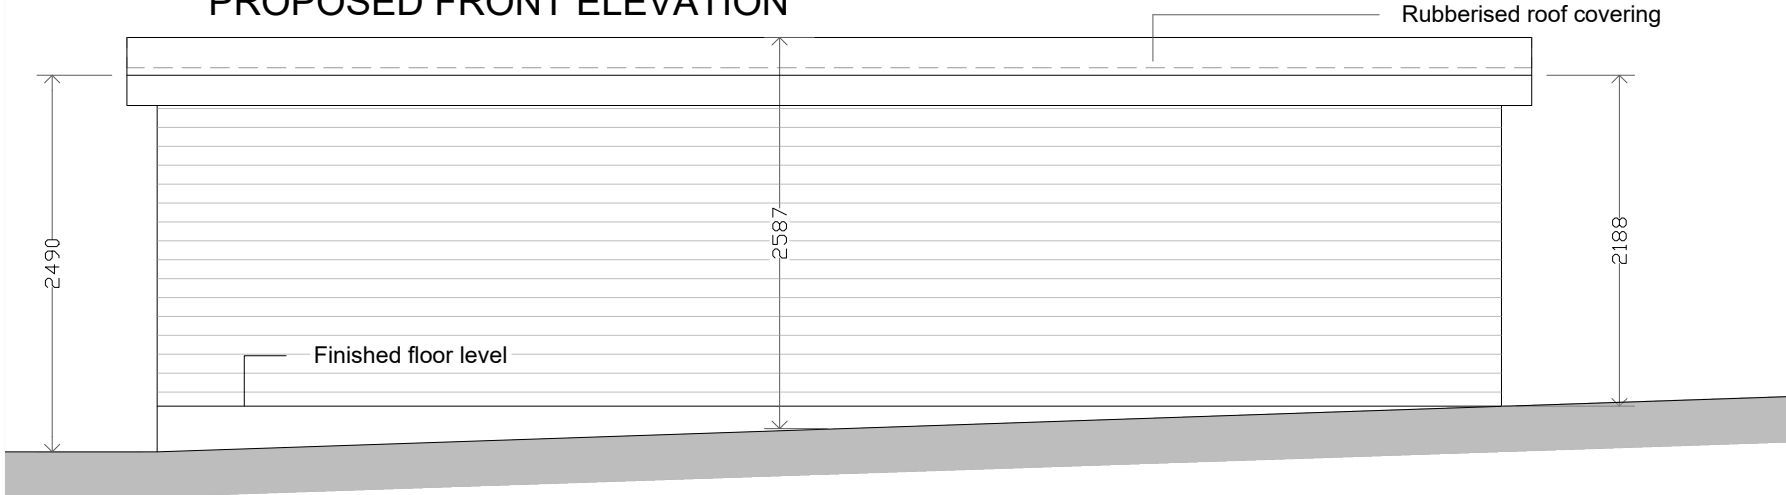

PROPOSED SIDE ELEVATION

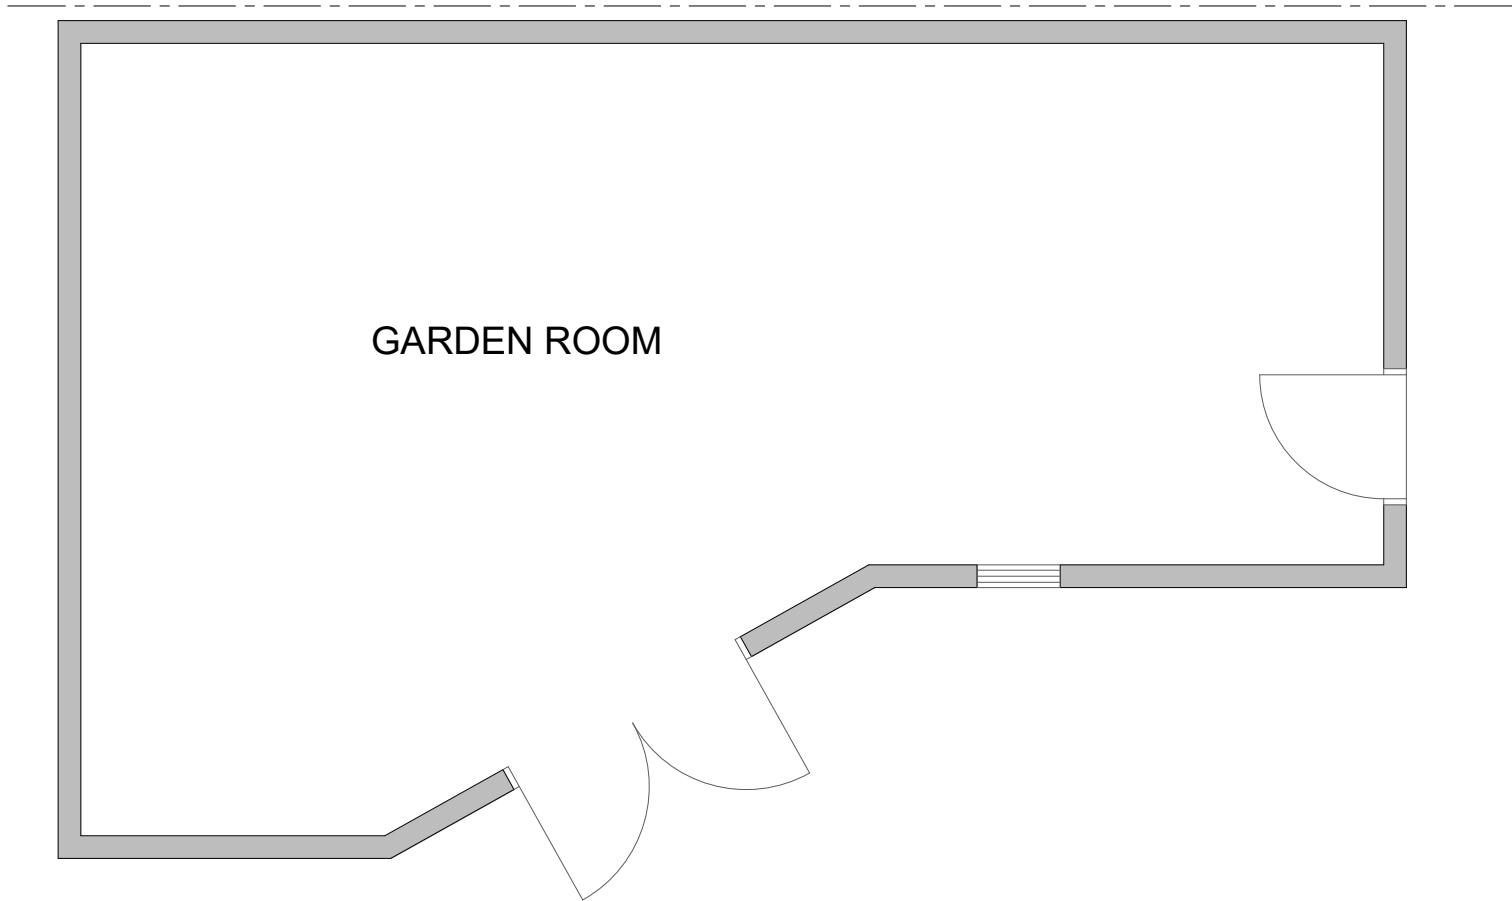


GARDEN ROOM

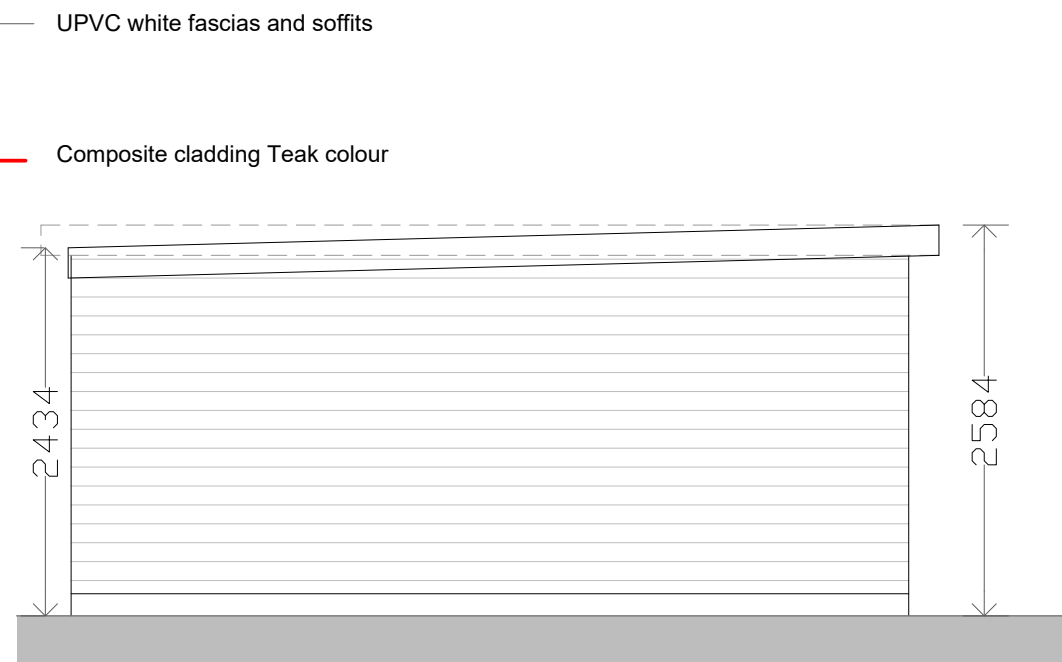

AS BUILT SIDE ELEVATION

PROPOSAL - REDUCE ROOF HEIGHT ALONG BOUNDARY WITH ADJOINING PROPERTY TO MAX. 2.50 METRES. CUT BACK ROOF OVERHANG TO BE WHOLLY WITHIN BOUNDARY OF 84 KINGFISHER

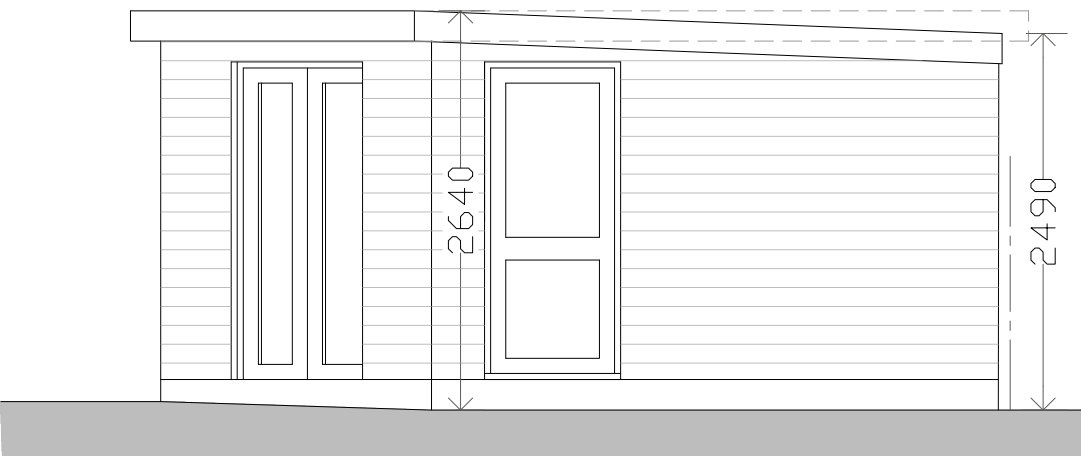

AS BUILT SIDE ELEVATION

k.j.loyd AADip. RIBA CHARTERED ARCHITECT		49 Coed Y Pia, LLanbradach Caerphilly, CF83 3PT	
PROJECT	GARDEN OUTBUILDING 84 KINGFISHER CRESCENT MERTHYR TYDFIL CF48 4TL	SCALE	1:50 @ A3
			DATE SEPT 2024
DRAWING	AS PROPOSED PLAN AND ELEVATIONS	DRAWN	KL
			DRG. NO. 02