
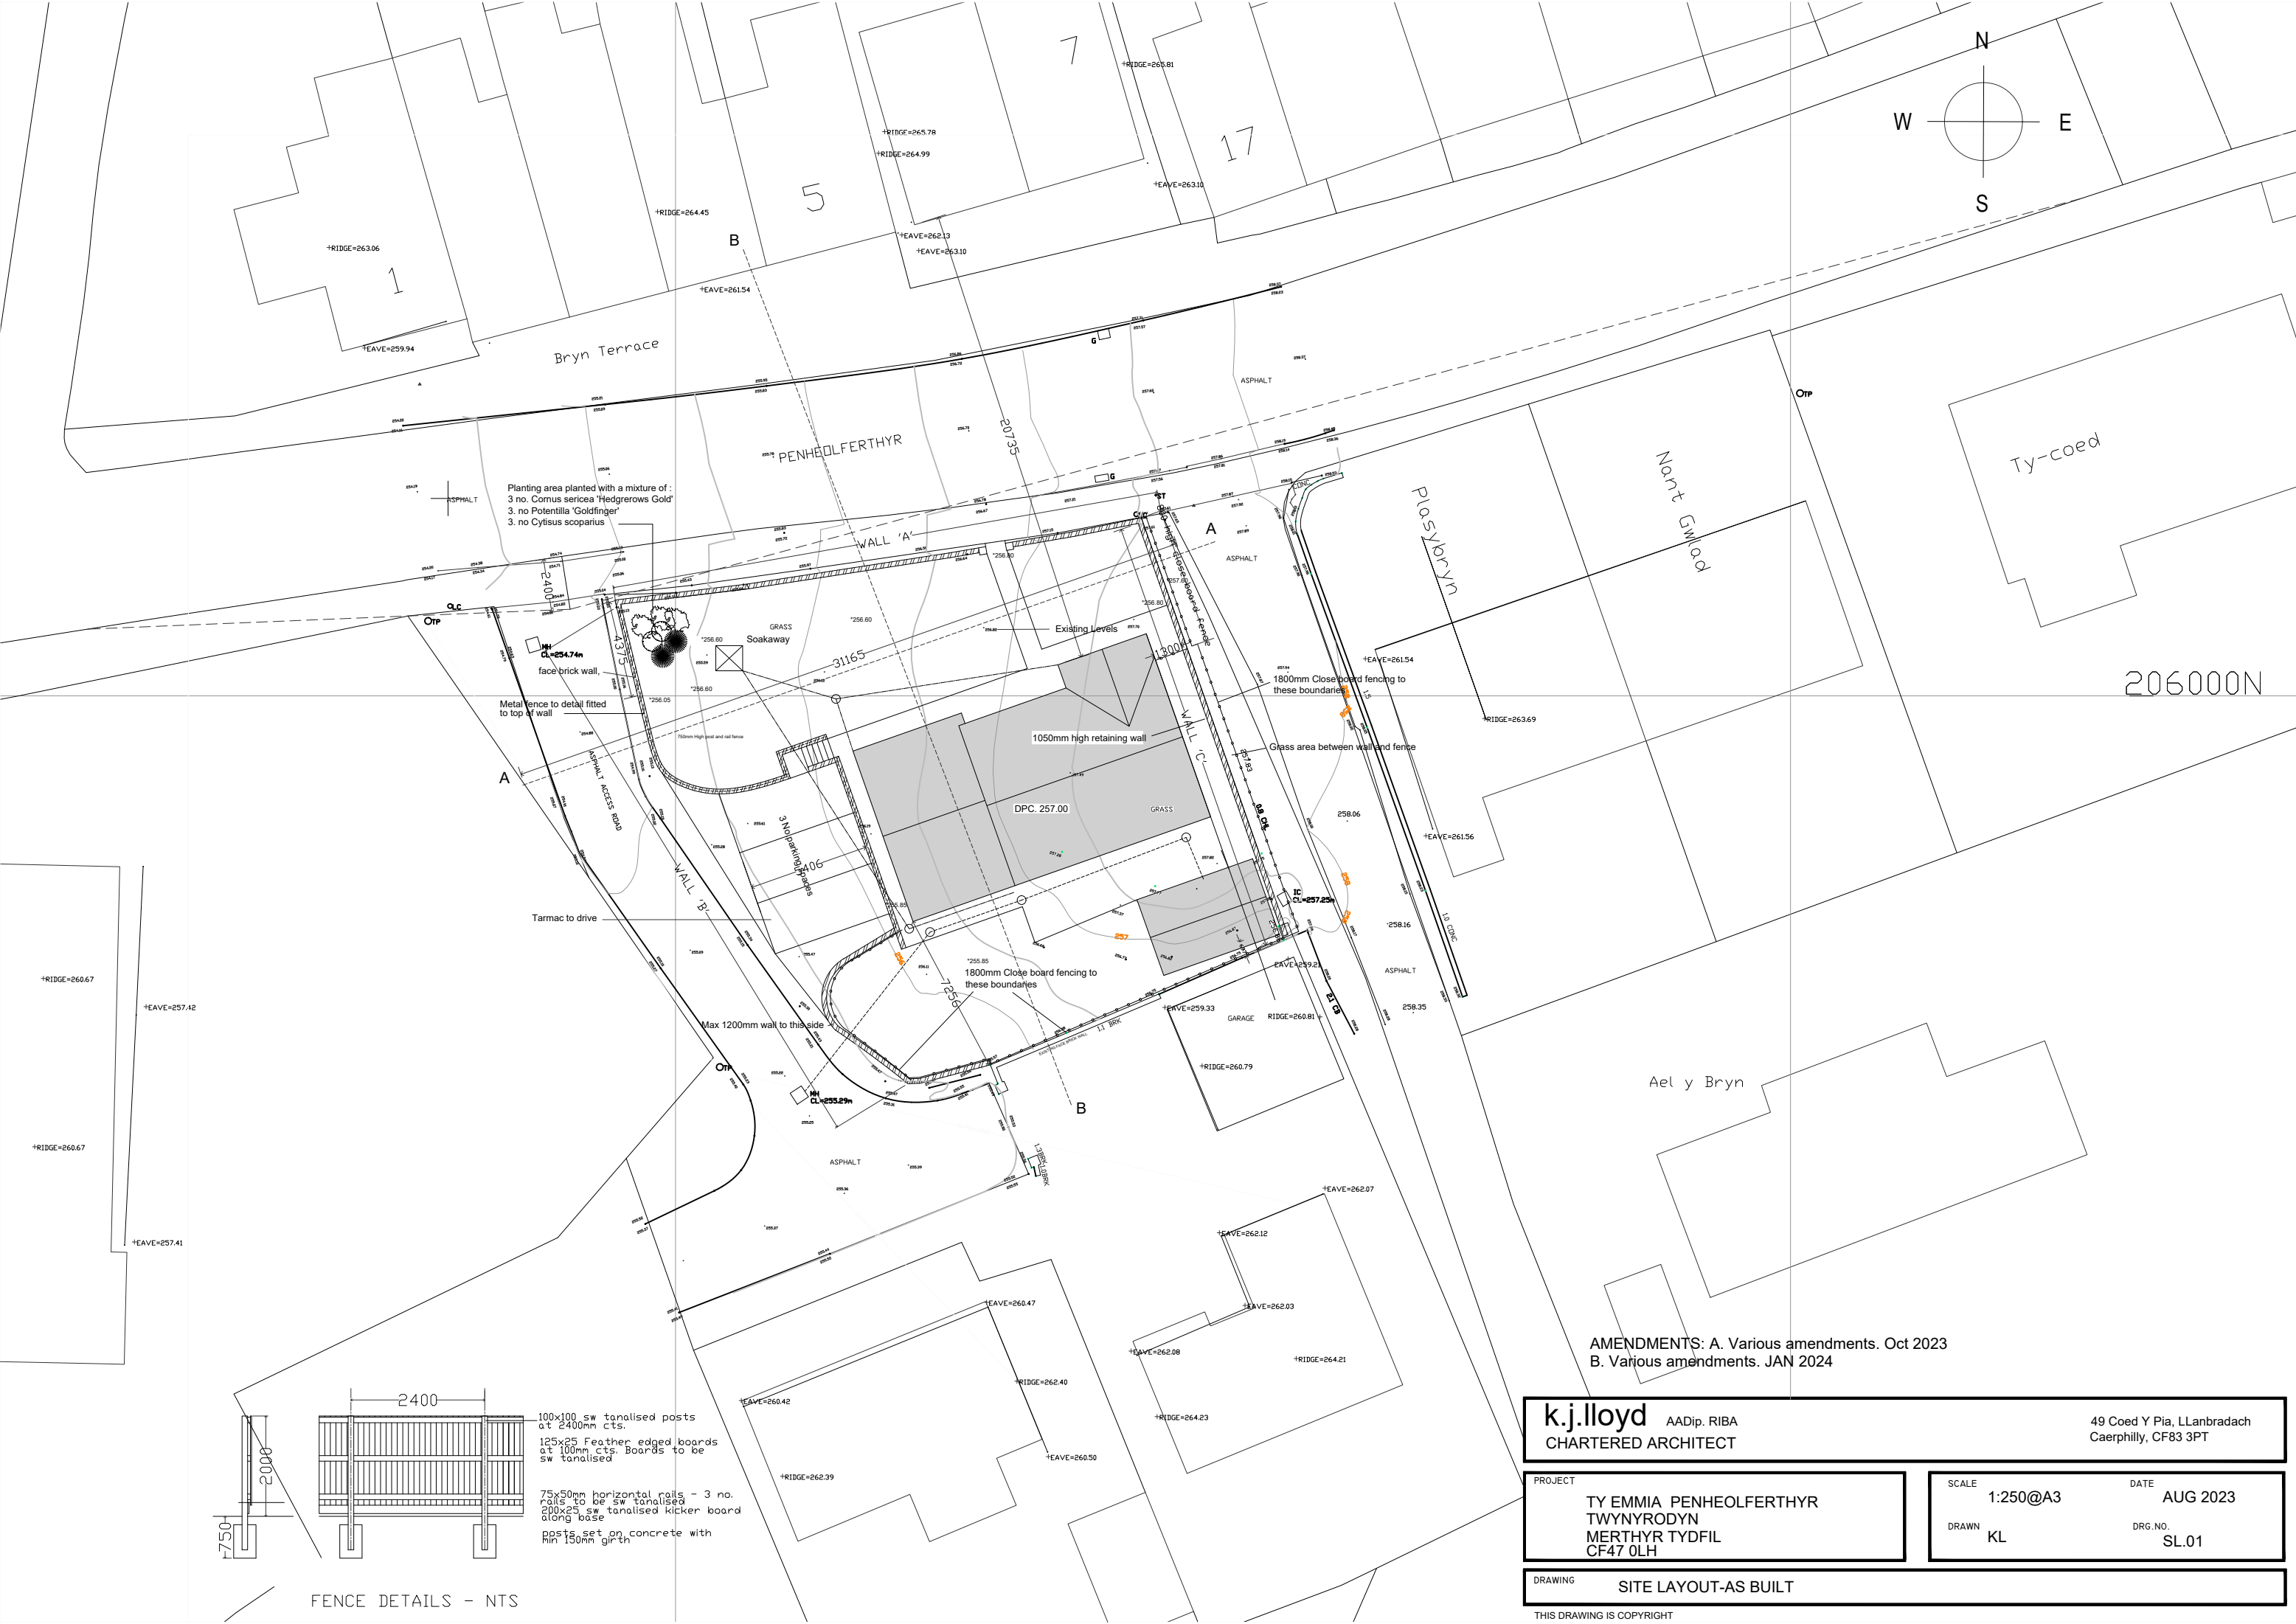


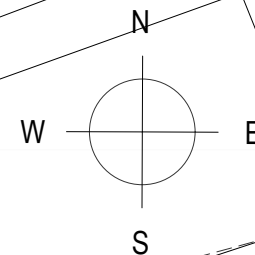

Planting area planted with a mixture of :
3 no. Cornus sericea 'Hedgerows Gold'
3. no. Potentilla 'Goldfinger'
3. no. Cytisus scoparius

face brick wall,
Metal fence to detail fitted to top of wall

Existing Levels

1050mm high retaining wall

DPC. 257.00


1800mm Close board fencing to these boundaries

1800mm Close board fencing to these boundaries

Glass area between wall and fence

Tarmac to drive

Max 1200mm wall to this side

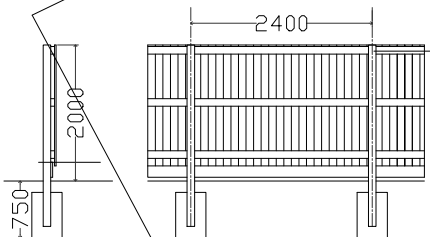

100x100 sw tanalised posts
at 2400mm cts.
125x25 Feather edged boards
at 100mm cts. Boards to be
sw tanalised
75x50mm horizontal rails - 3 no.
rails to be sw tanalised
200x25 sw tanalised kicker board
along base
posts set on concrete with
min 150mm girth

FENCE DETAILS - NTS

AMENDMENTS: A. Various amendments. Oct 2023
B. Various amendments. JAN 2024

k.j.lloyd AADip. RIBA
CHARTERED ARCHITECT

49 Coed Y Pia, LLanbradach
Caerphilly, CF83 3PT

PROJECT
TY EMMIA PENHEOLFERTHYR
TWYNYRODYN
MERTHYR TYDFIL
CF47 0LH

SCALE
1:250@A3
DATE
AUG 2023
DRAWN
KL
DRG. NO.
SL.01

DRAWING
SITE LAYOUT-AS BUILT

THIS DRAWING IS COPYRIGHT