




C6	29/11/2024	Updated architects layout to reflect as-built information	TP	SAD
C7	15/11/2024	As-built issue	TP	SAD
C8	15/10/2024	Site enter and high level overflow added	TP	SAD
C9	15/08/2024	Minor amendments to bin store locations	TP	SAD
C4	14/08/2024	Land reviews around new lay-bys/store locations	TP	SAD
C2	25/07/2024	Wasthole PIS amended, F4c added	TP	SAD
C3	25/06/2024	Fire alarms amended as per PP Builders mark-up	TP	SAD
C1	31/01/2024	Levels to turning head off road 1 amended	TP	SAD
	08/01/2024	Offsite fuel amended	TP	SAD
	02/01/2024	SW drainage amended to provide offsite storage	TP	SAD
REV	DATE	DETAILS	BY	CHK



**Merthyr
Housing
Group**
Local Council

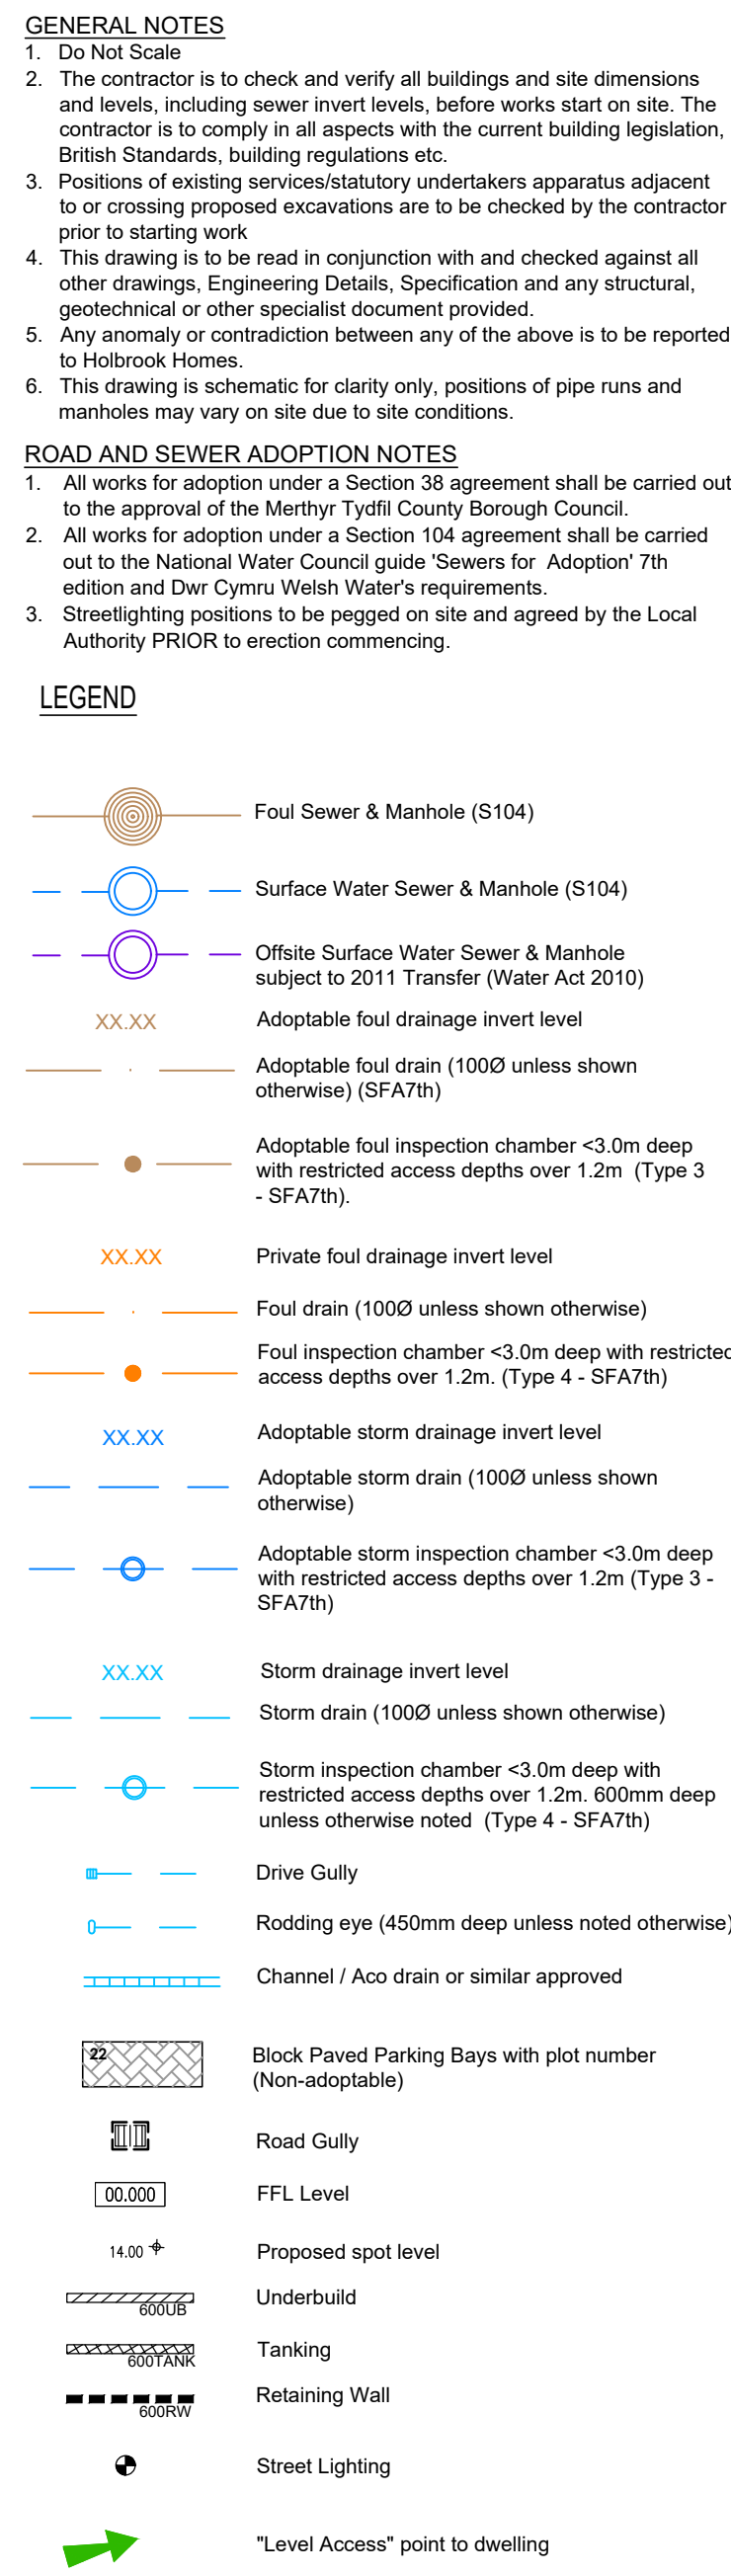

**Tai
Merthyr**
Local Council

**CONSULTING
ENGINEERS**

PHO CONSULTING LTD
107 COMMERTON ROAD
CARDIFF - CF11 8AG
T : +44(0)20 250 2020
E : enquiries@phoconsulting.com
W : www.phoconsulting.co.uk
 [@pho_consulting](https://twitter.com/pho_consulting)
 www.linkedin.com/company/pho-consulting-engineers



PROJECT:

Merthyr Housing
Bryniau Road,
Park, Merthyr Tydfil

WORKING TITLE:

Engineering Layout

DRAWING	C/SW	STATUS	SCALE
TP	JWD	As-built	1:250 @A0
DATE:	REV:	ENCL. NOS:	CR:
Nov/2017	1982	100	8/8