



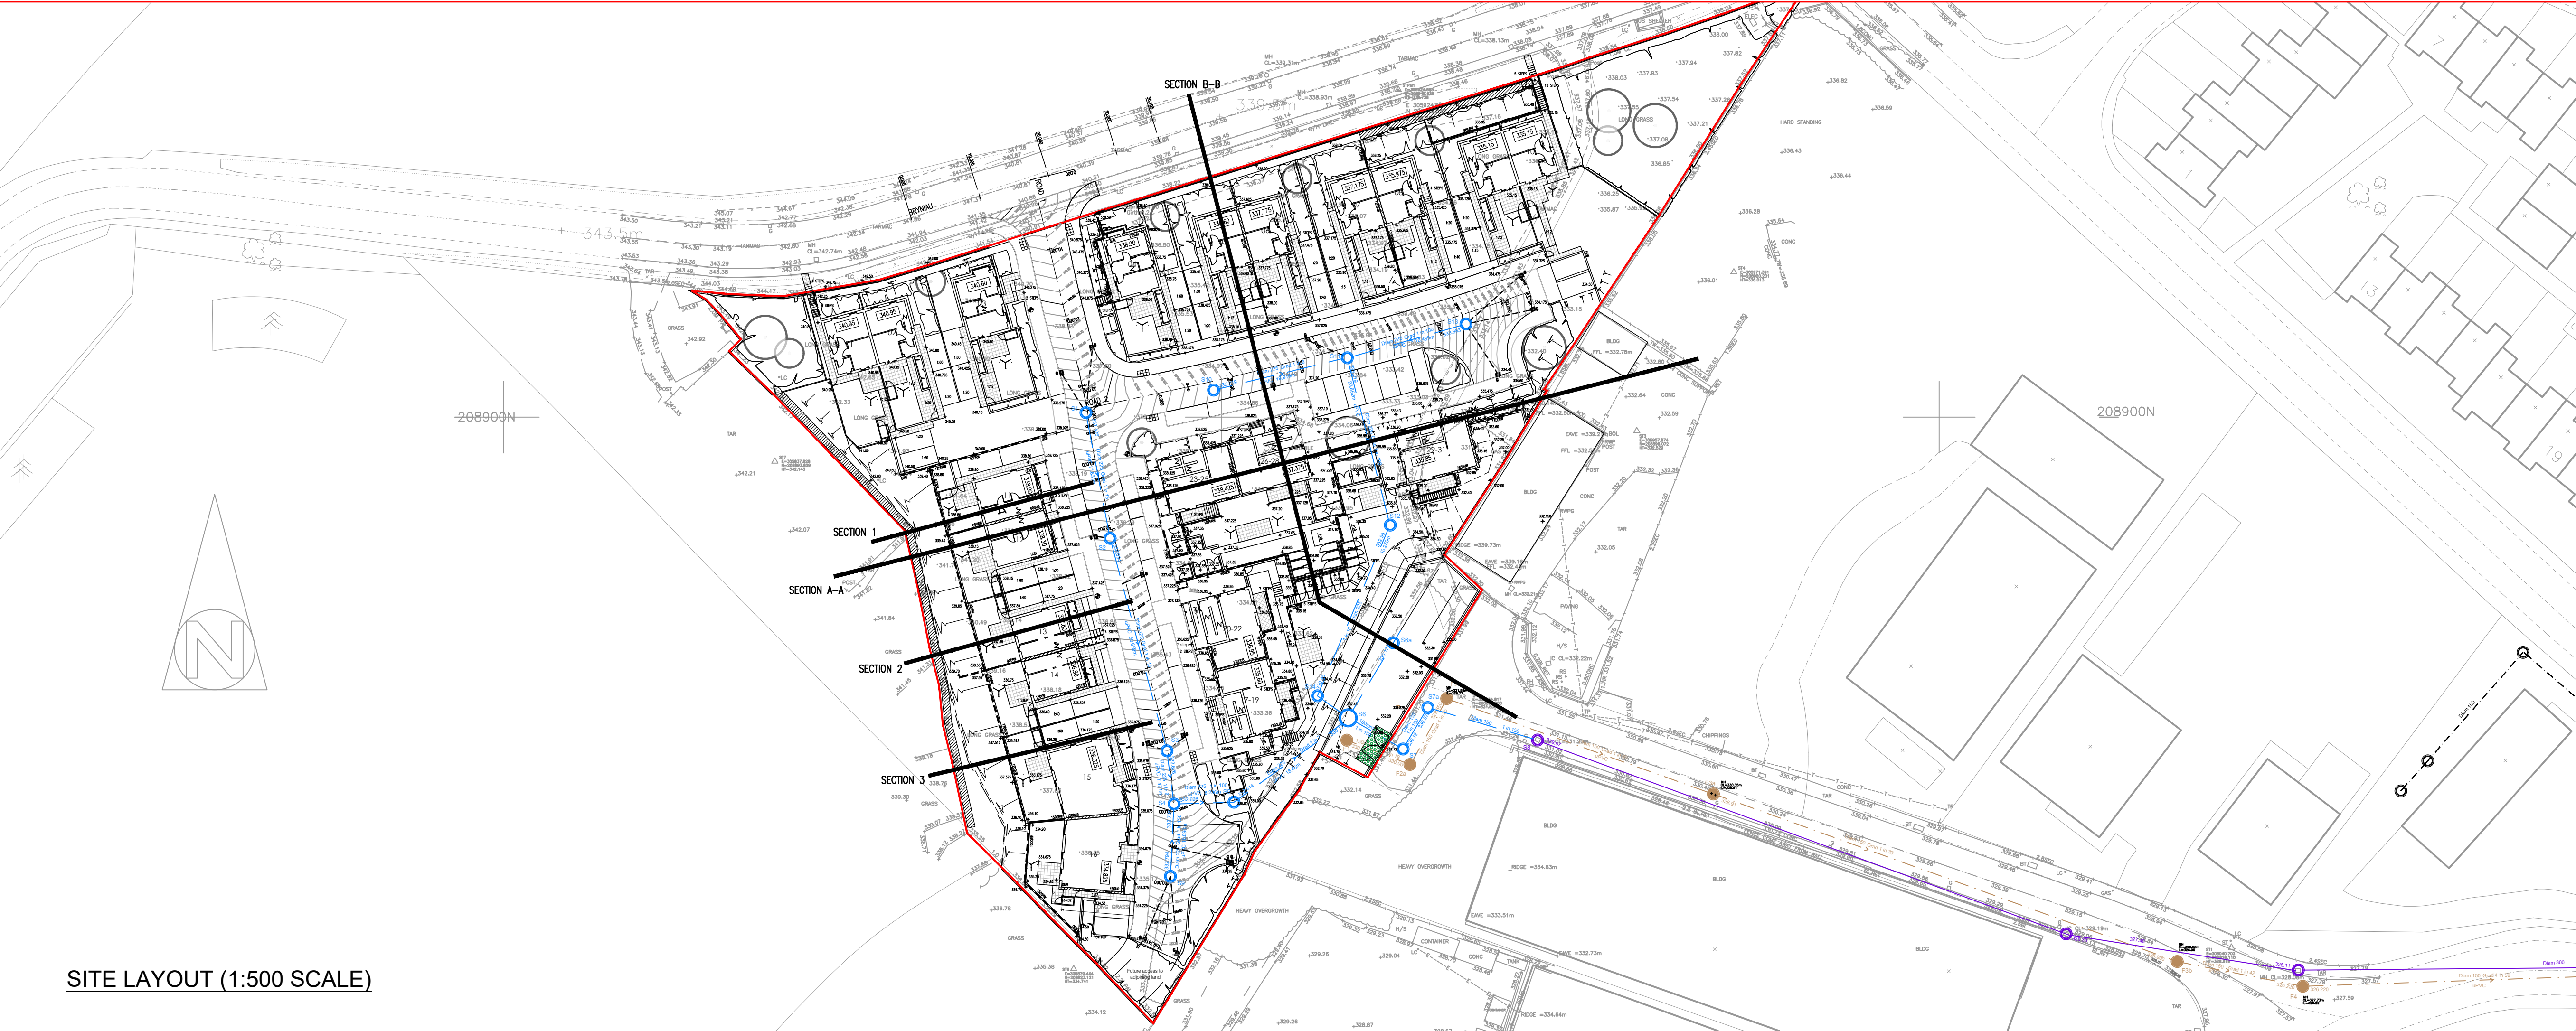

SITE LAYOUT (1:500 SCALE)

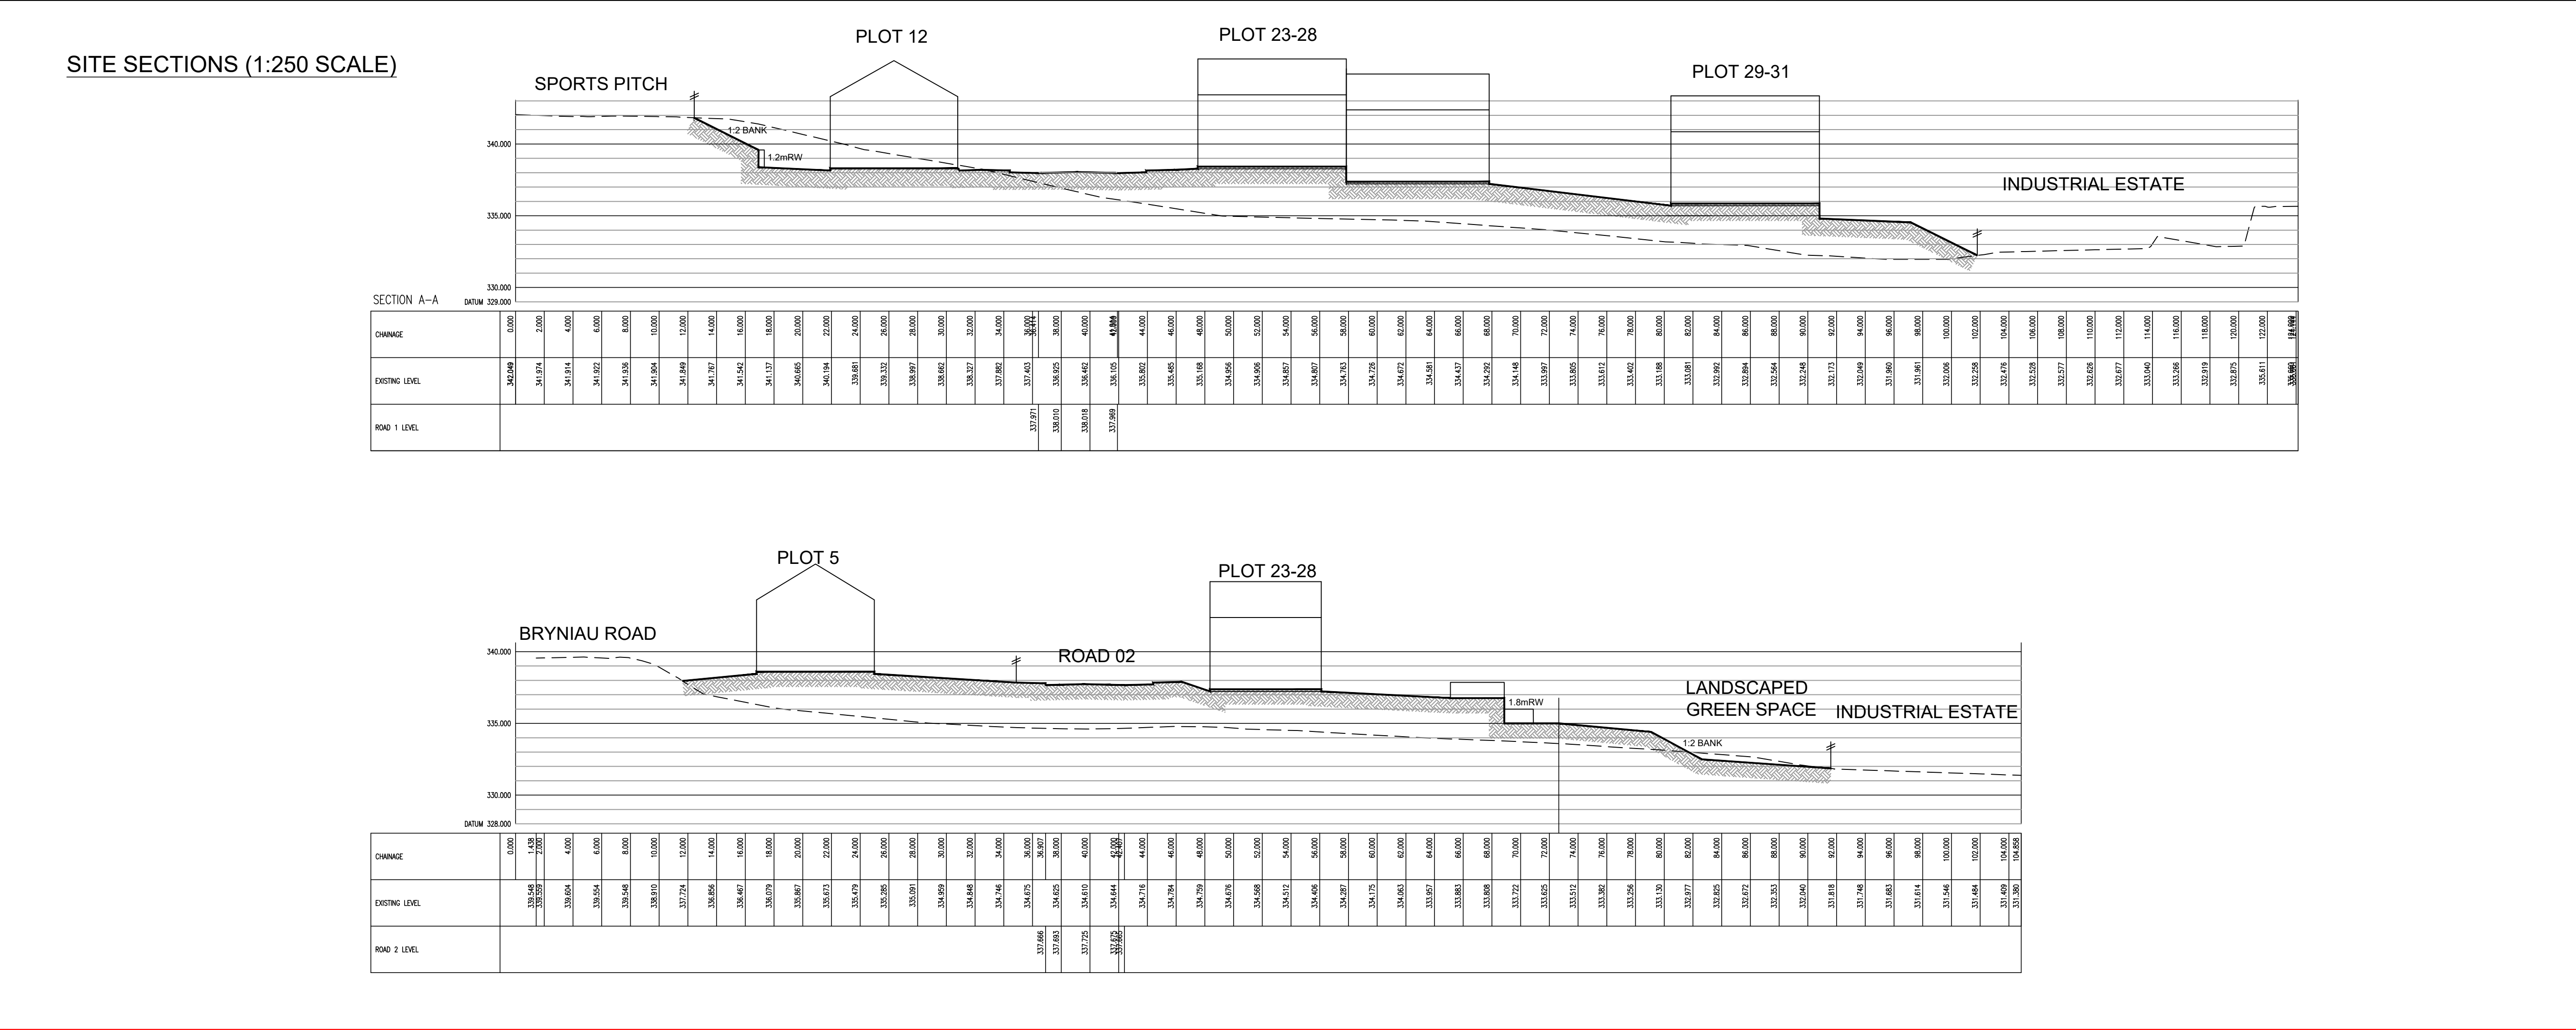

SITE SECTIONS (1:250 SCALE)

- GENERAL NOTES
1. Do Not Scale
 2. The contractor is to check and verify all buildings and site dimensions and levels, including sewer invert levels, before works start on site. The contractor is to comply in all aspects with the current building legislation, British Standards, building regulations etc.
 3. Positions of existing services/statutory undertakers apparatus adjacent to or crossing proposed excavations are to be checked by the contractor prior to starting work
 4. This drawing is to be read in conjunction with and checked against all other drawings, Engineering Details, Specification and any structural, geotechnical or other specialist document provided.
 5. Any anomaly or contradiction between any of the above is to be reported to Holbrook Homes.
 6. This drawing is schematic for clarity only, positions of pipe runs and manholes may vary on site due to site conditions.

C	04/12/2024	As-built	TP	SJD
B	20/07/2022	Client details amended	TP	SJD
A	27/07/21	Sections Amended	TP	SD

REV	DATE	DETAILS	AMENDMENTS	BY	CHK

CLIENT:

Merthyr Housing
Where People Come First

Tai Merthyr
Live Down Road
Get Central

phg CONSULTING ENGINEERS
PHG CONSULTING LTD
107 COVERIDGE RD EAST
CARDIFF CF11 9AG
T : +44(0)29 2030 2521
E : enquiries@phg-consulting.co.uk
W : www.phg-consulting.co.uk
@PHG Consulting
www.linkedin.com/company/phg-consulting-engineers

PROJECT:

**Merthyr Housing
Bryniau Road,
Pant, Merthyr Tydfil**

DRAWING TITLE:

**Site Sections
Sheet 1**

DRAWN:	CHK:	STATUS:	SCALE:
SJD	PHG	Construction	As Shown

DATE:	JOB NO.	DWG. NO.	REV.
Jan'2020	1982	101	C