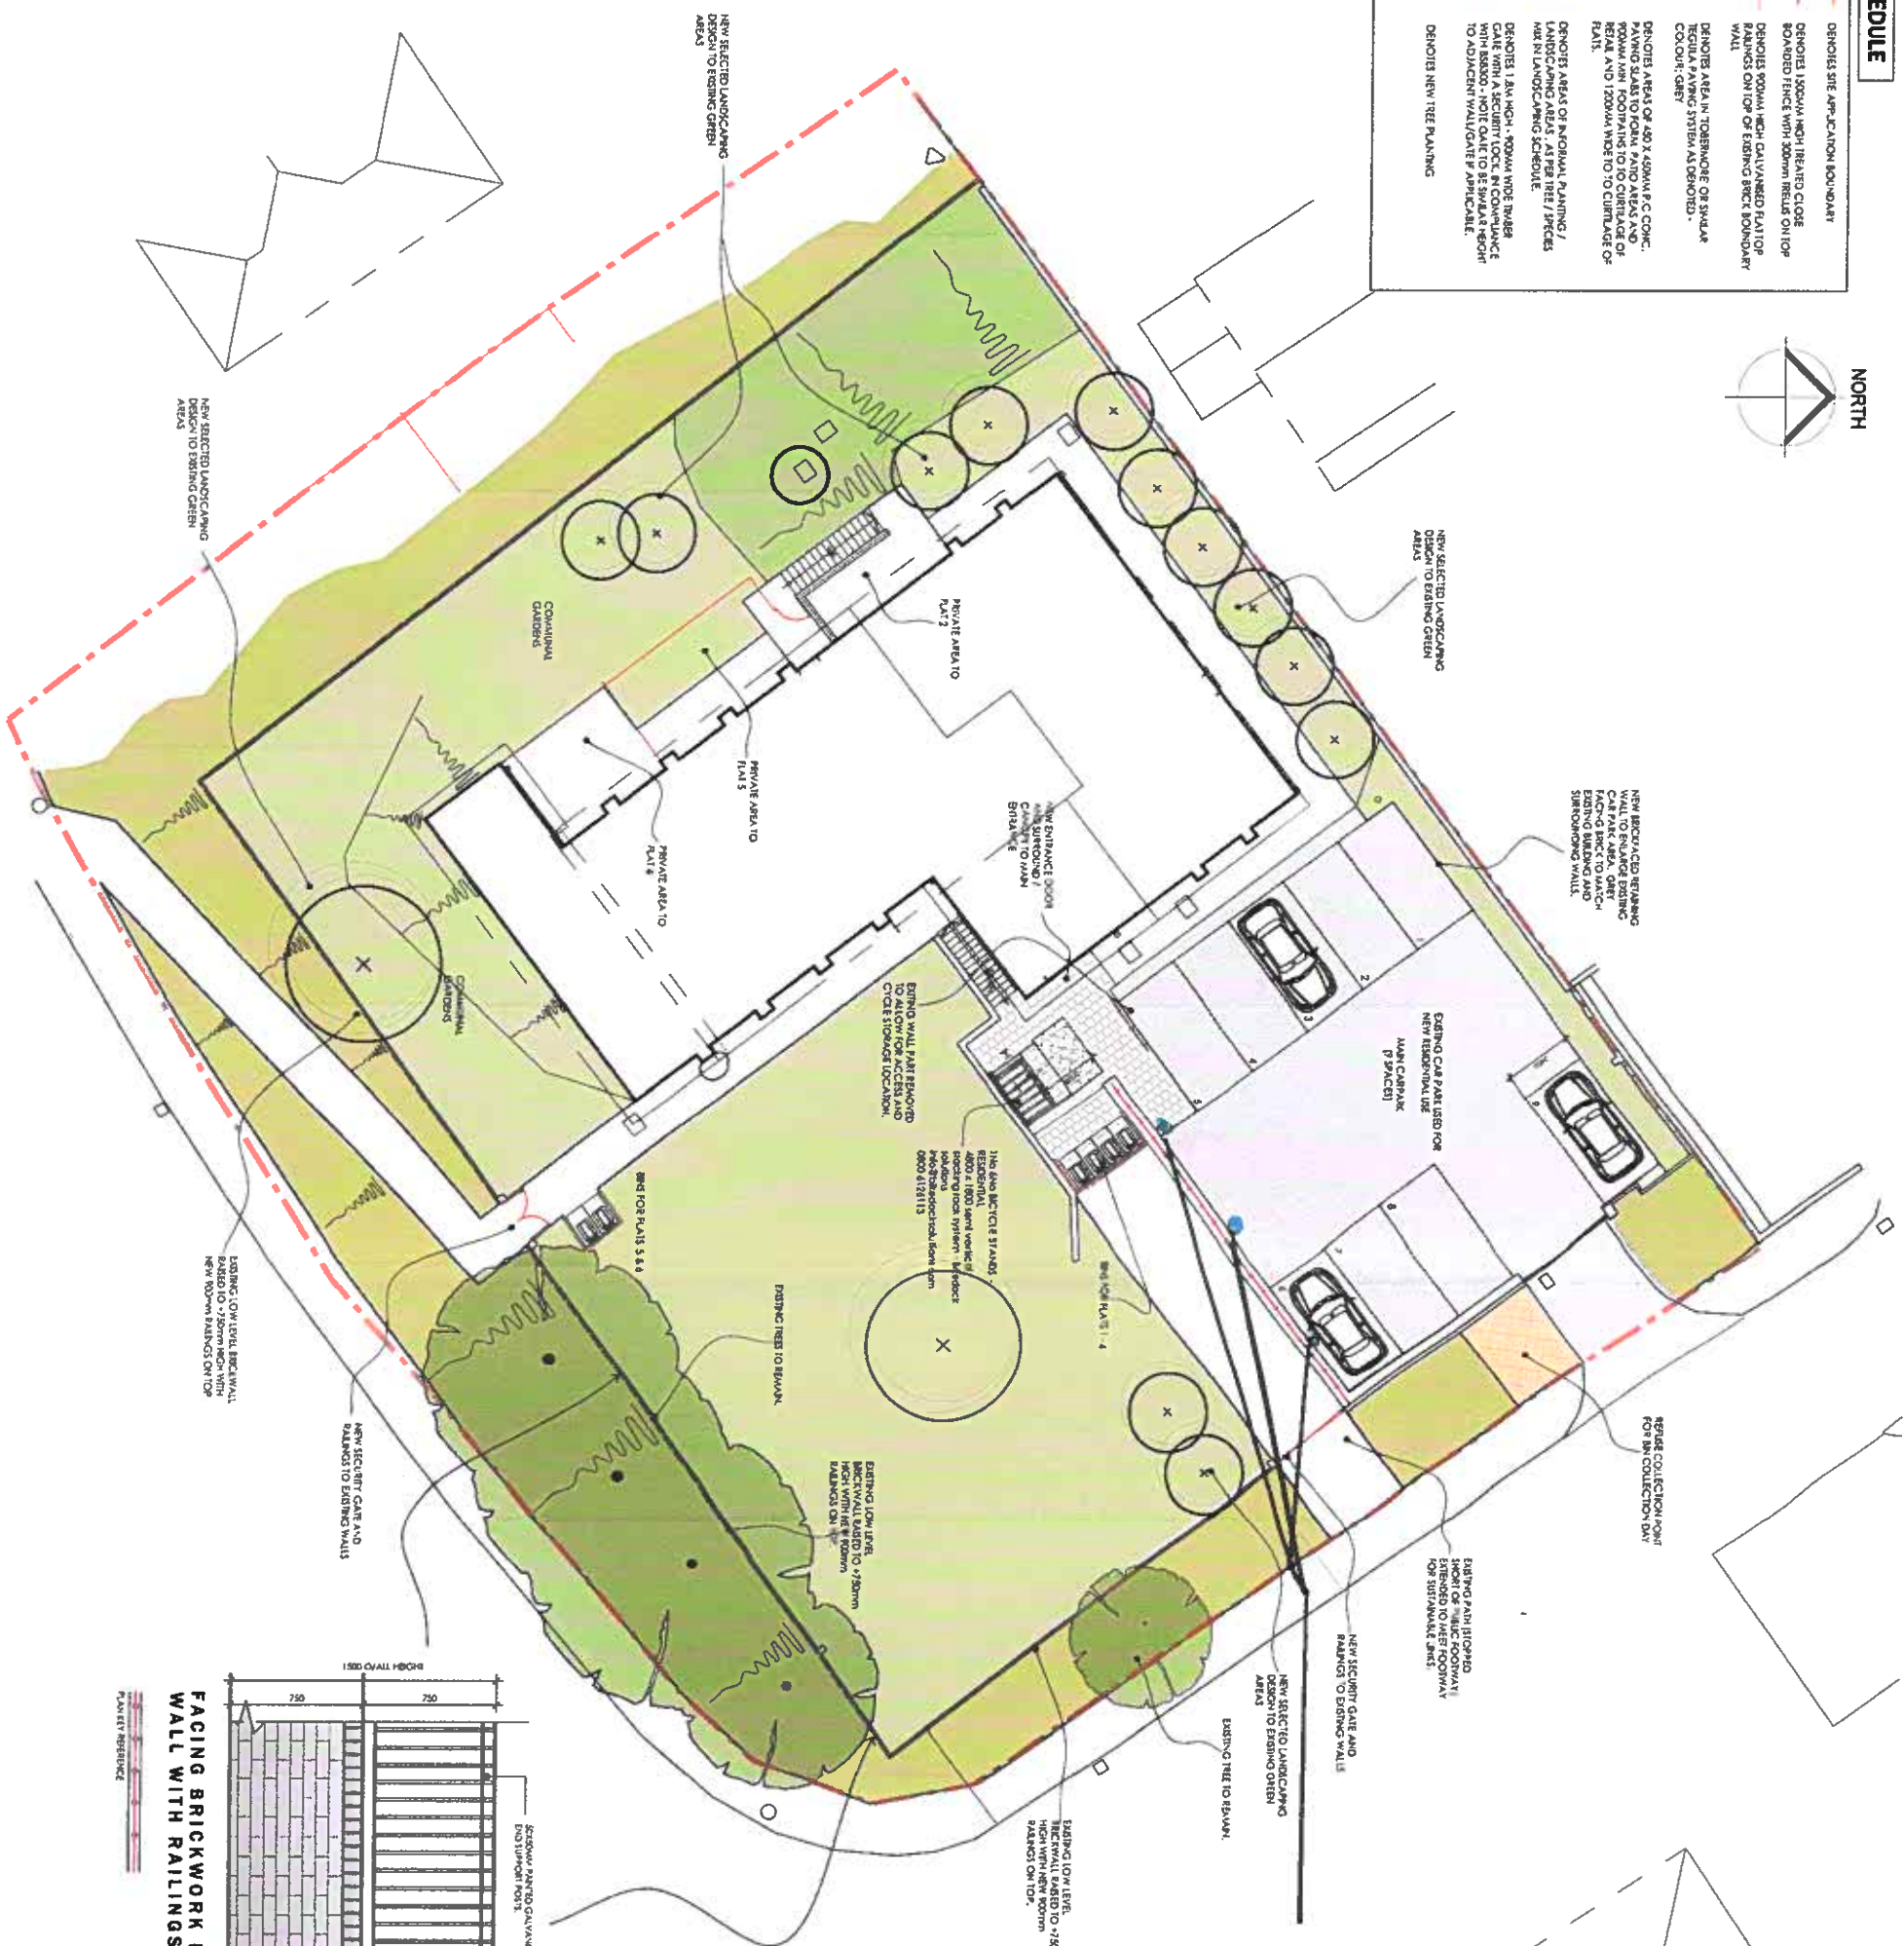
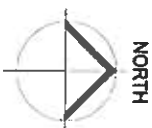


[illegible]

External lighting

BRICK BOUNDARY WALL

750

750

2500MM HIGHT GALVANIZED TOP RAILING POST

125MM HIGHT GALVANIZED TOP RAILING SUPPORT RAIL

125MM HIGHT GALVANIZED TOP RAILING SPACER RAIL

GROUND LEVEL

LETTER H AND B ARE NOT VALID TO AROUND OF 150MM FROM EXTERNAL GROUND LEVEL. ALL BRICKWORK TO MATCH DRAWING

Client	Drawing No	Scale	Revision
Alex	LT2116.04.03	1:125 @A1	G
Job Title	Drawing Title	Date	Checked
Wesley Chapel, Dowlais	Proposed Site Plan	Oct 21	KML

REV. A. APR. 22
MINOR CHANGES AND BR AND BIRL STORE DETAILS ADDED TO
SUIT PRE-PLANNING APPLICATION COMMENTS

REV. B. JULY 22
WALL AND BOLLARD LIGHTING DETAILS ADDED

REV. C. SEPT. 22
BOLLARD LIGHTING REVERED AND WALL LIGHTING OMITTED.

REV D NOV 22
EXTERNAL WORK REVISIONS TO ALLOW FOR
INCREASED CAR PARKING NUMBERS, BURN SHORE AND
CYCLE STORE RELOCATED TO SURF.

REV E OCT 23
SETTING OUT DIMS ADDED TO CAR PARKING.

REV F JUNE 24
LAYOUT UPDATED TO SUIT AS BUILT

REV. 6 AUG 24
FURTHER REVISIONS TO SUIT AS BUILT
SITUATION.

Do not scale from this drawing.
The users of this drawing shall check all
dimensions & report all errors and
omissions to LeTrucce Design.

This drawing is copyright. It must not be copied, used or disclosed to third parties without prior permission of LeTucop Design.