




01 SITE SECTION A-A
1 : 200

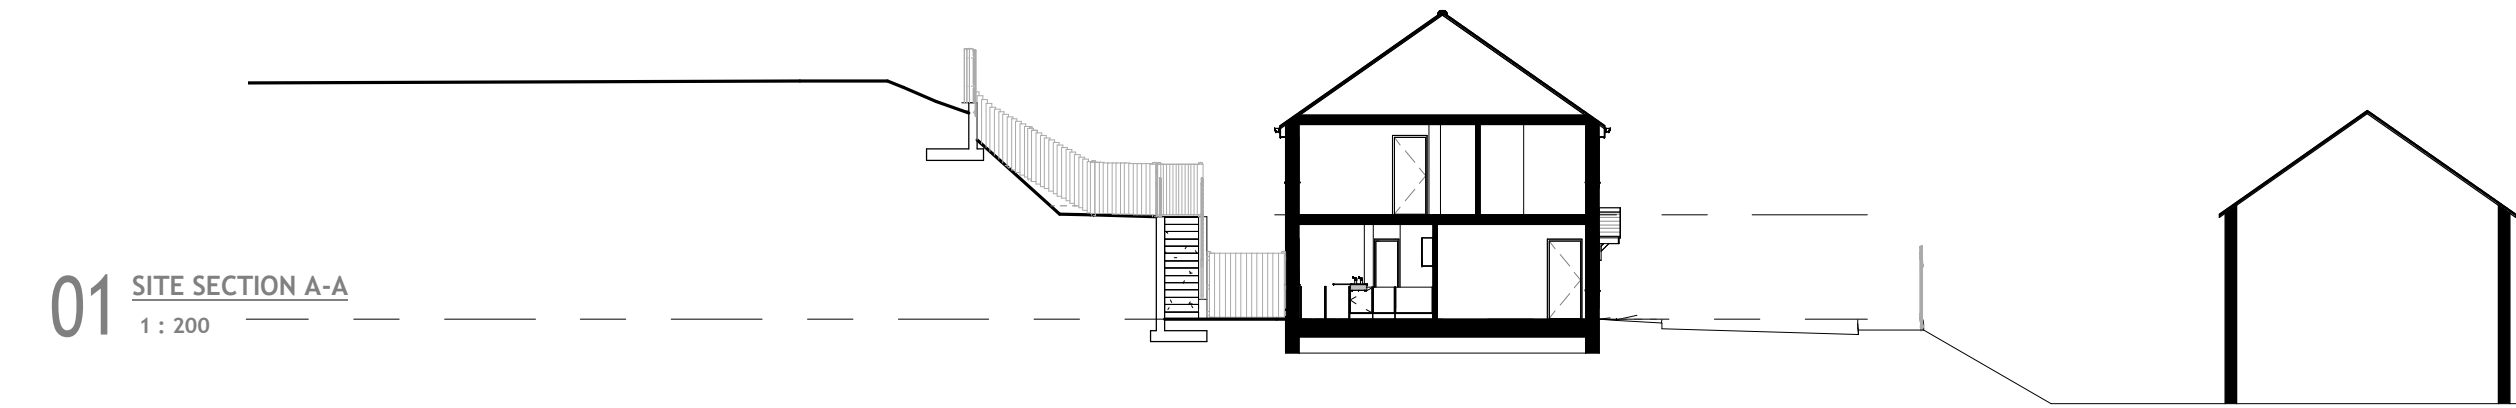

02 SITE SECTION B-B
1 : 200

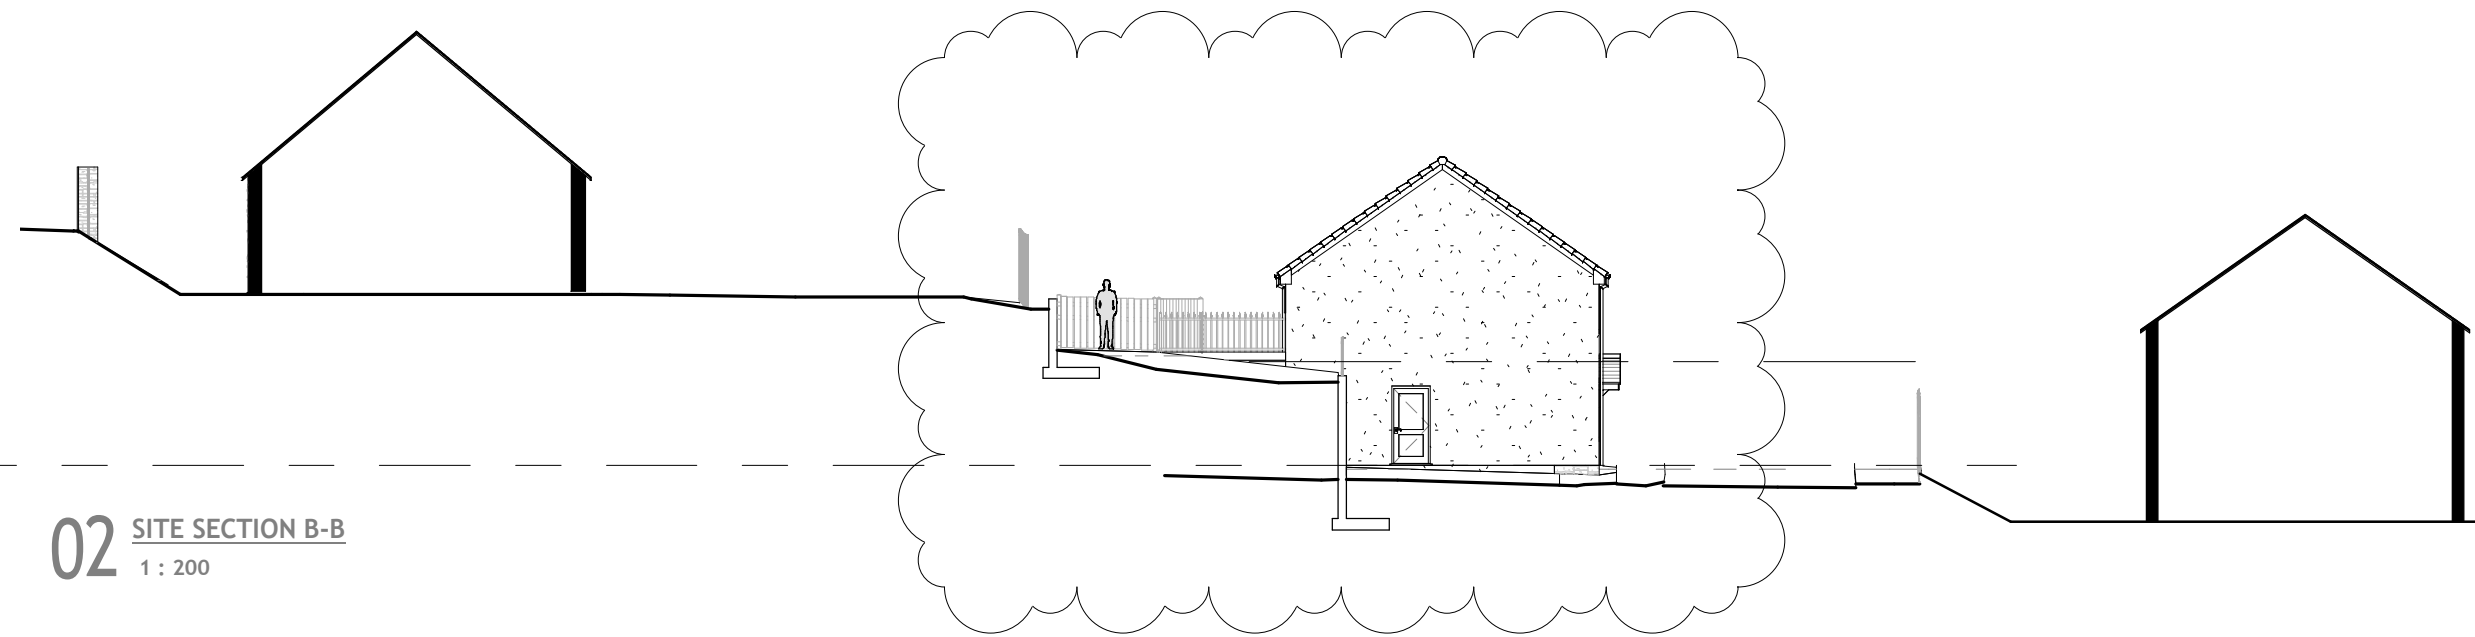

03 SITE SECTION C-C
1 : 200

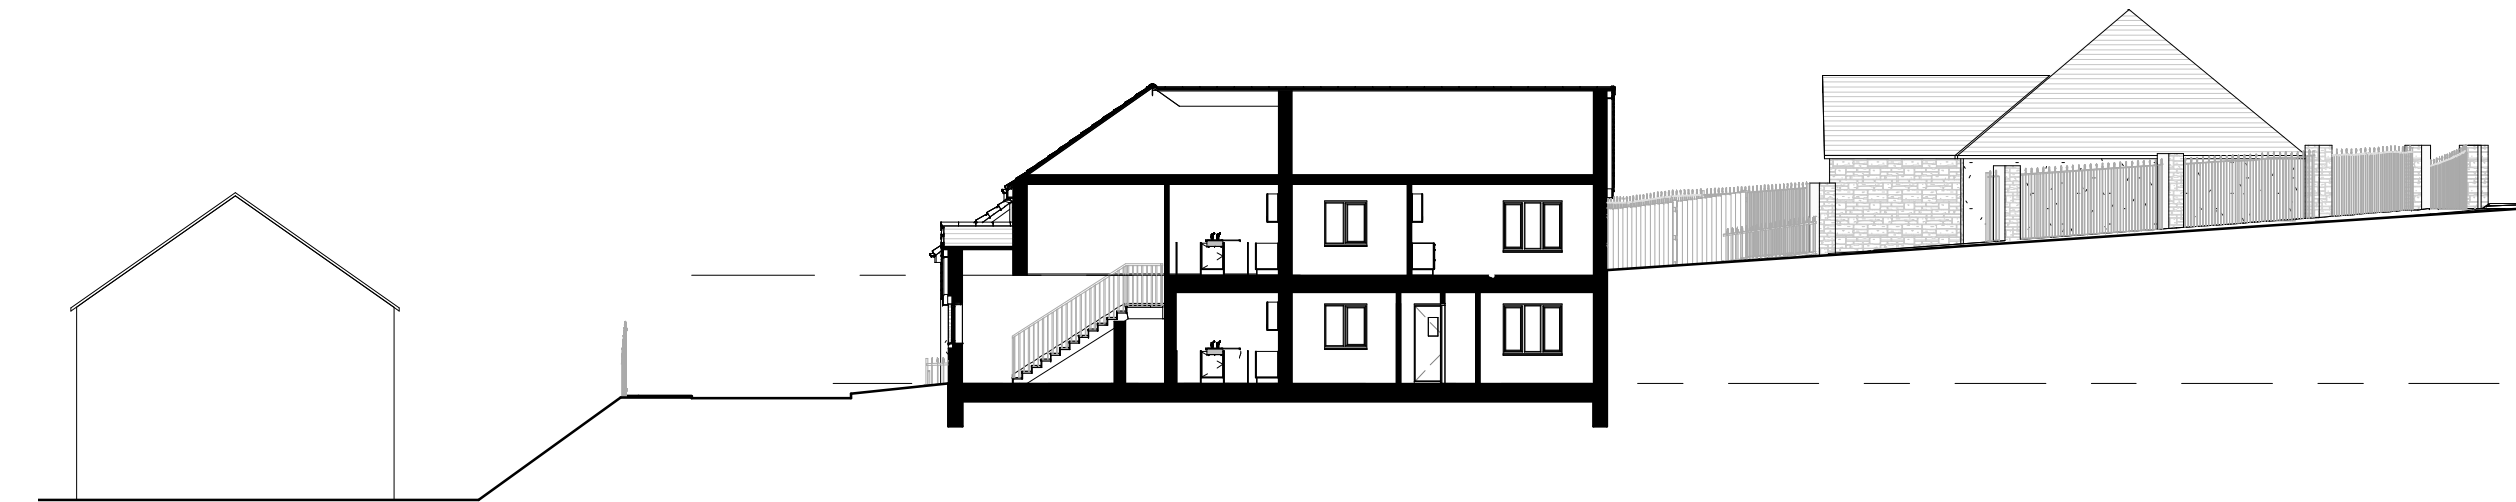

Copyright © 2018

Notes:
Do not scale this drawing. Check all dimensions on site. Any discrepancies to be reported back to the Architect for clarity.

F	Plots 3 & 4 re-positioned approx 850mm, to accommodate to drainage	PC	20.11.19
E	East Street footpath reduced to 1.2m wide	PC	04.03.19
D	2no. bungalows omitted, redline boundary amended	PC	21.01.19
C	Parking to 2 Bed houses reduced to 1 space, plot 11 & 12 repositioned by approx 650mm, wall climbing plant indicated	PC	18.01.19
B	Plot 1 upper garden enclosure updated to railings, fence to Cancer Aid boundary removed, retaining wall raised slightly	PC	17.12.18
A	Amendments following planning comments	PC	19.11.18
Rev	Revision	By	Date

Client:



Merthyr Housing | **Tai Merthyr**

Project:

EAST STREET, MERTHYR TYDFIL

Job Number:

L781

Date:

01.02.19

Drawn by:

PC

Dwg No:

A124

SITE SECTIONS

Revision:

F

Scale:

1 : 200 @ A3

Drawing Status:

PLANNING



TONY KING ARCHITECTS LTD

97a Glebe Street, Penarth

Vale of Glamorgan CF64 1EE

T: 02920 306400

www.tonykingarchitects.co.uk

20/11/2019 11:43:02