


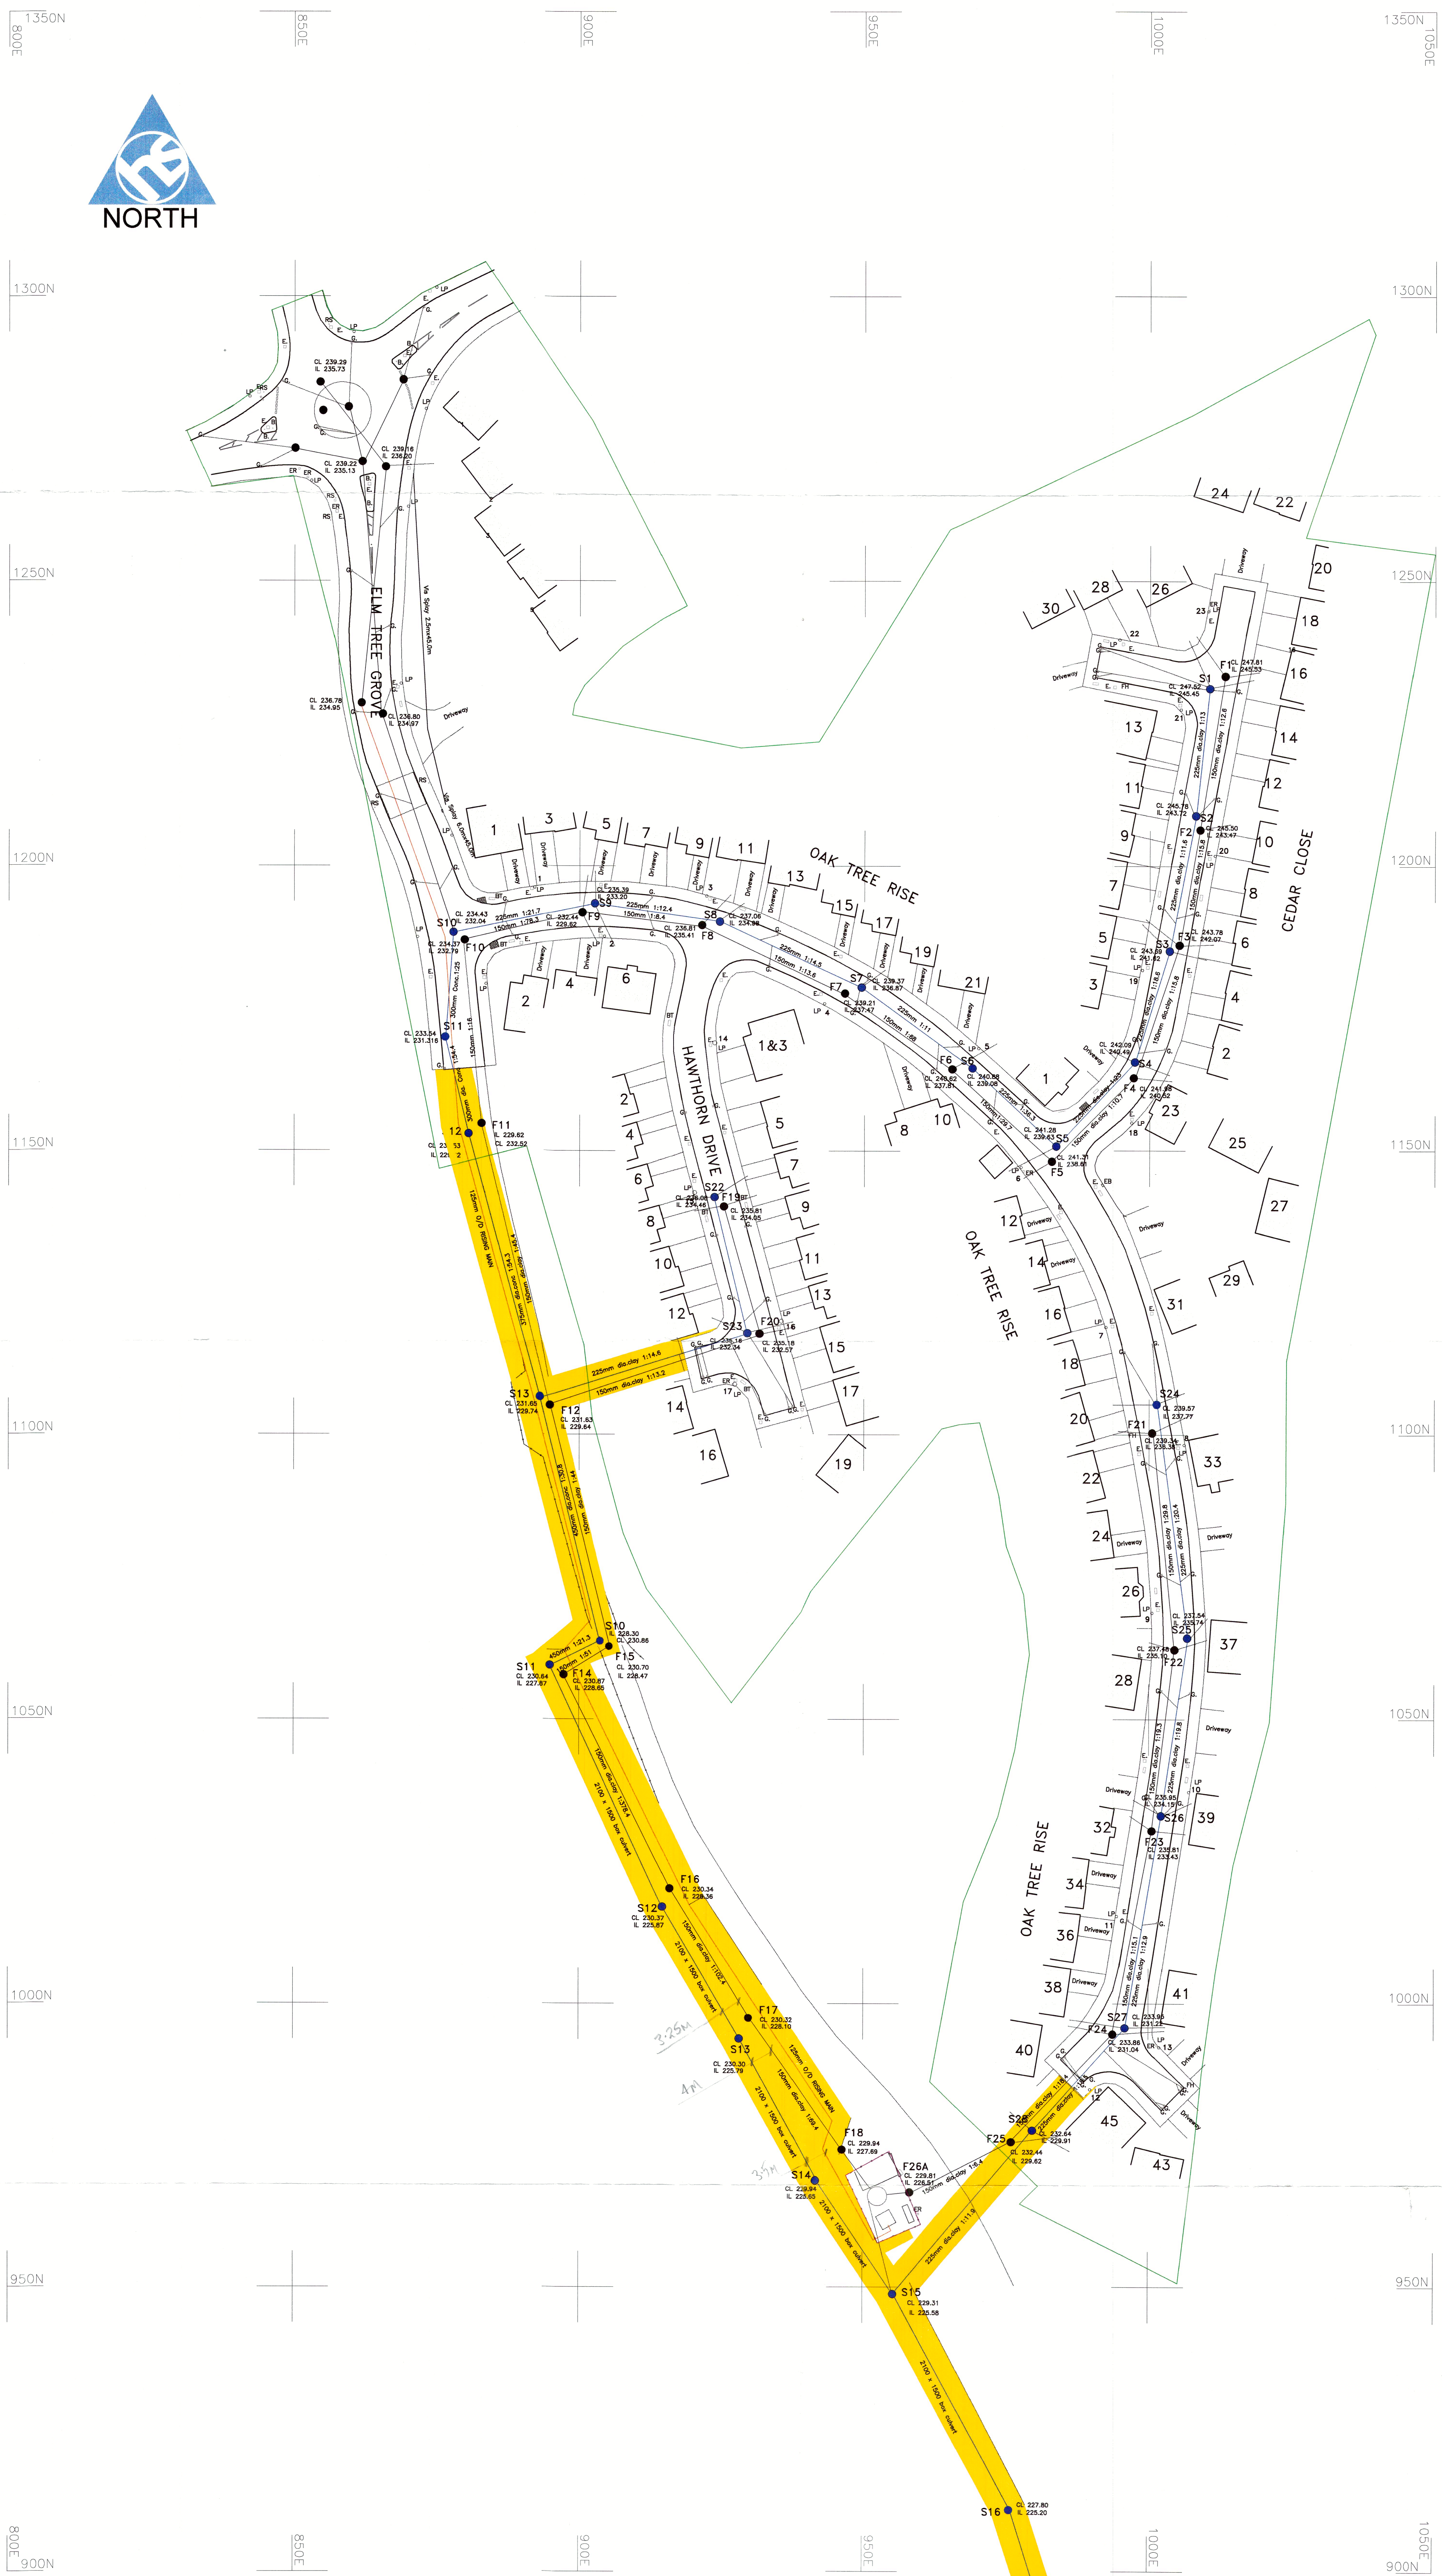

Revisions:

Taylor Wimpey

Title: MOUNTAIN HARE
DAN Y GRAIG
MERTHYR
MERTHYR TYDFIL
S104 As-Built

Dwg No: 13223 / 60 / 01

Scale: 1:500 Date: JAN 2015
Drawn By: TWSW Designed By: RH

Taylor Wimpey Developments Limited
Eastern Business Park, Wern Fawr Lane,
St Mellons, Cardiff. CF3 5EA
Tel:- 02920 534700, Fax:- 02920 534777

17th Dec