


The Grange, Cefn-Coed-y-Cymmer

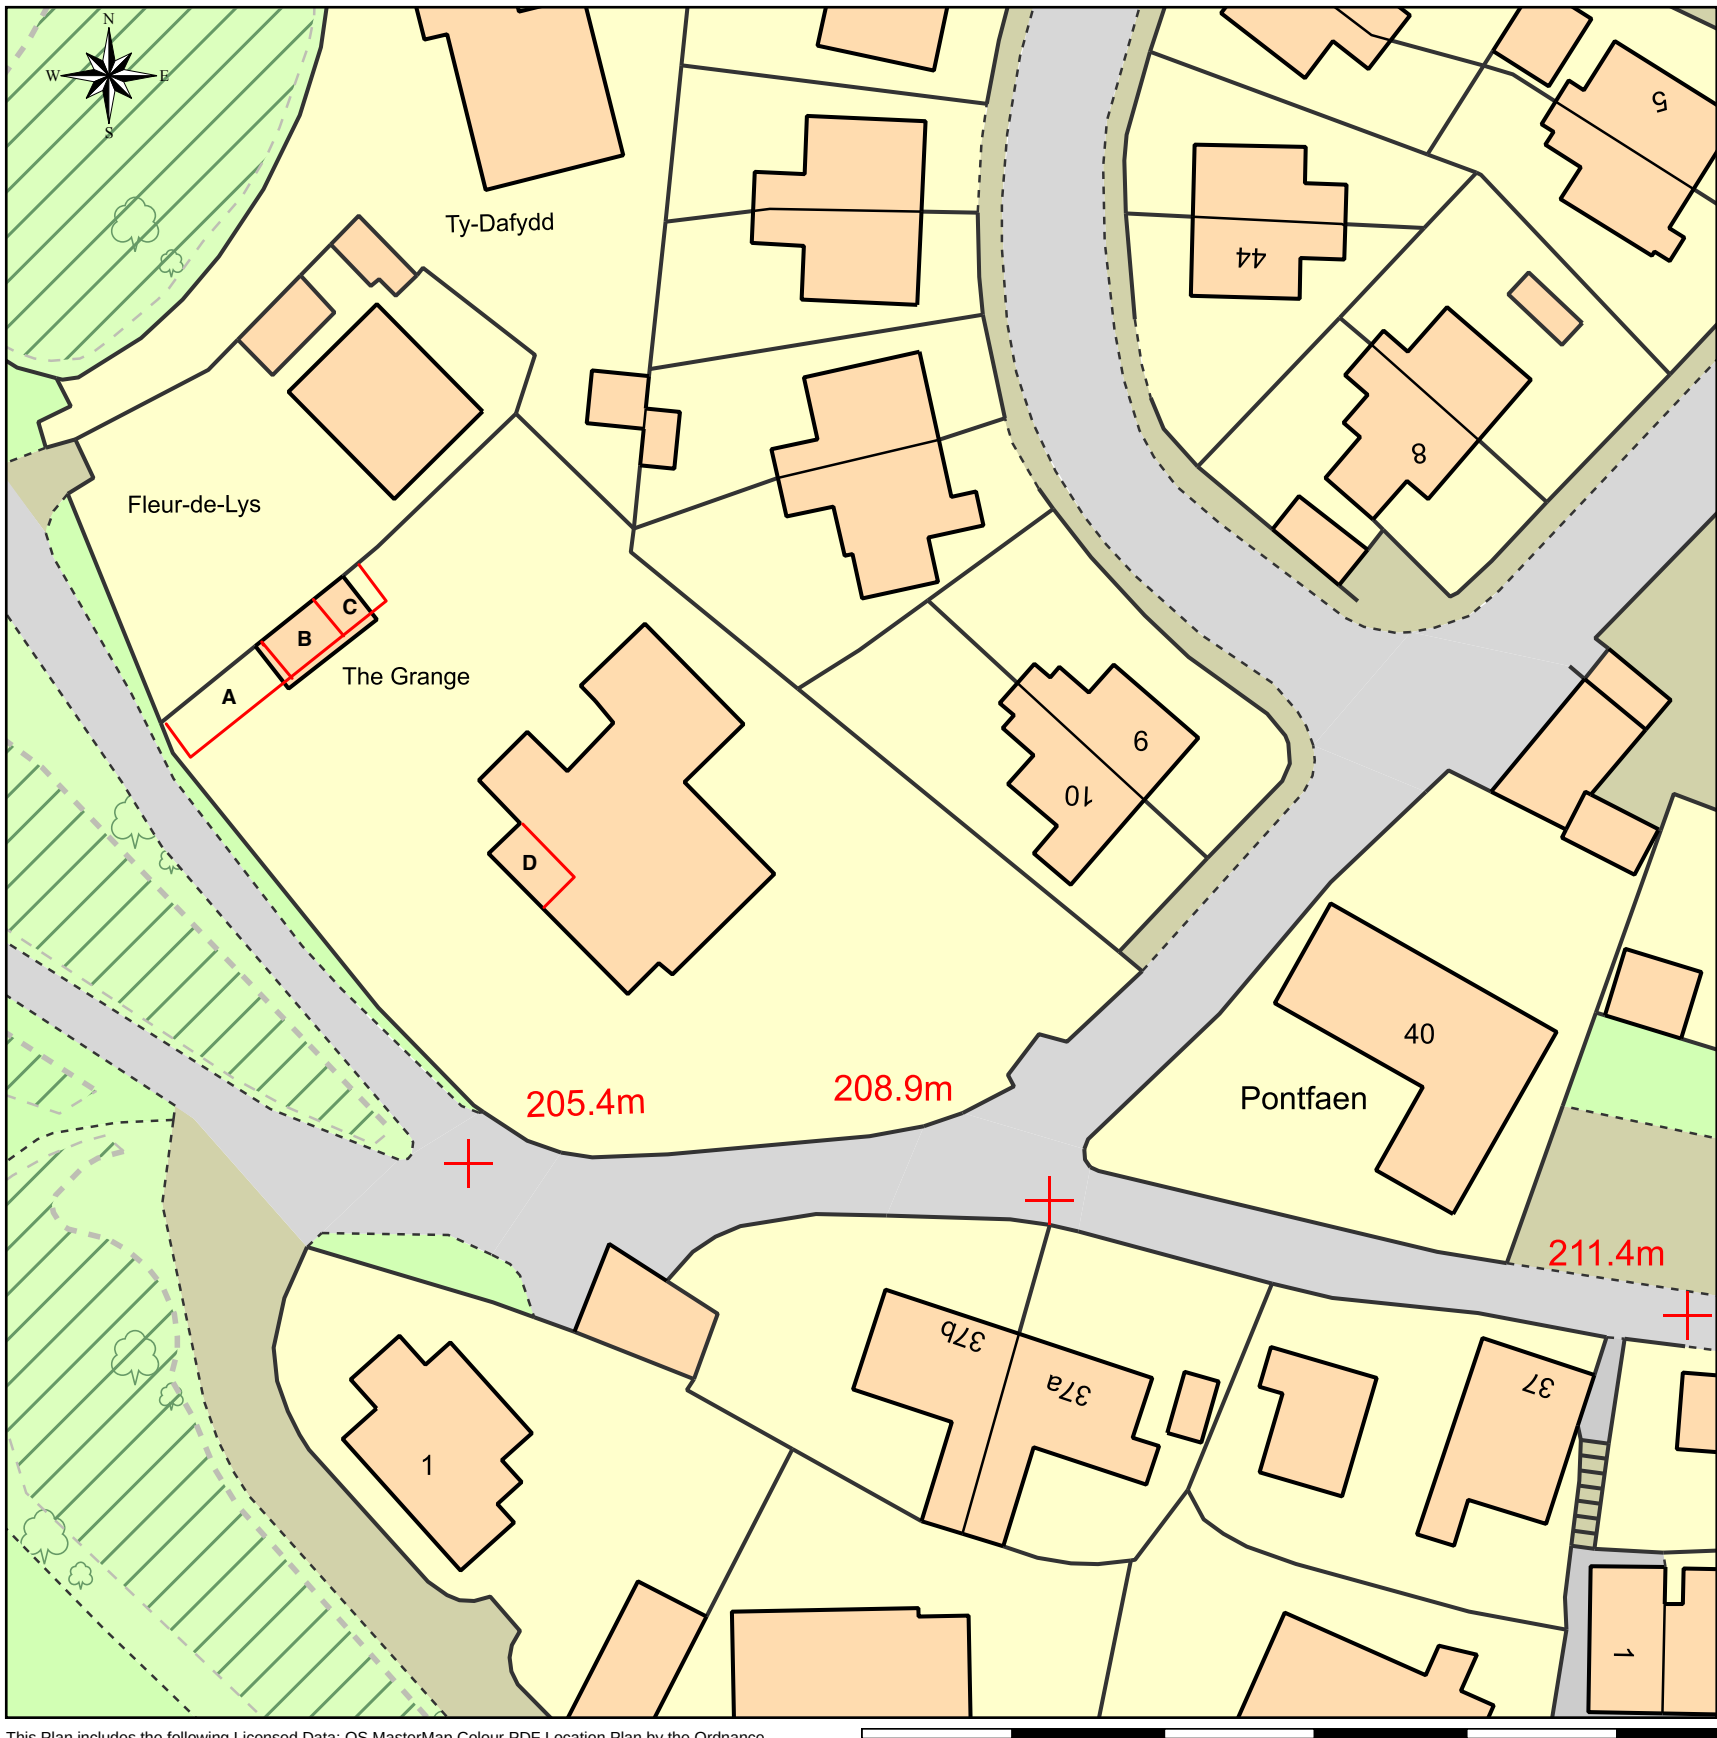

This Plan includes the following Licensed Data: OS MasterMap Colour PDF Location Plan by the Ordnance Survey National Geographic Database and incorporating surveyed revision available at the date of production. Reproduction in whole or in part is prohibited without the prior permission of Ordnance Survey. The representation of a road, track or path is no evidence of a right of way. The representation of features, as lines is no evidence of a property boundary. © Crown copyright and database rights, 2021. Ordnance Survey 0100031673

0m 10m 20m 30m 40m 50m

Scale: 1:500, paper size: A3

PLEASE NOTE: Position of Shed and greenhouse (orange block on northern boundary wall) is incorrectly shown from Ordnance Survey data.
Red lines indicate correct position of existing (and future) structures.

Key & measurements

- A: Gazebo / Deck - 8.5 x 2.95m
- B: Greenhouse - 4.4 x 2.95m
- C: Shed - 3.6 x 2.95m
- D: Balcony - 4.85 x 2.9m

